


UNITED STATES
DEPARTMENT OF THE INTERIOR
GEOLOGICAL SURVEY

SLICKVILLE QUADRANGLE
PENNSYLVANIA—WESTMORELAND CO.
7.5 MINUTE SERIES (TOPOGRAPHIC)
NE/4 GREENSBURG 15 QUADRANGLE

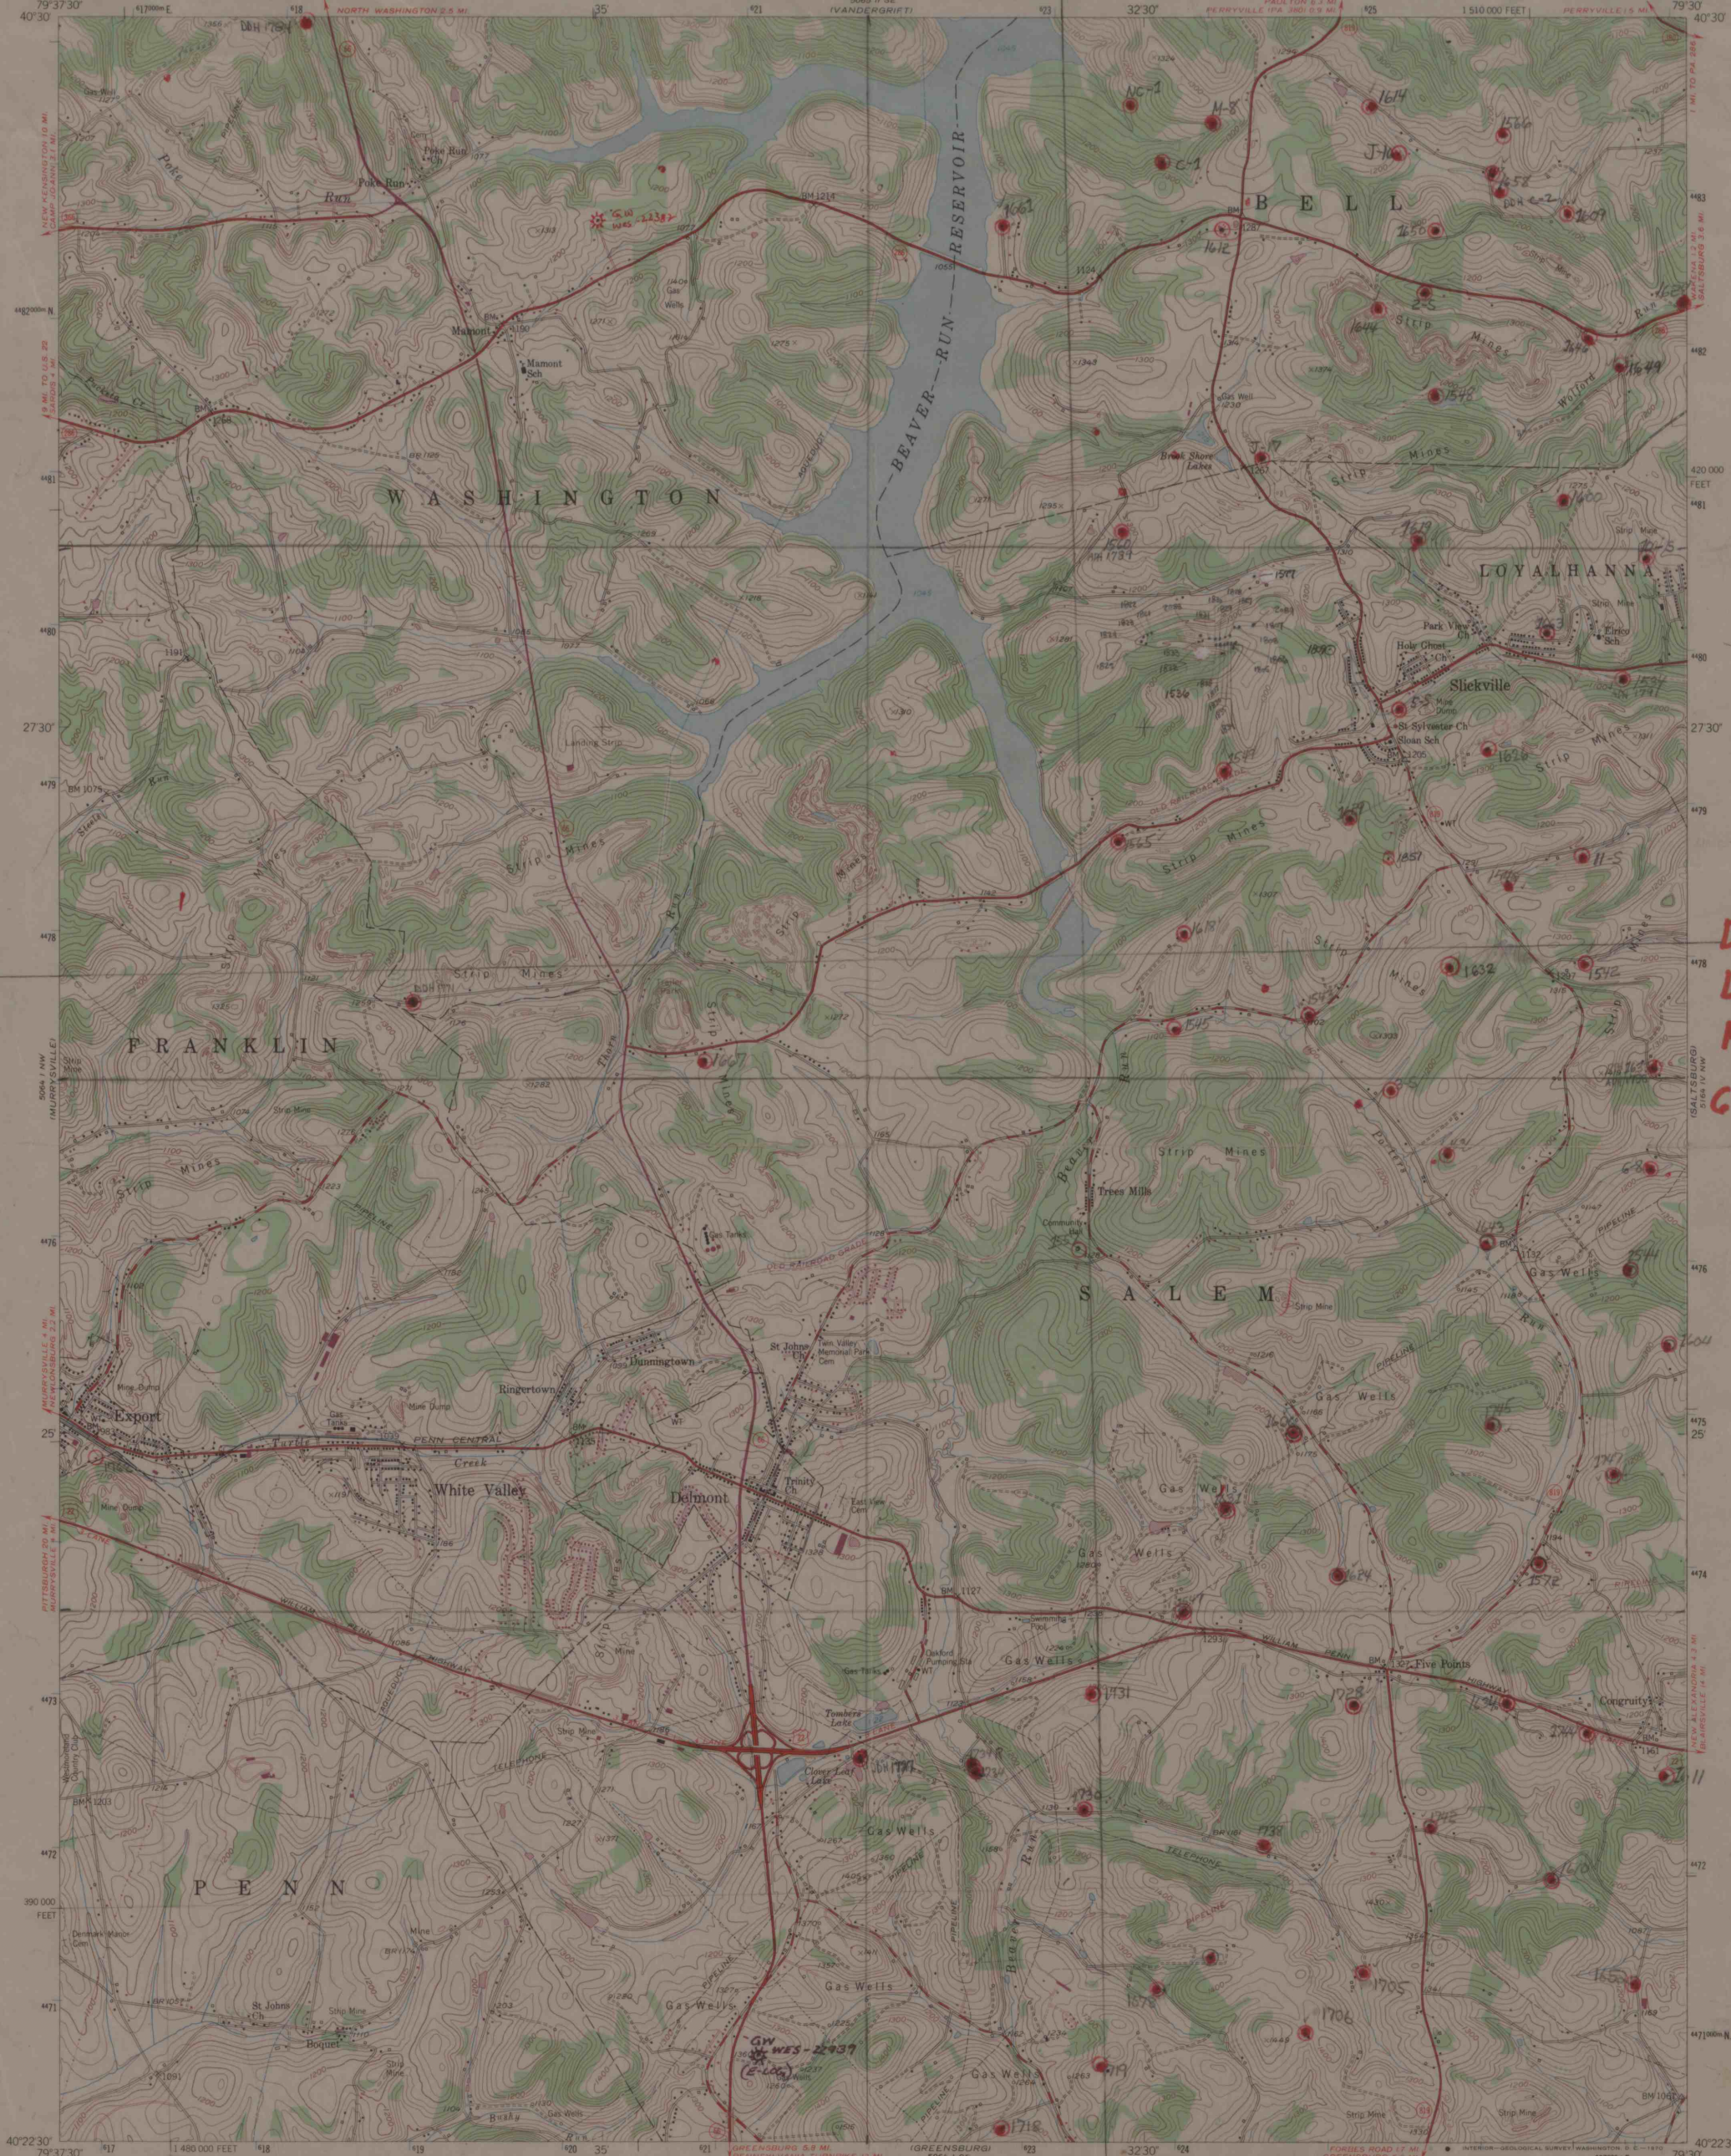

DDH
LOCATION
MAP
CPU +
AUG. MORE


Maped, edited, and published by the Geological Survey
Control by USGS and USC&GS
Topography by photogrammetric methods from aerial
photographs taken 1952. Field checked 1954
Polyconic projection. 1927 North American datum
10,000-foot grid based on Pennsylvania coordinate system, south zone
1000-meter Universal Transverse Mercator grid ticks,
zone 17, shown in blue
Revisions shown in purple compiled in cooperation with
State of Pennsylvania agencies from aerial photographs taken 1969
* This information not field checked

UTM GRID AND 1969 MAGNETIC NORTH
DECLINATION AT CENTER OF SHEET

DIAMOND DRILL HOLE
Location Maps
A-02
3-7-B

NOT TO BE TAKEN FROM OFFICE

ROAD CLASSIFICATION
Heavy-duty ——— Light-duty ———
Medium-duty ——— Unimproved dirt ———
U.S. Route ——— State Route ———

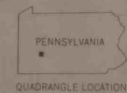

SLICKVILLE, PA.
NE/4 GREENSBURG 15 QUADRANGLE
N4022.5—W7930/7.5

1954
PHOTO REVISOR 1969
IMAPS#09244