


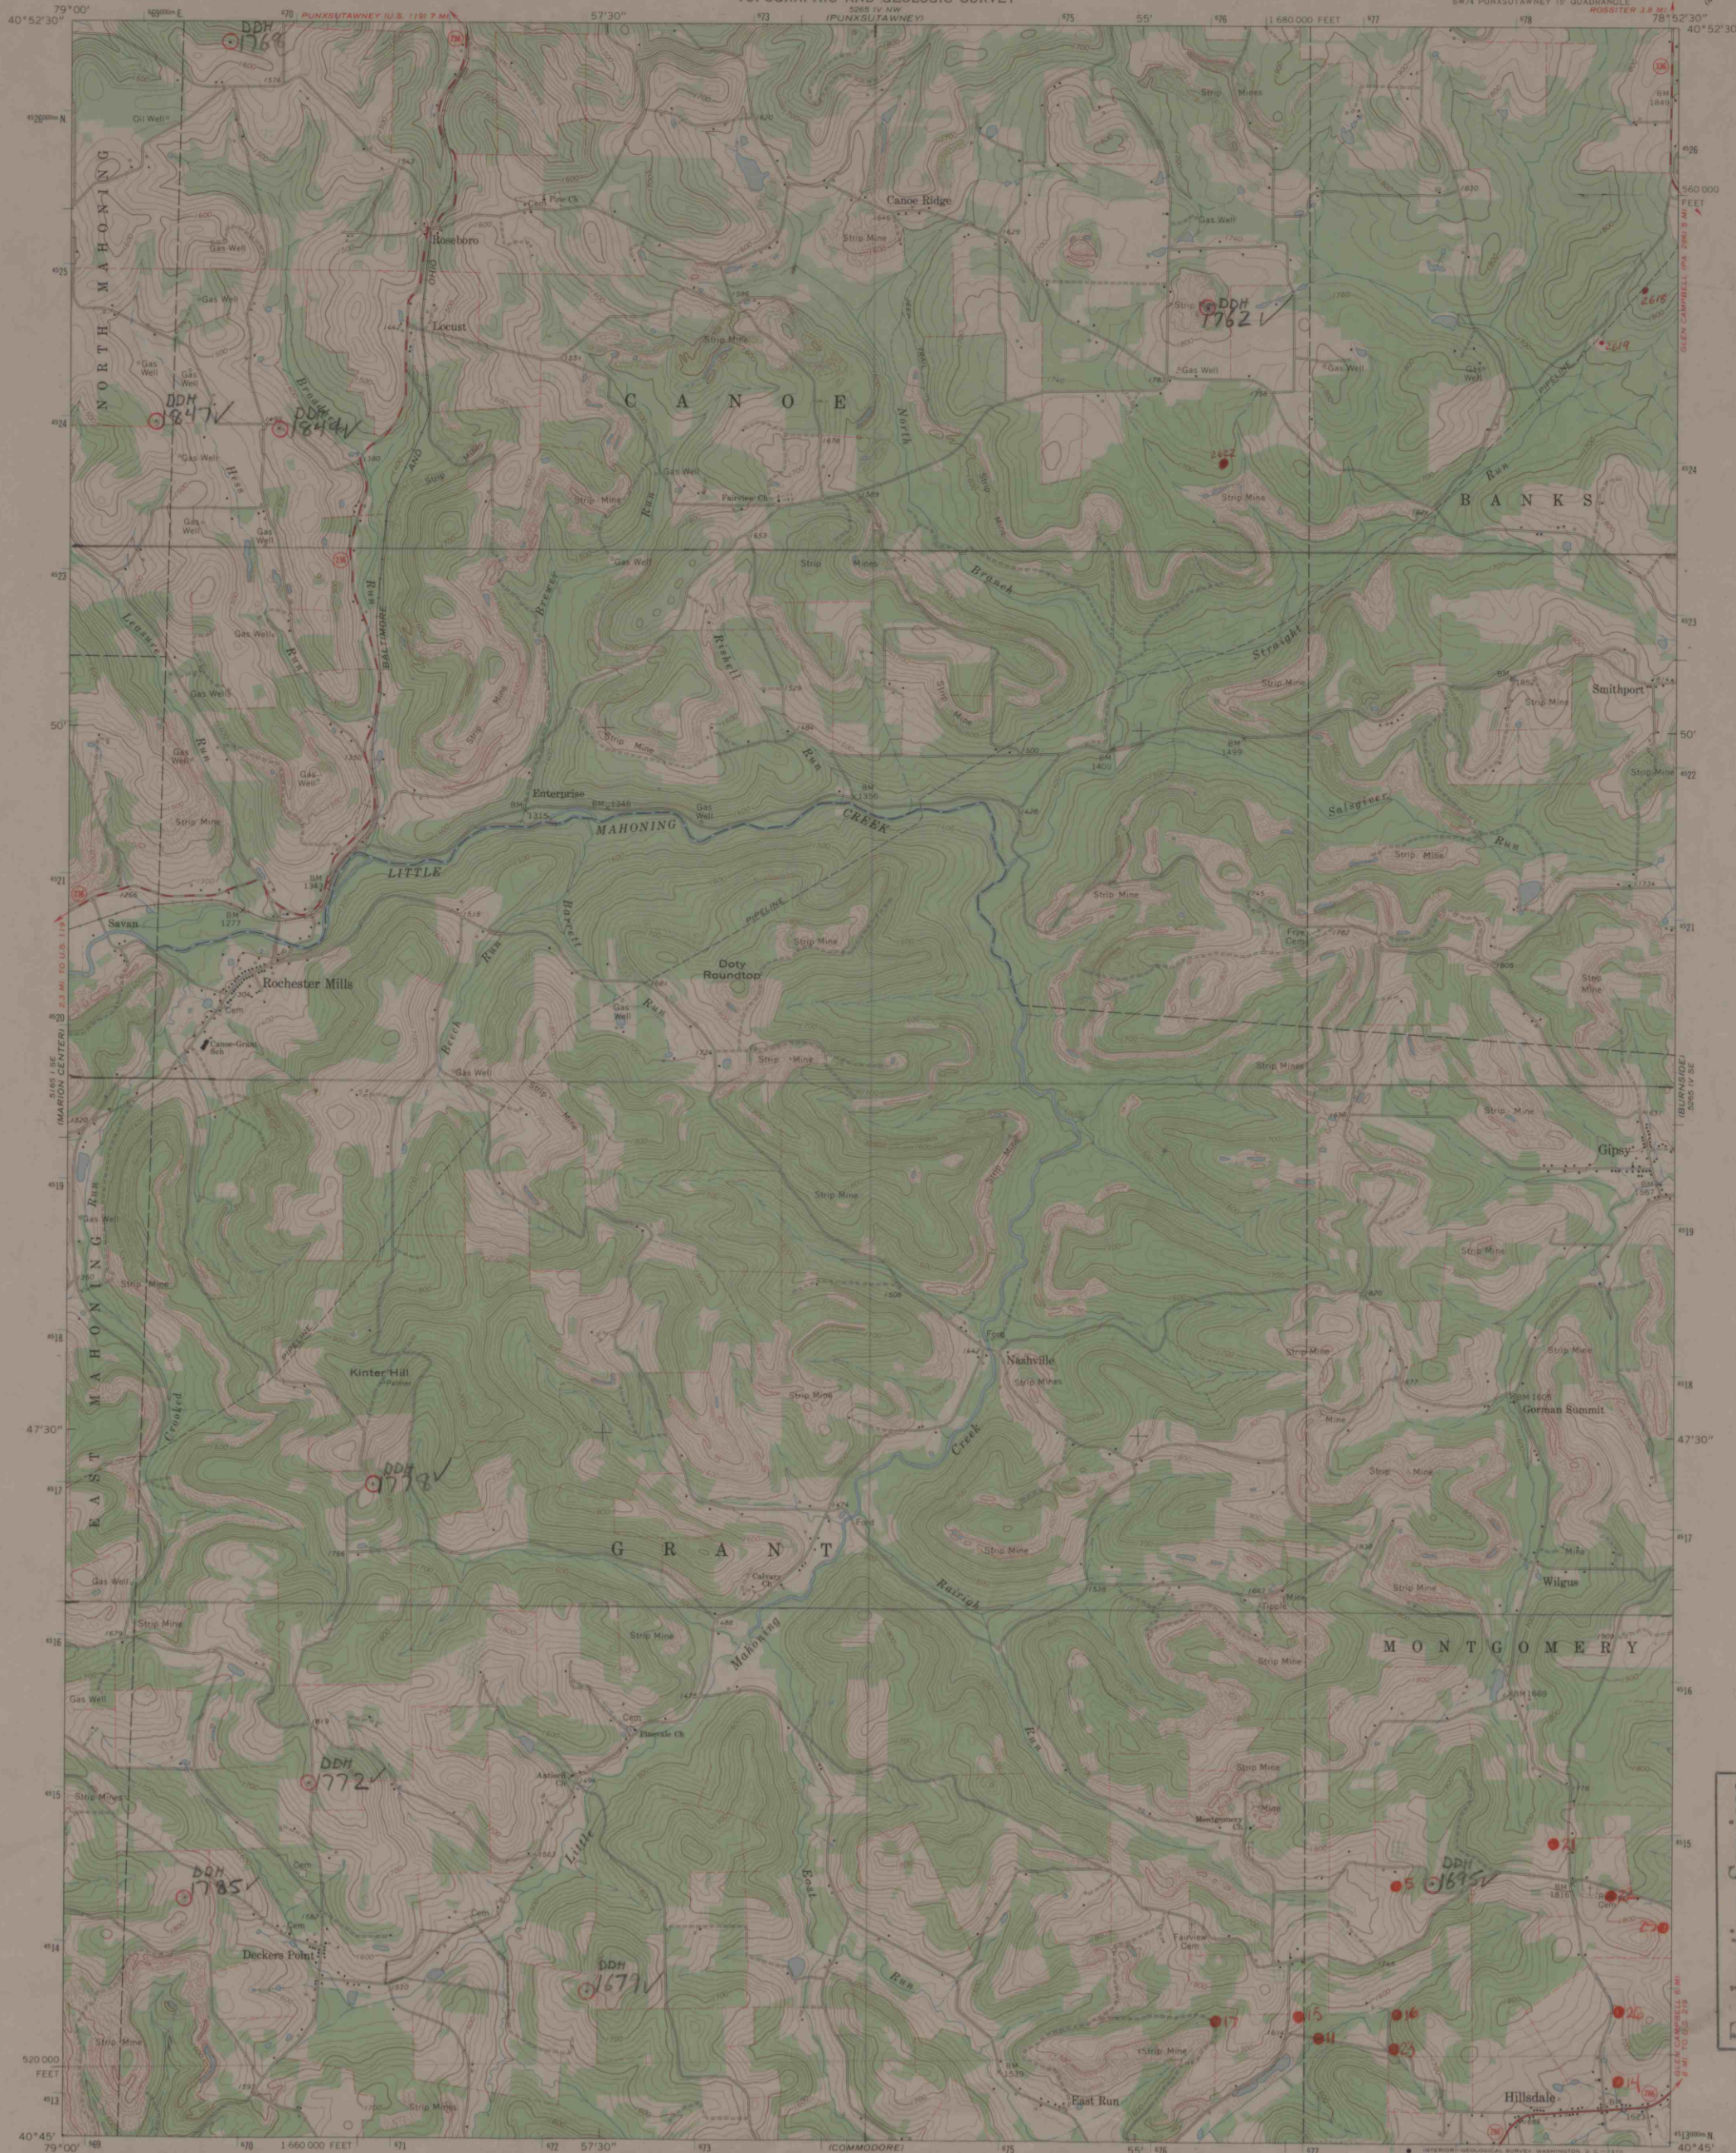

Mapped, edited, and published by the Geological Survey  
Control by USGS and USC&GS  
Topography by photogrammetric methods from aerial  
photographs taken 1967. Field checked 1968  
Polyconic projection. 1927 North American datum  
10,000-foot grid based on Pennsylvania coordinate system, south zone  
1000-meter Universal Transverse Mercator grid ticks,  
zone 17, shown in blue  
Fine red dashed lines indicate selected fence and field lines where  
generally visible on aerial photographs. This information is unchecked

UTM GRID AND 1968 MAGNETIC NORTH  
DECLINATION AT CENTER OF SHEET

DIAMOND DRILL HOLE  
Location Maps  
A-02

NOT TO BE TAKEN FROM OFFICE

ROAD CLASSIFICATION  
Primary highway, all weather, hard surface  
Secondary highway, all weather, hard surface  
Light-duty road, all weather, improved surface  
Unimproved road, fair or dry weather  
State Route

ROCHESTER MILLS, PA.  
SW/4 PUNKSUTAWNEY 15 QUADRANGLE  
N4045-W7552.5/7.5

1968  
AMS 5265 IV SW-SERIES V831

Exploration Services  
Division  
Authorization  
290-00-015

IMAPS#09260