

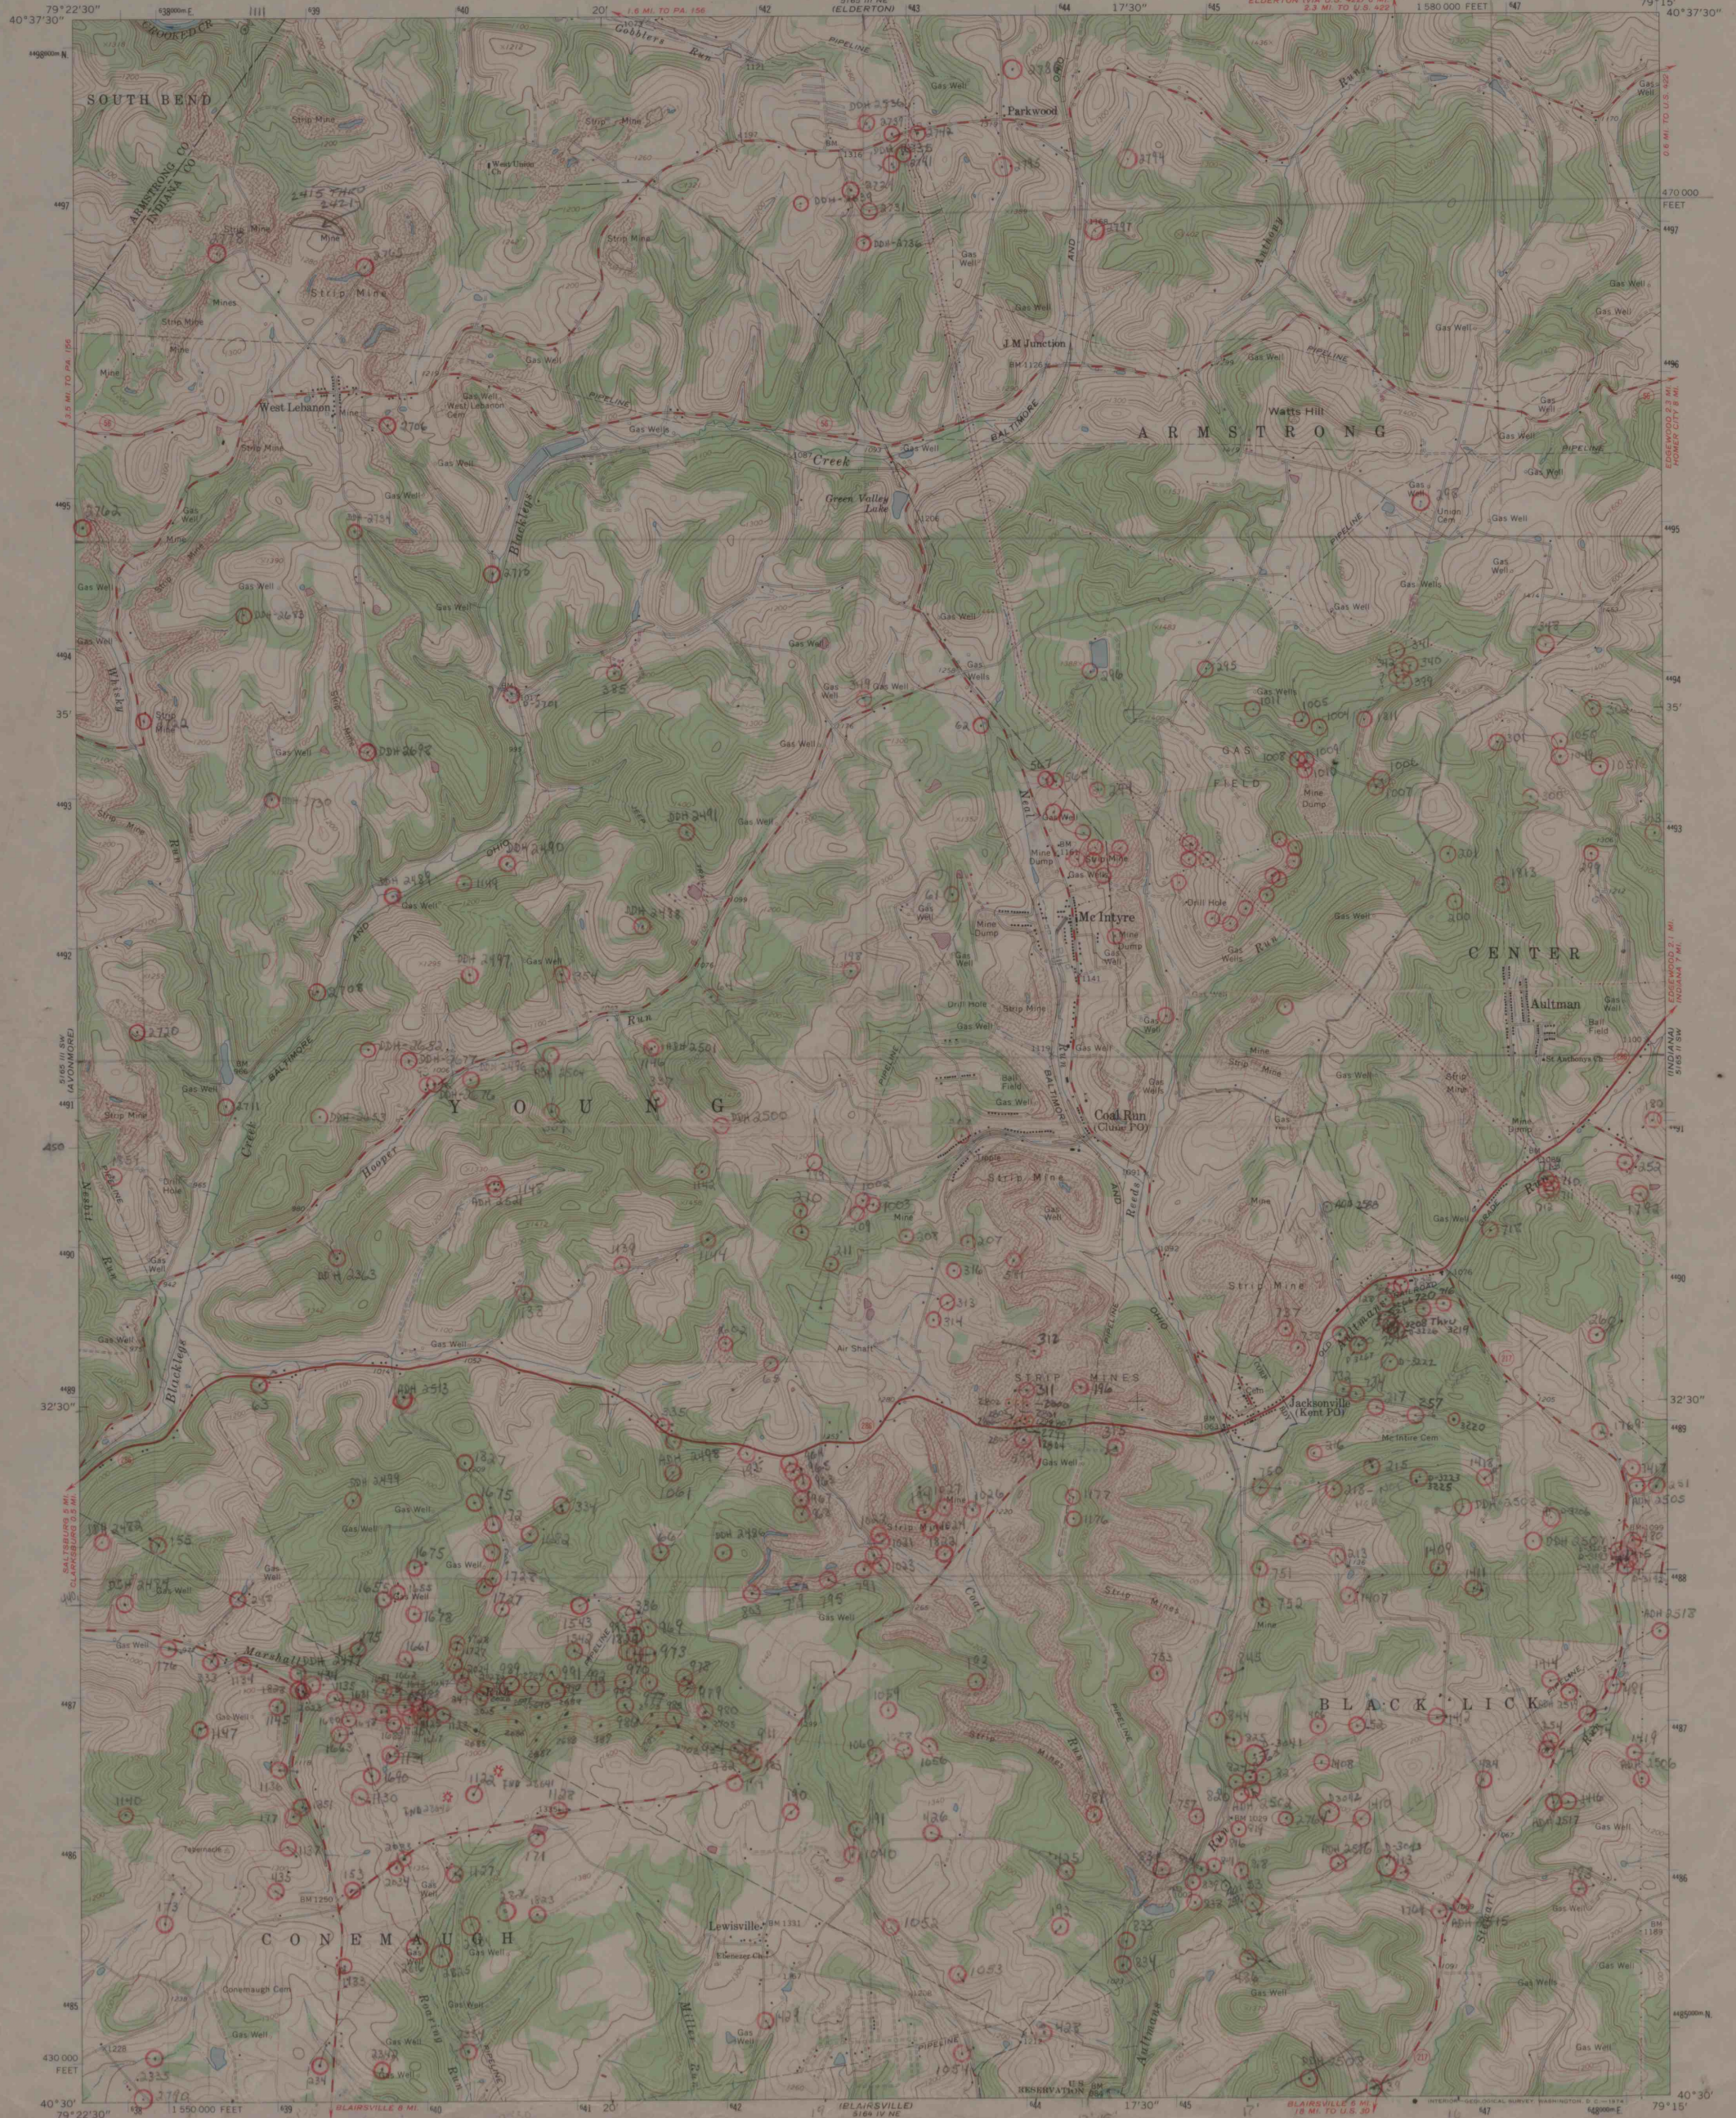


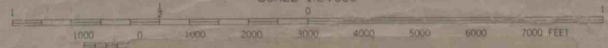

Mapped, edited, and published by the Geological Survey
Control by USGS, USC&GS, and USCE
Topography by photogrammetric methods from aerial
photographs taken 1962 and 1963. Field checked 1964
Polyconic projection. 1927 North American datum
10,000-foot grid based on Pennsylvania coordinate system, south zone
1000-meter Universal Transverse Mercator grid ticks,
zone 17, shown in blue
Fine red dashed lines indicate selected fence and field lines where
generally visible on aerial photographs. This information is unchecked
U.S. Preservation boundary from map by U.S. Corps of Engineers
Area covered by dashed light blue pattern is subject to controlled
inundation to 975 feet by Conemaugh Dam

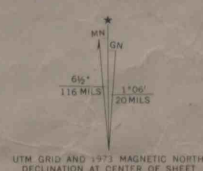

DIAMOND DRILL HOLE MAP
(SUPPLEMENTAL)

4-6-D
2/2/83

One of Two

ROAD CLASSIFICATION
Heavy-duty ——— Light-duty ———
Medium-duty ——— Unimproved dirt ———
State Route —○—



MCINTYRE, PA.

N4030-W7915-7.5

1964

PHOTOGRAPHED 1973
AMS 5185 III SE-SERIES V831

Regions shown in purple compiled in cooperation with
State of Pennsylvania agencies from aerial photographs
taken 1973. This information not field checked

EMAPS# 09261