



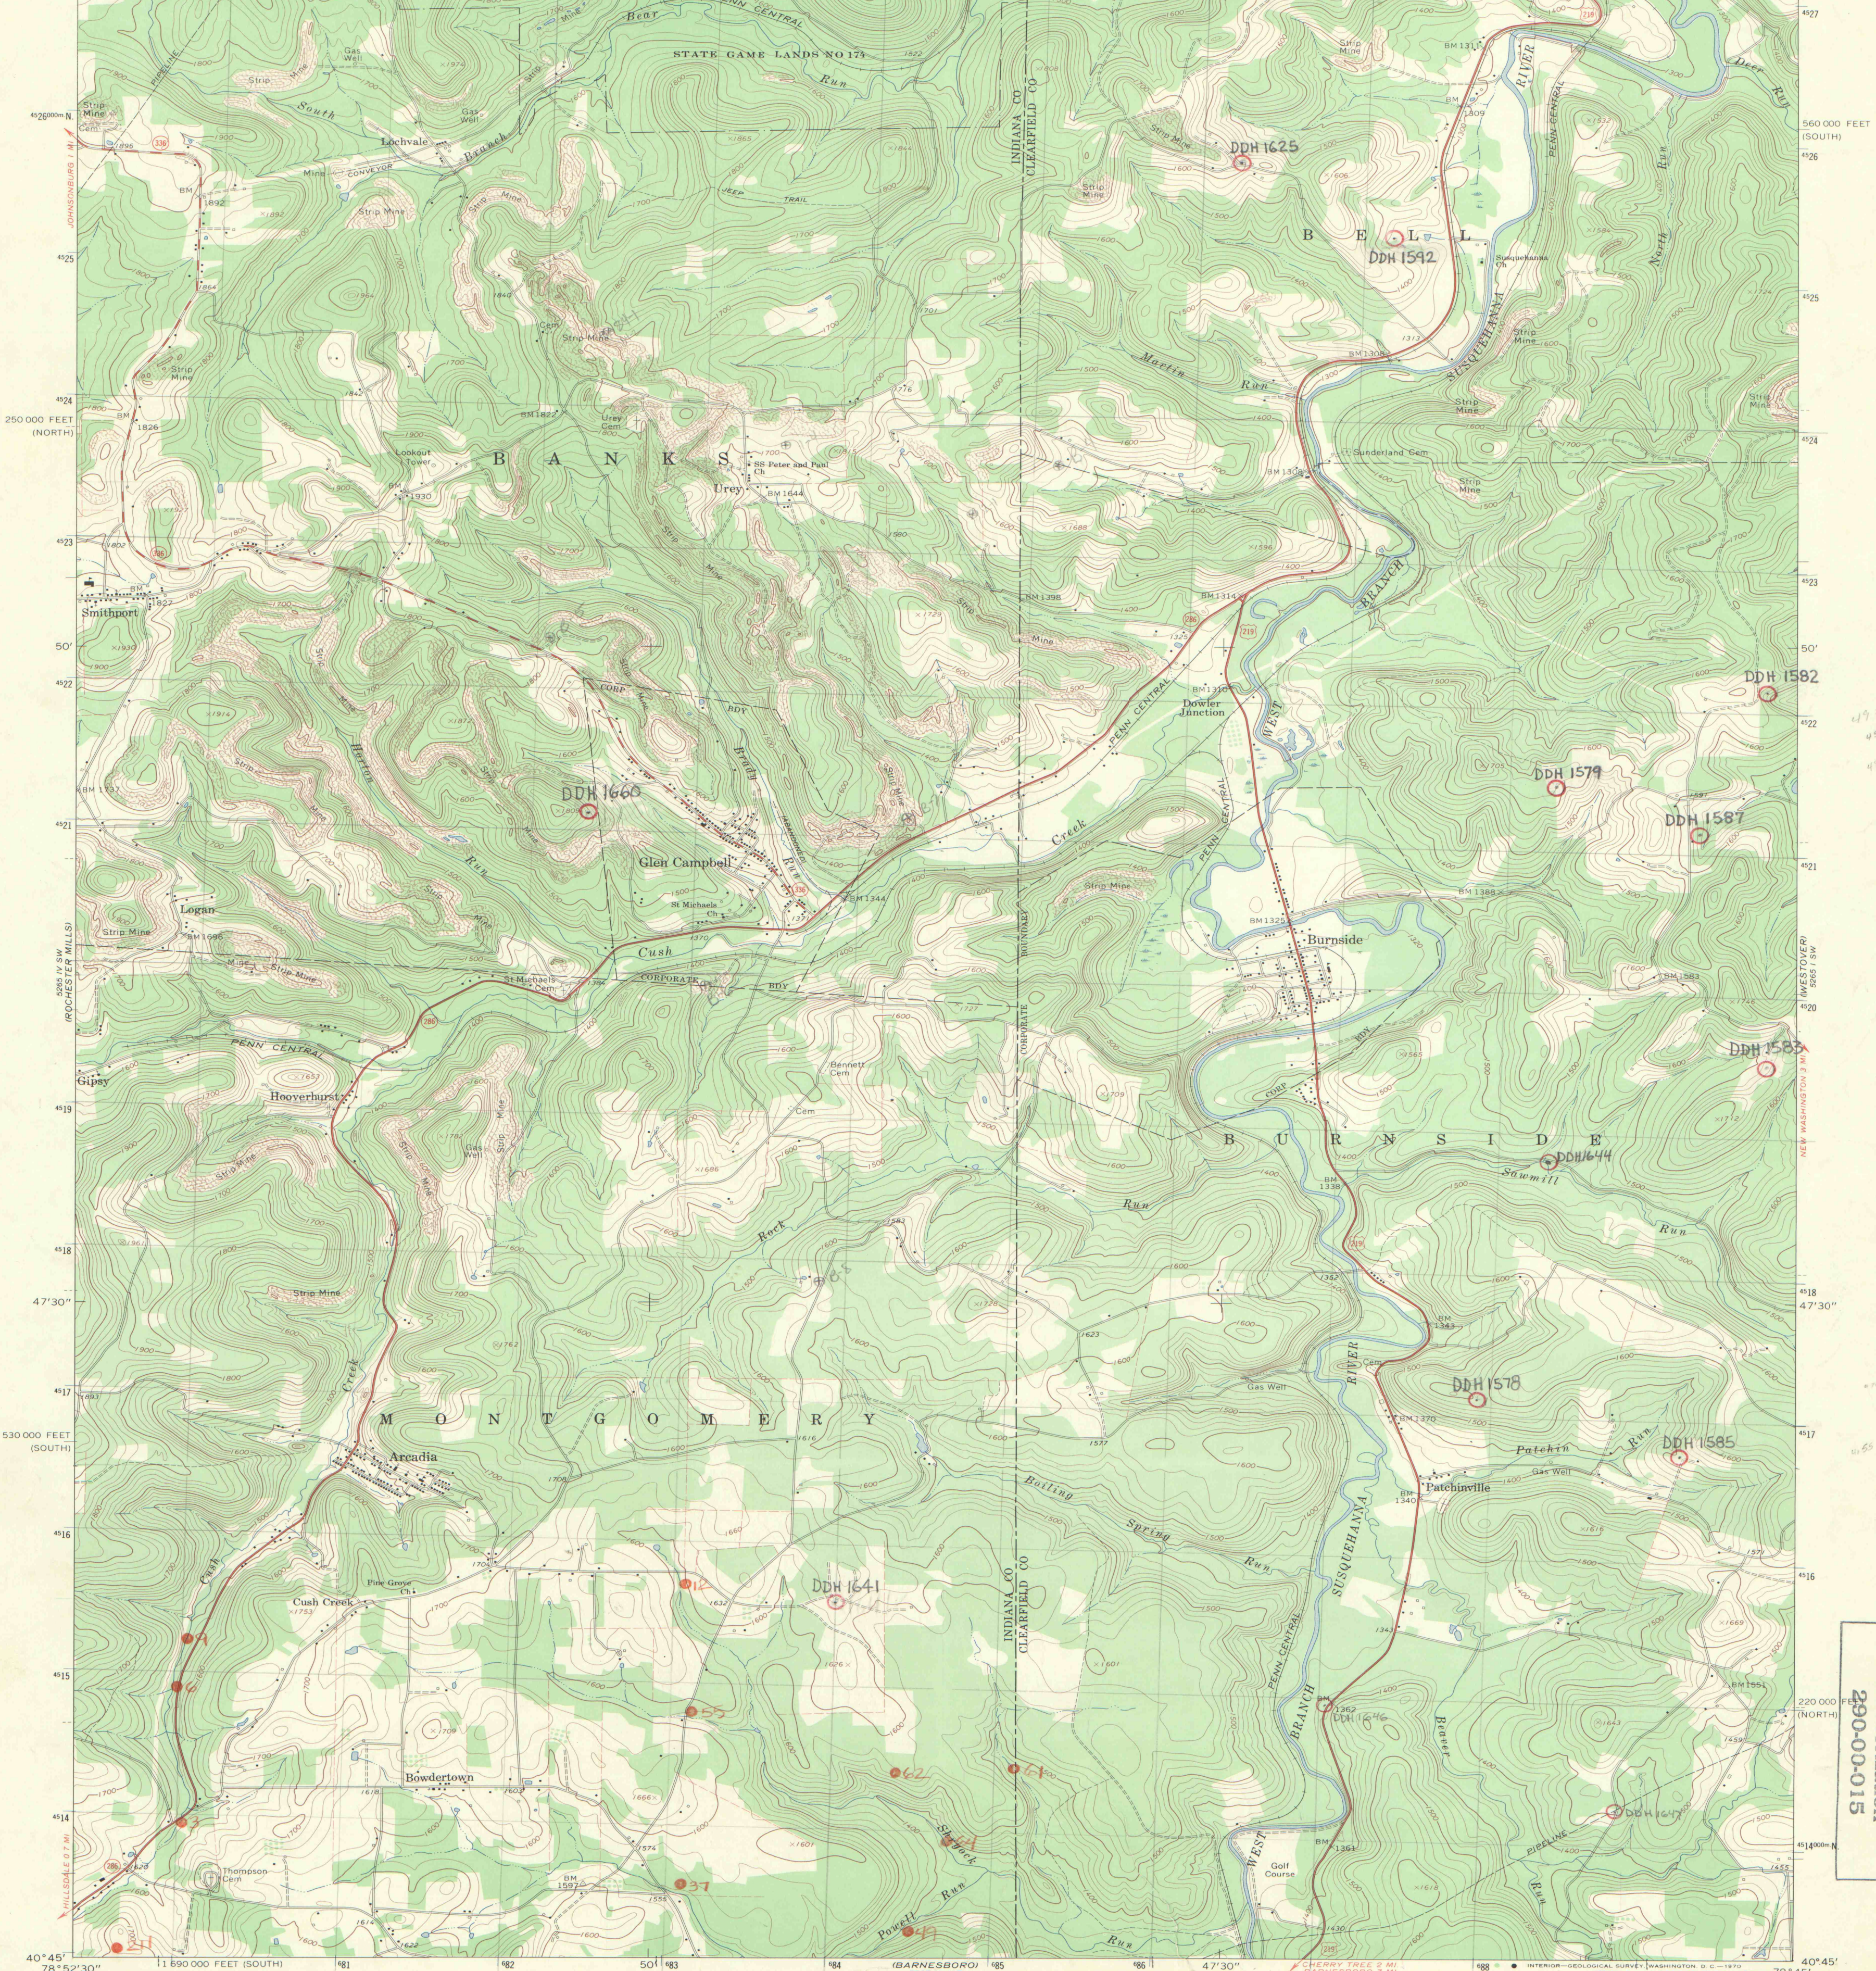

Mapped, edited, and published by the Geological Survey
Control by USGS and USC&GS
Topography by photogrammetric methods from aerial photographs taken 1967. Field checked 1968
Polyconic projection - 1927 North American datum
10,000-foot grids based on Pennsylvania coordinate system, south and north zones
1000-meter Universal Transverse Mercator grid ticks, zone 17, shown in blue
Fine red dashed lines indicate selected fence and field lines where generally visible on aerial photographs. This information is unchecked

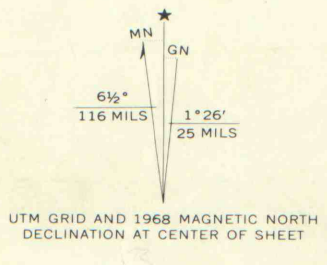

DIAMOND DRILL HOLE
Location Maps
A-02
6-5-D

NOT TO BE TAKEN FROM OFFICE

ROAD CLASSIFICATION
Primary highway, all weather, hard surface
Secondary highway, all weather, hard surface
Light-duty road, all weather, improved surface
Unimproved road, fair or dry weather
U. S. Route
State Route

BURNSIDE, PA.
SE/4 PUNKSUTAWNEY 15' QUADRANGLE
N4045-W7845/7.5

Exploration Services
Division
Authorization
290-00-015

92210#SIV1