




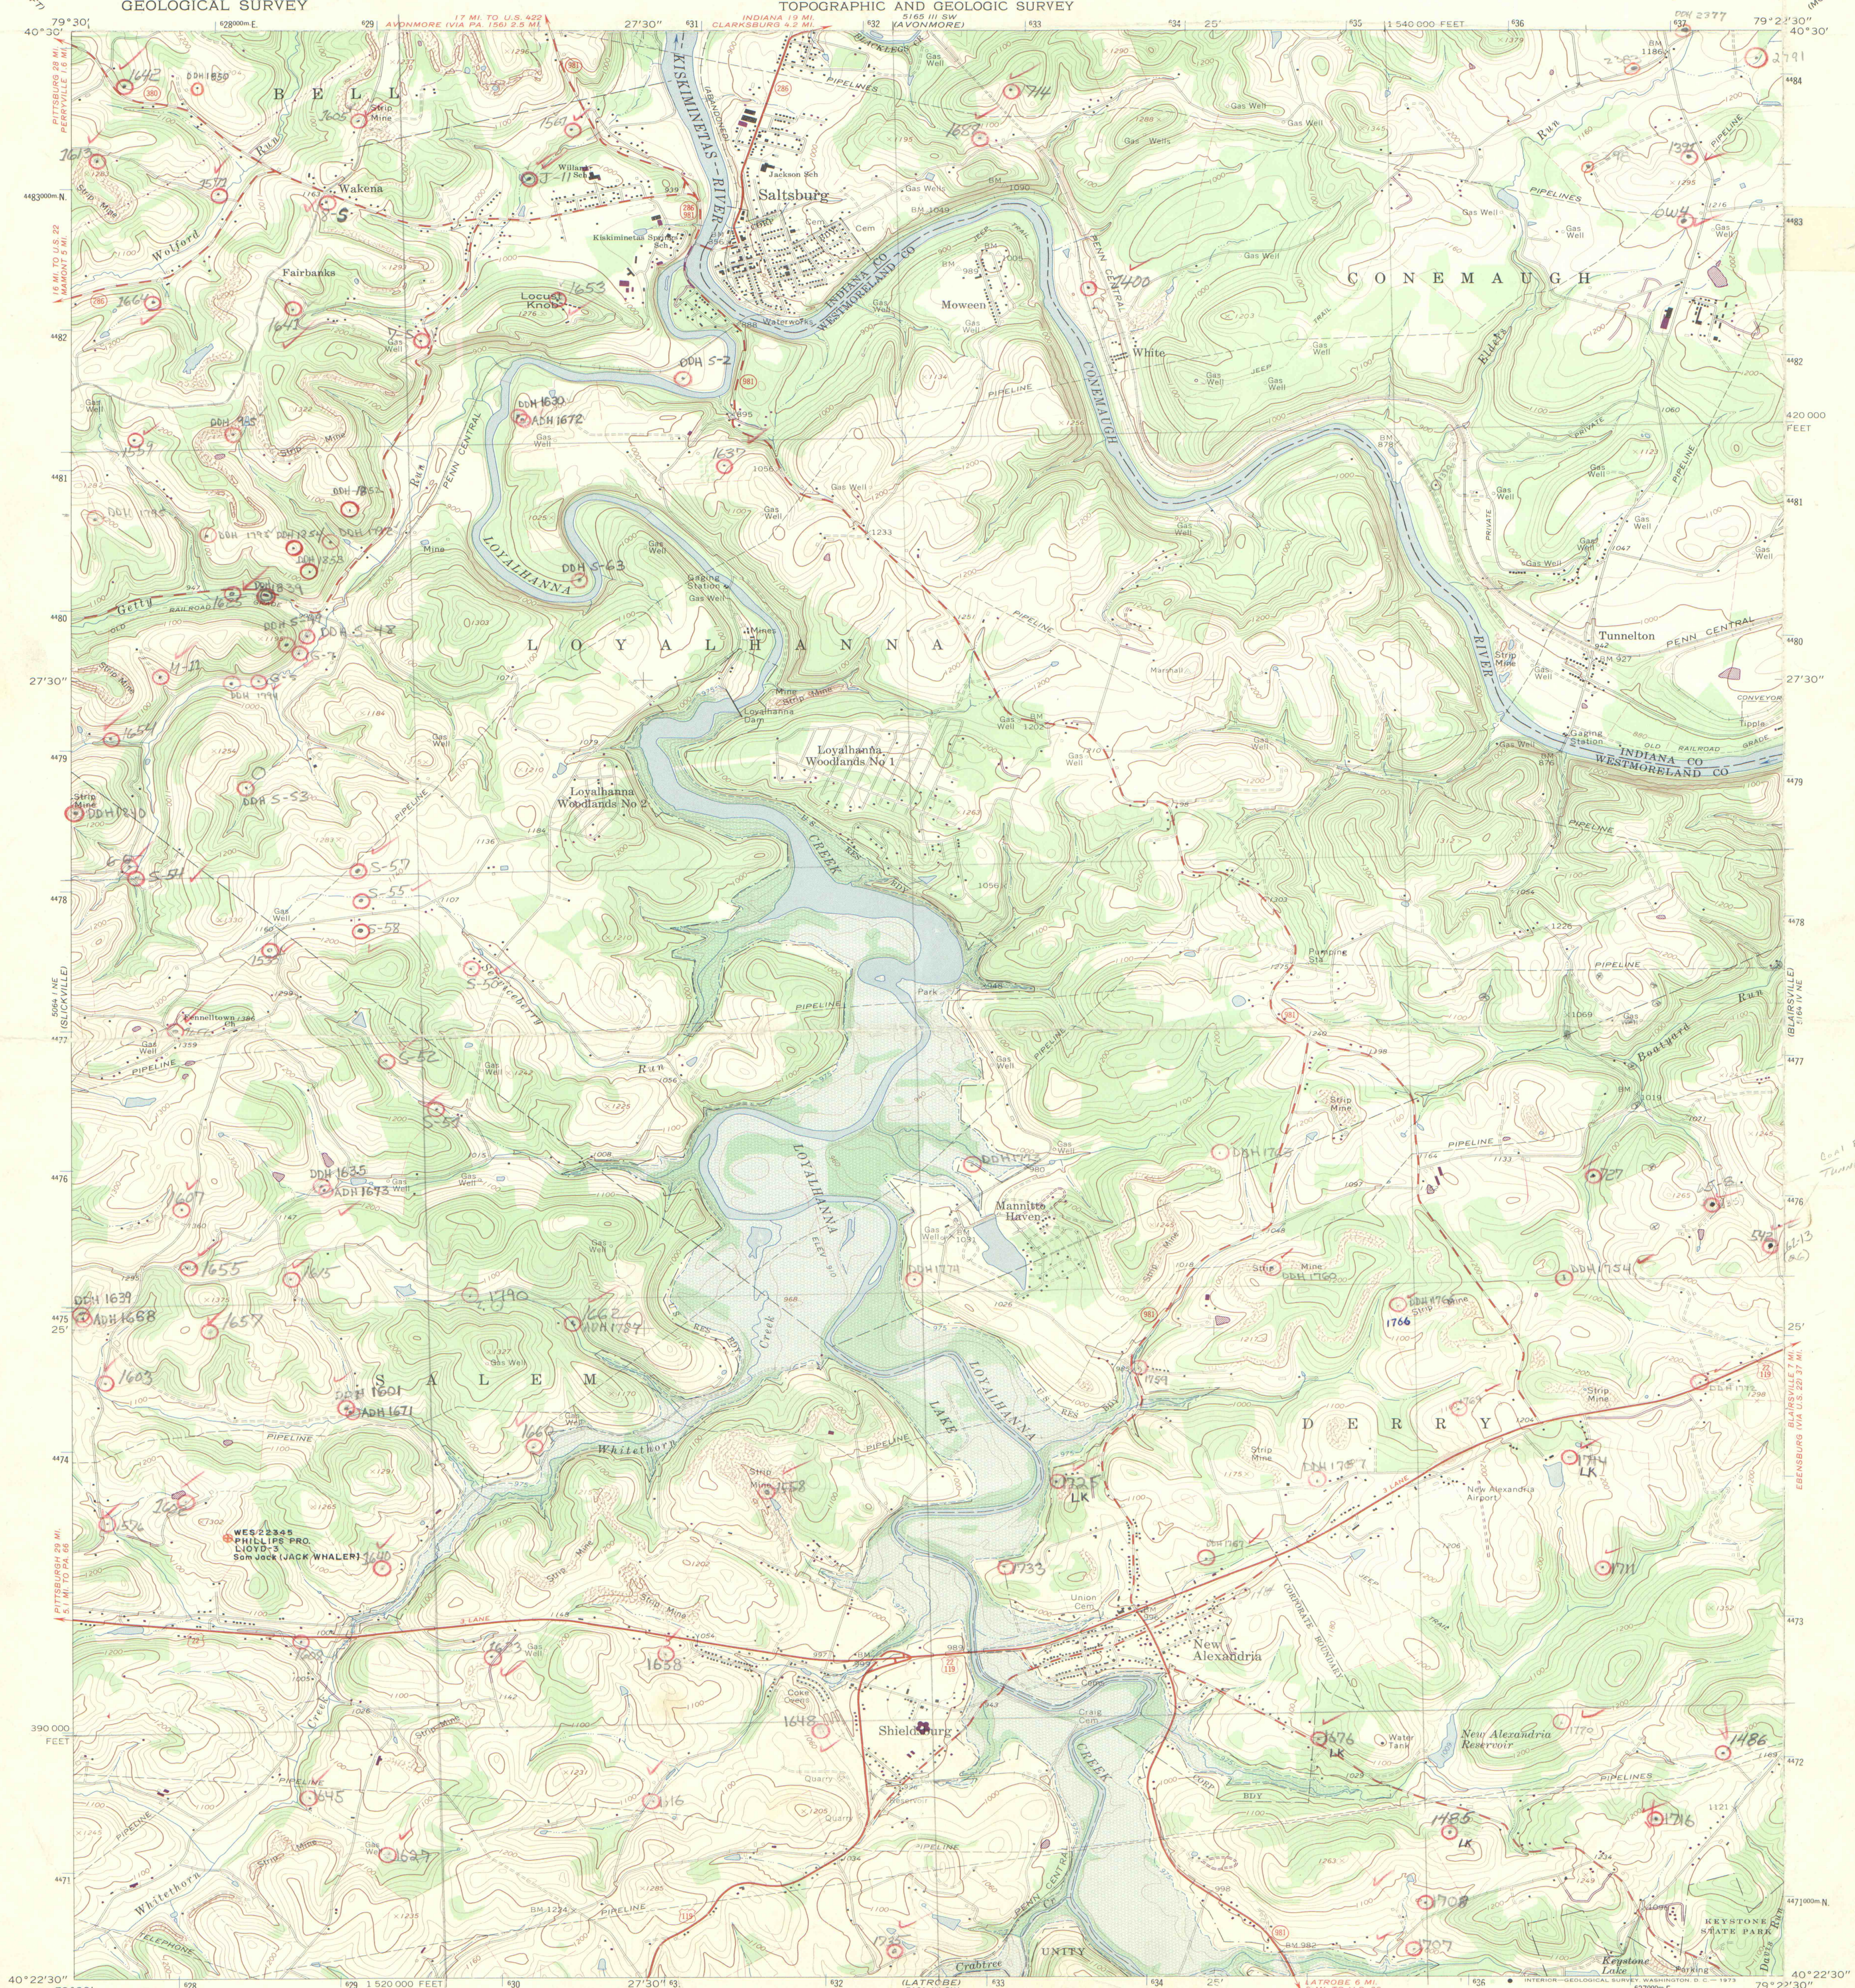

Mapped, edited, and published by the Geological Survey
Control by USGS, USC&GS, and USCE
Topography by photogrammetric methods from aerial photographs
taken 1962. Field checked 1964
Polyconic projection. 1927 North American datum
10,000-foot grid based on Pennsylvania coordinate system, south zone
1000-meter Universal Transverse Mercator grid ticks,
zone 17, shown in blue
Fine red dashed lines indicate selected fence and field lines where
generally visible on aerial photographs. This information is unchecked
U. S. Reservation boundary from maps by U. S. Corps of Engineers
Area covered by dashed light-blue pattern is subject to
controlled inundation

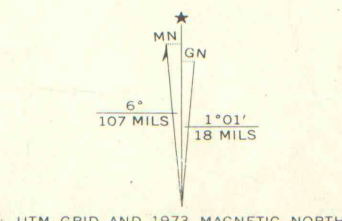

DIAMOND DRILL HOLE
Location Maps
A-02
4-7-A
NOT TO BE TAKEN FROM OFFICE

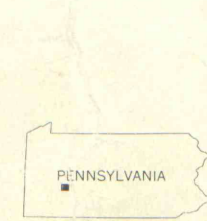

ROAD CLASSIFICATION
Heavy-duty ——— Light-duty ———
Medium-duty ——— Unimproved dirt ———
U. S. Route ——— State Route ———
GAS WELL W/ E-LOG
SALTSBURG, PA.
N4022.5—W7922.5/7.5
1964
PHOTOREVISED 1973
AMS 5164 IV NW—SERIES V831

Revisions shown in purple compiled in cooperation with
State of Pennsylvania agencies from aerial photographs
taken 1973. This information not field checked

Coal Elevations for
TUNNELTEN MINING CO.
HOLE 2

IMAPS#09761