


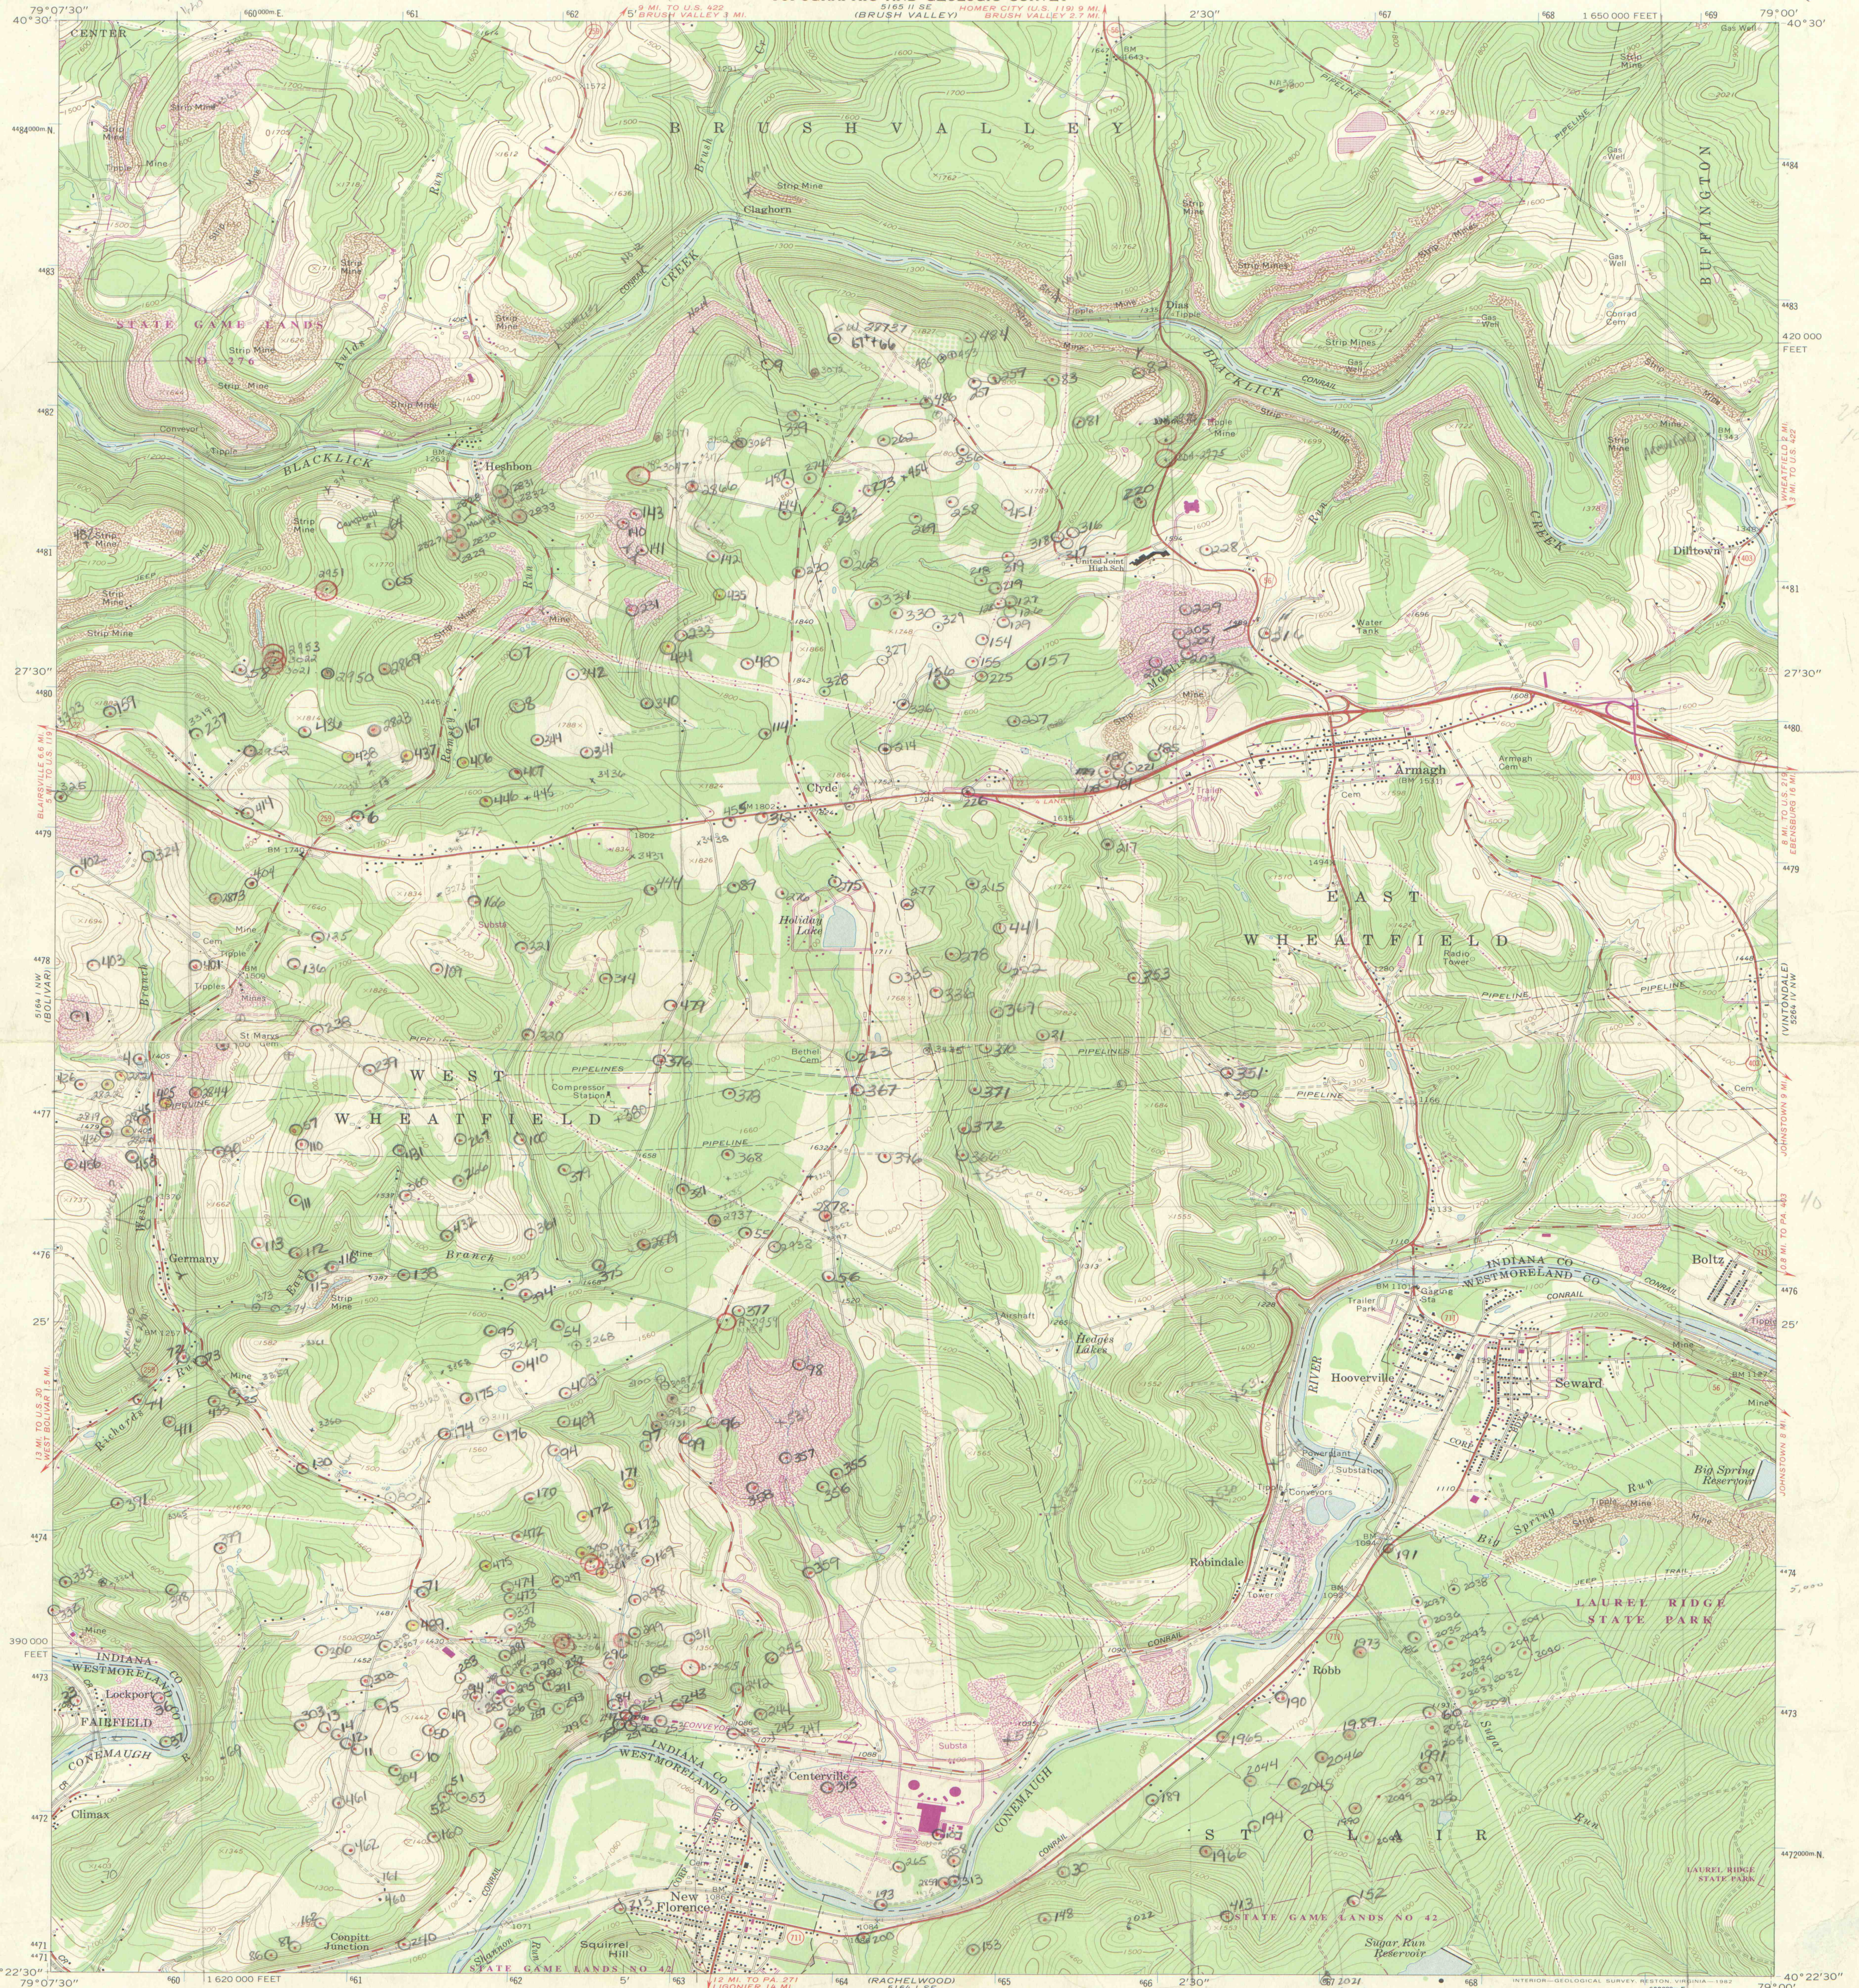


Mapped, edited, and published by the Geological Survey

Control by USGS and NOS/NOAA
Topography by photogrammetric methods from aerial photographs taken 1962. Field checked 1964

Polyconic projection. 10,000-foot grid ticks based on Pennsylvania coordinate system, south zone. 1000-meter Universal Transverse Mercator grid ticks, zone 17, shown in blue. 1927 North American Datum. To place on the predicted North American Datum 1983 move the projection lines 4 meters south and 21 meters west as shown by dashed corner ticks


Fine red dashed lines indicate selected fence and field lines where generally visible on aerial photographs. This information is unchecked
There may be private inholdings within the boundaries of the National or State reservations shown on this map

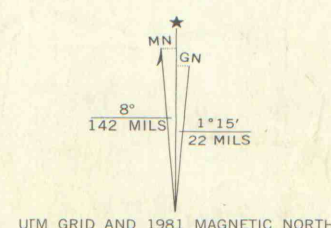

THIS MAP COMP
FOR SALE BY U.
A FOLDER DESCRIBING TO

NOT TO BE REMOVED FROM THE OFFICE

GREEN SHEET
Office Copy
A-04

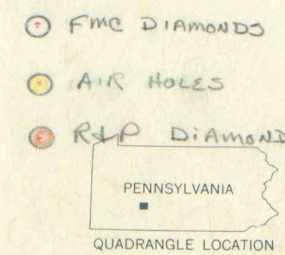

ROAD CLASSIFICATION
Heavy-duty — Light-duty —
Medium-duty — Unimproved dirt —
U.S. Route — State Route

NEW FLORENCE, PA.

N4022.5—W7900/7.5

1964
PHOTO-REVISED 1981
DMA 5164 I NE-SERIES V831

Map in purple and woodland compiled in cooperation with
th of Pennsylvania agencies from aerial photographs taken 1977
sources. This information not field checked. Map edited 1981

IMAPS#09282