


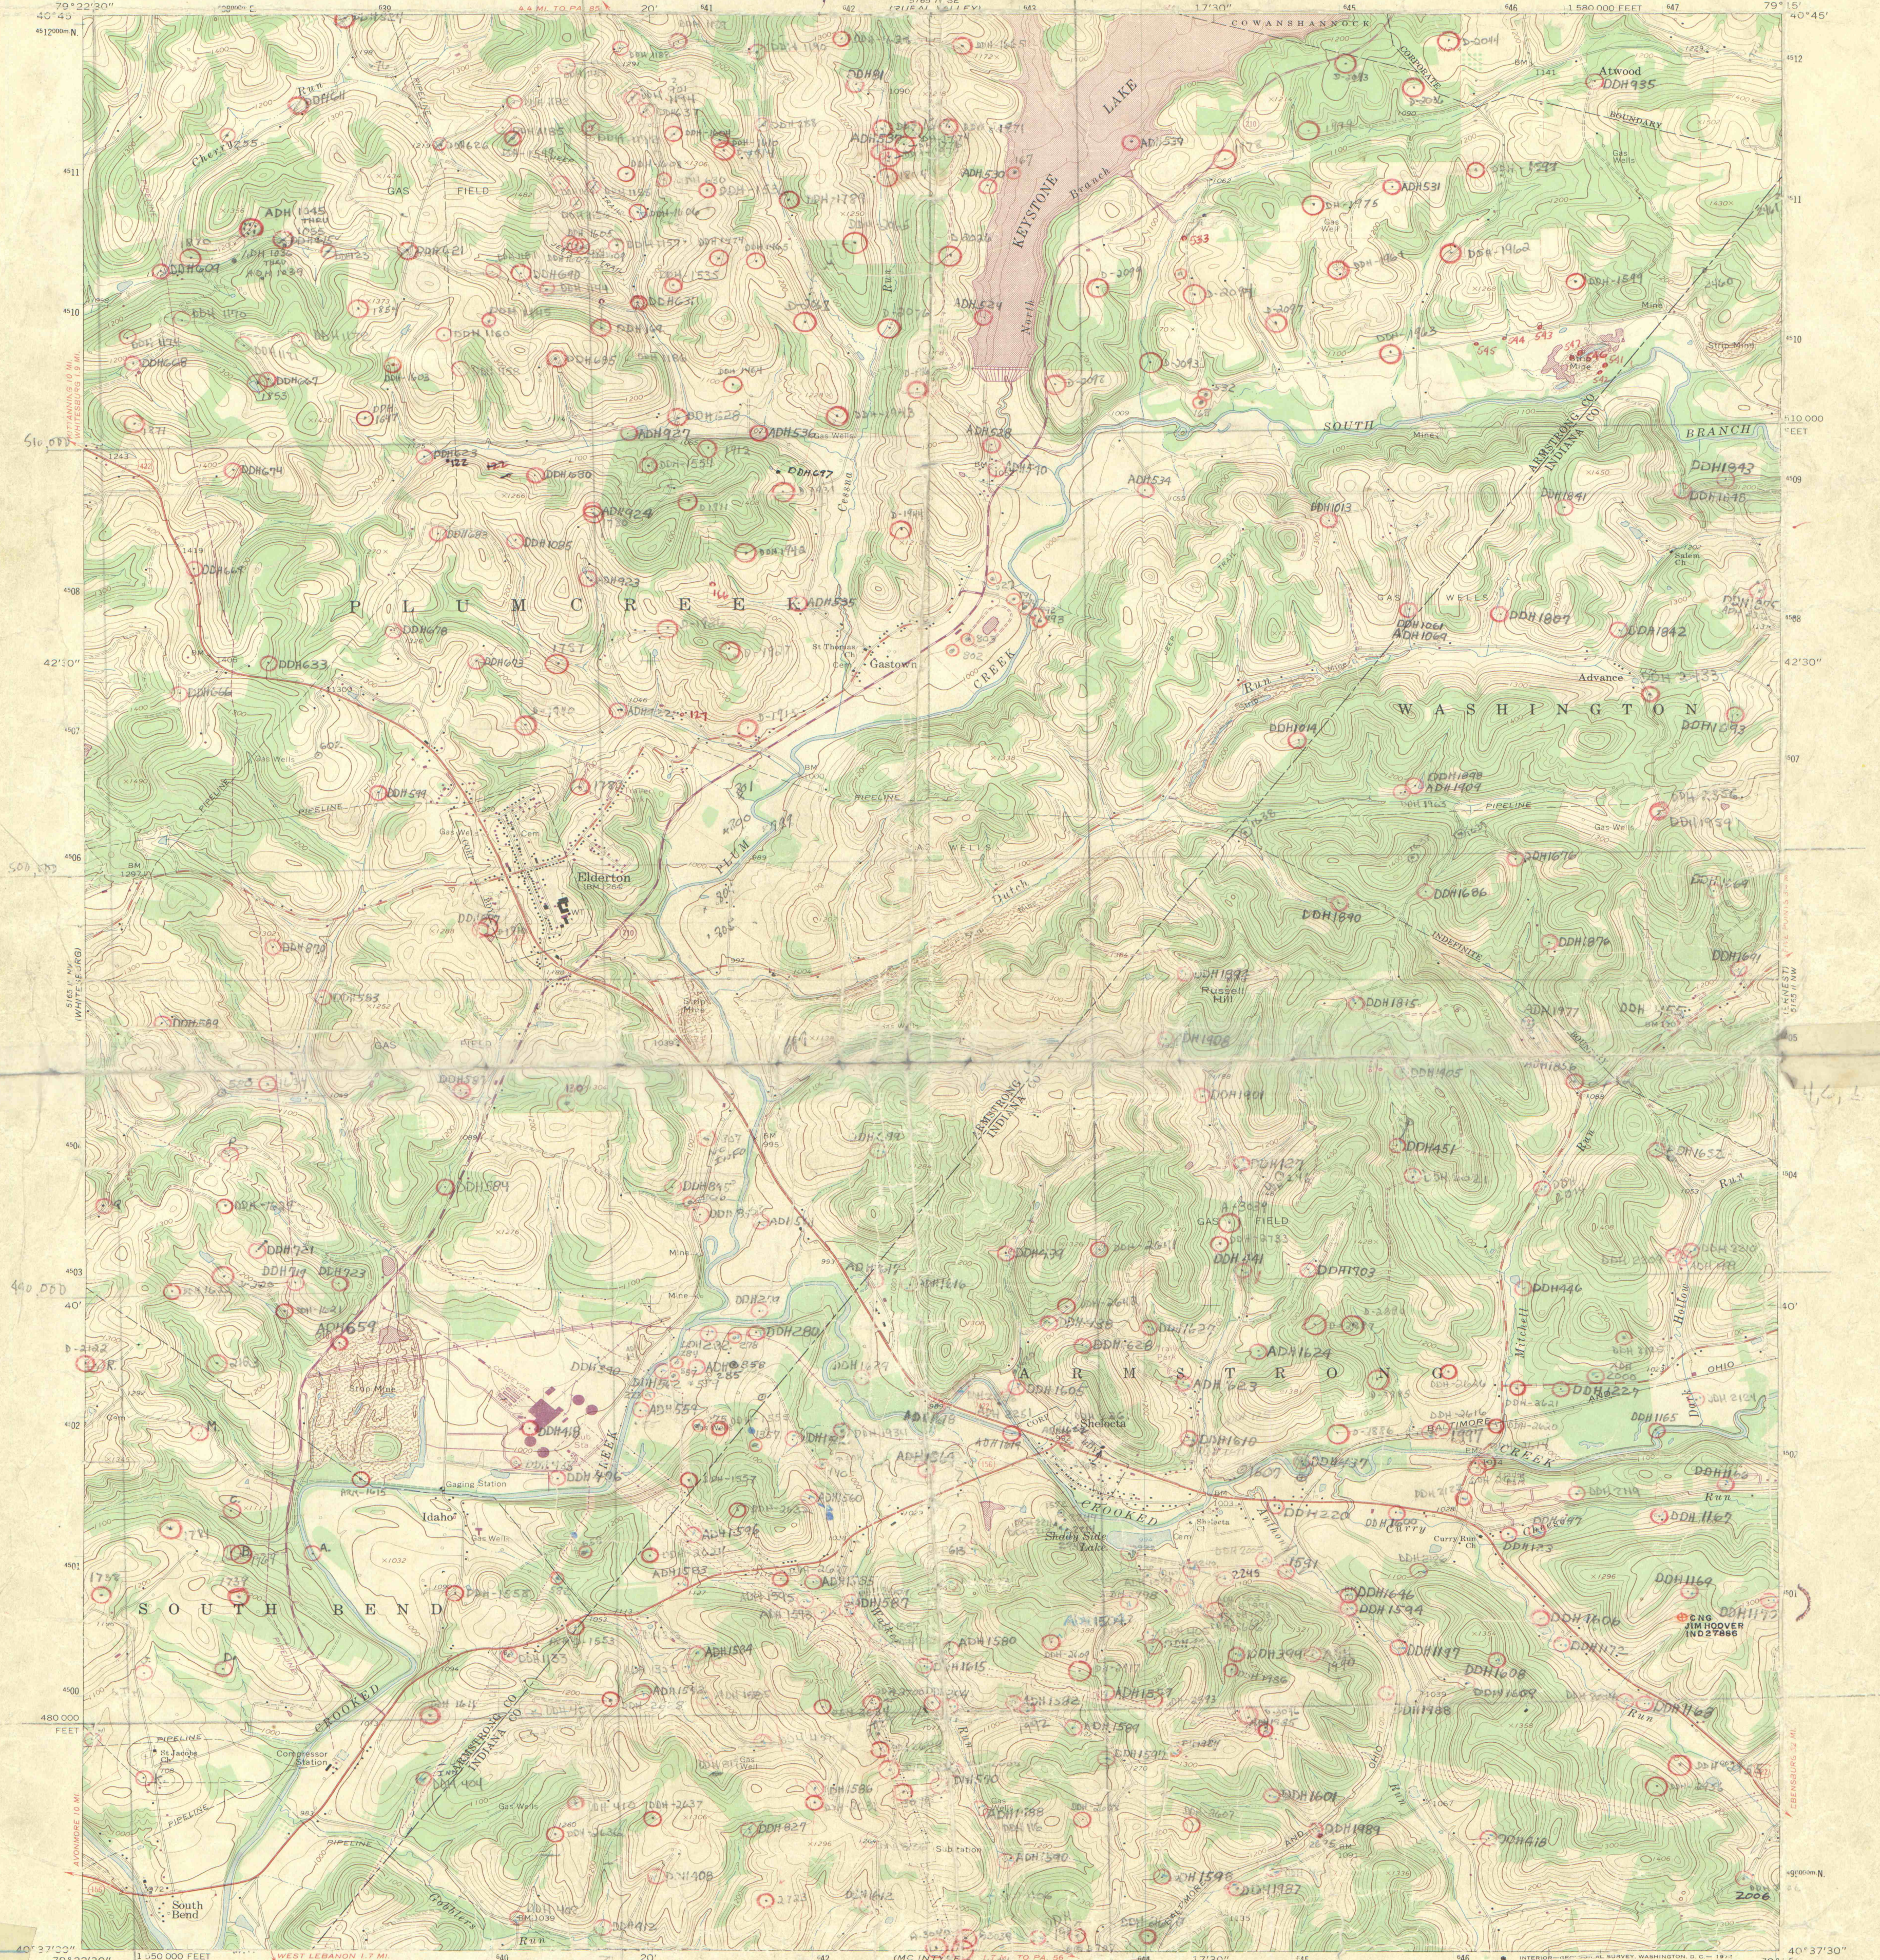

Mapped, edited, and published by the Geological Survey
Control by USGS and USC&GS
Topography by photogrammetric methods from aerial
photographs taken 1963. Field checked 1964.
Polyconic projection, 1927 North American datum
10,000-foot grid based on Pennsylvania coordinate system, south zone
1000-meter Universal Transverse Mercator grid ticks,
zone 17, shown in blue
Fire red dashed lines indicate selected fence and field lines where
generally visible on aerial photographs. This information is unchecked

UTM GRID AND 1997 MAGNETIC NORTH
DECLINATION AT CENTER OF SHEET

SCALE 1:24,000
CONTOUR INTERVAL 20 FEET
DATUM IS MEAN SEA LEVEL

DIAMOND DRILL HOLE
Location Maps
A-02
463
NOT TO BE TAKEN FROM OFFICE

ROAD CLASSIFICATION
Heavy-duty
Light-duty
Unimproved dirt
J.S. Route
Slate Route
GAS WELL W/E-LOG
ELDERTON, PA.
N4037.5—W7915.75
1954
PHOTOGRAPHED 1973
AAS 5165 NE—SERIES V831

IMAPS#09285