


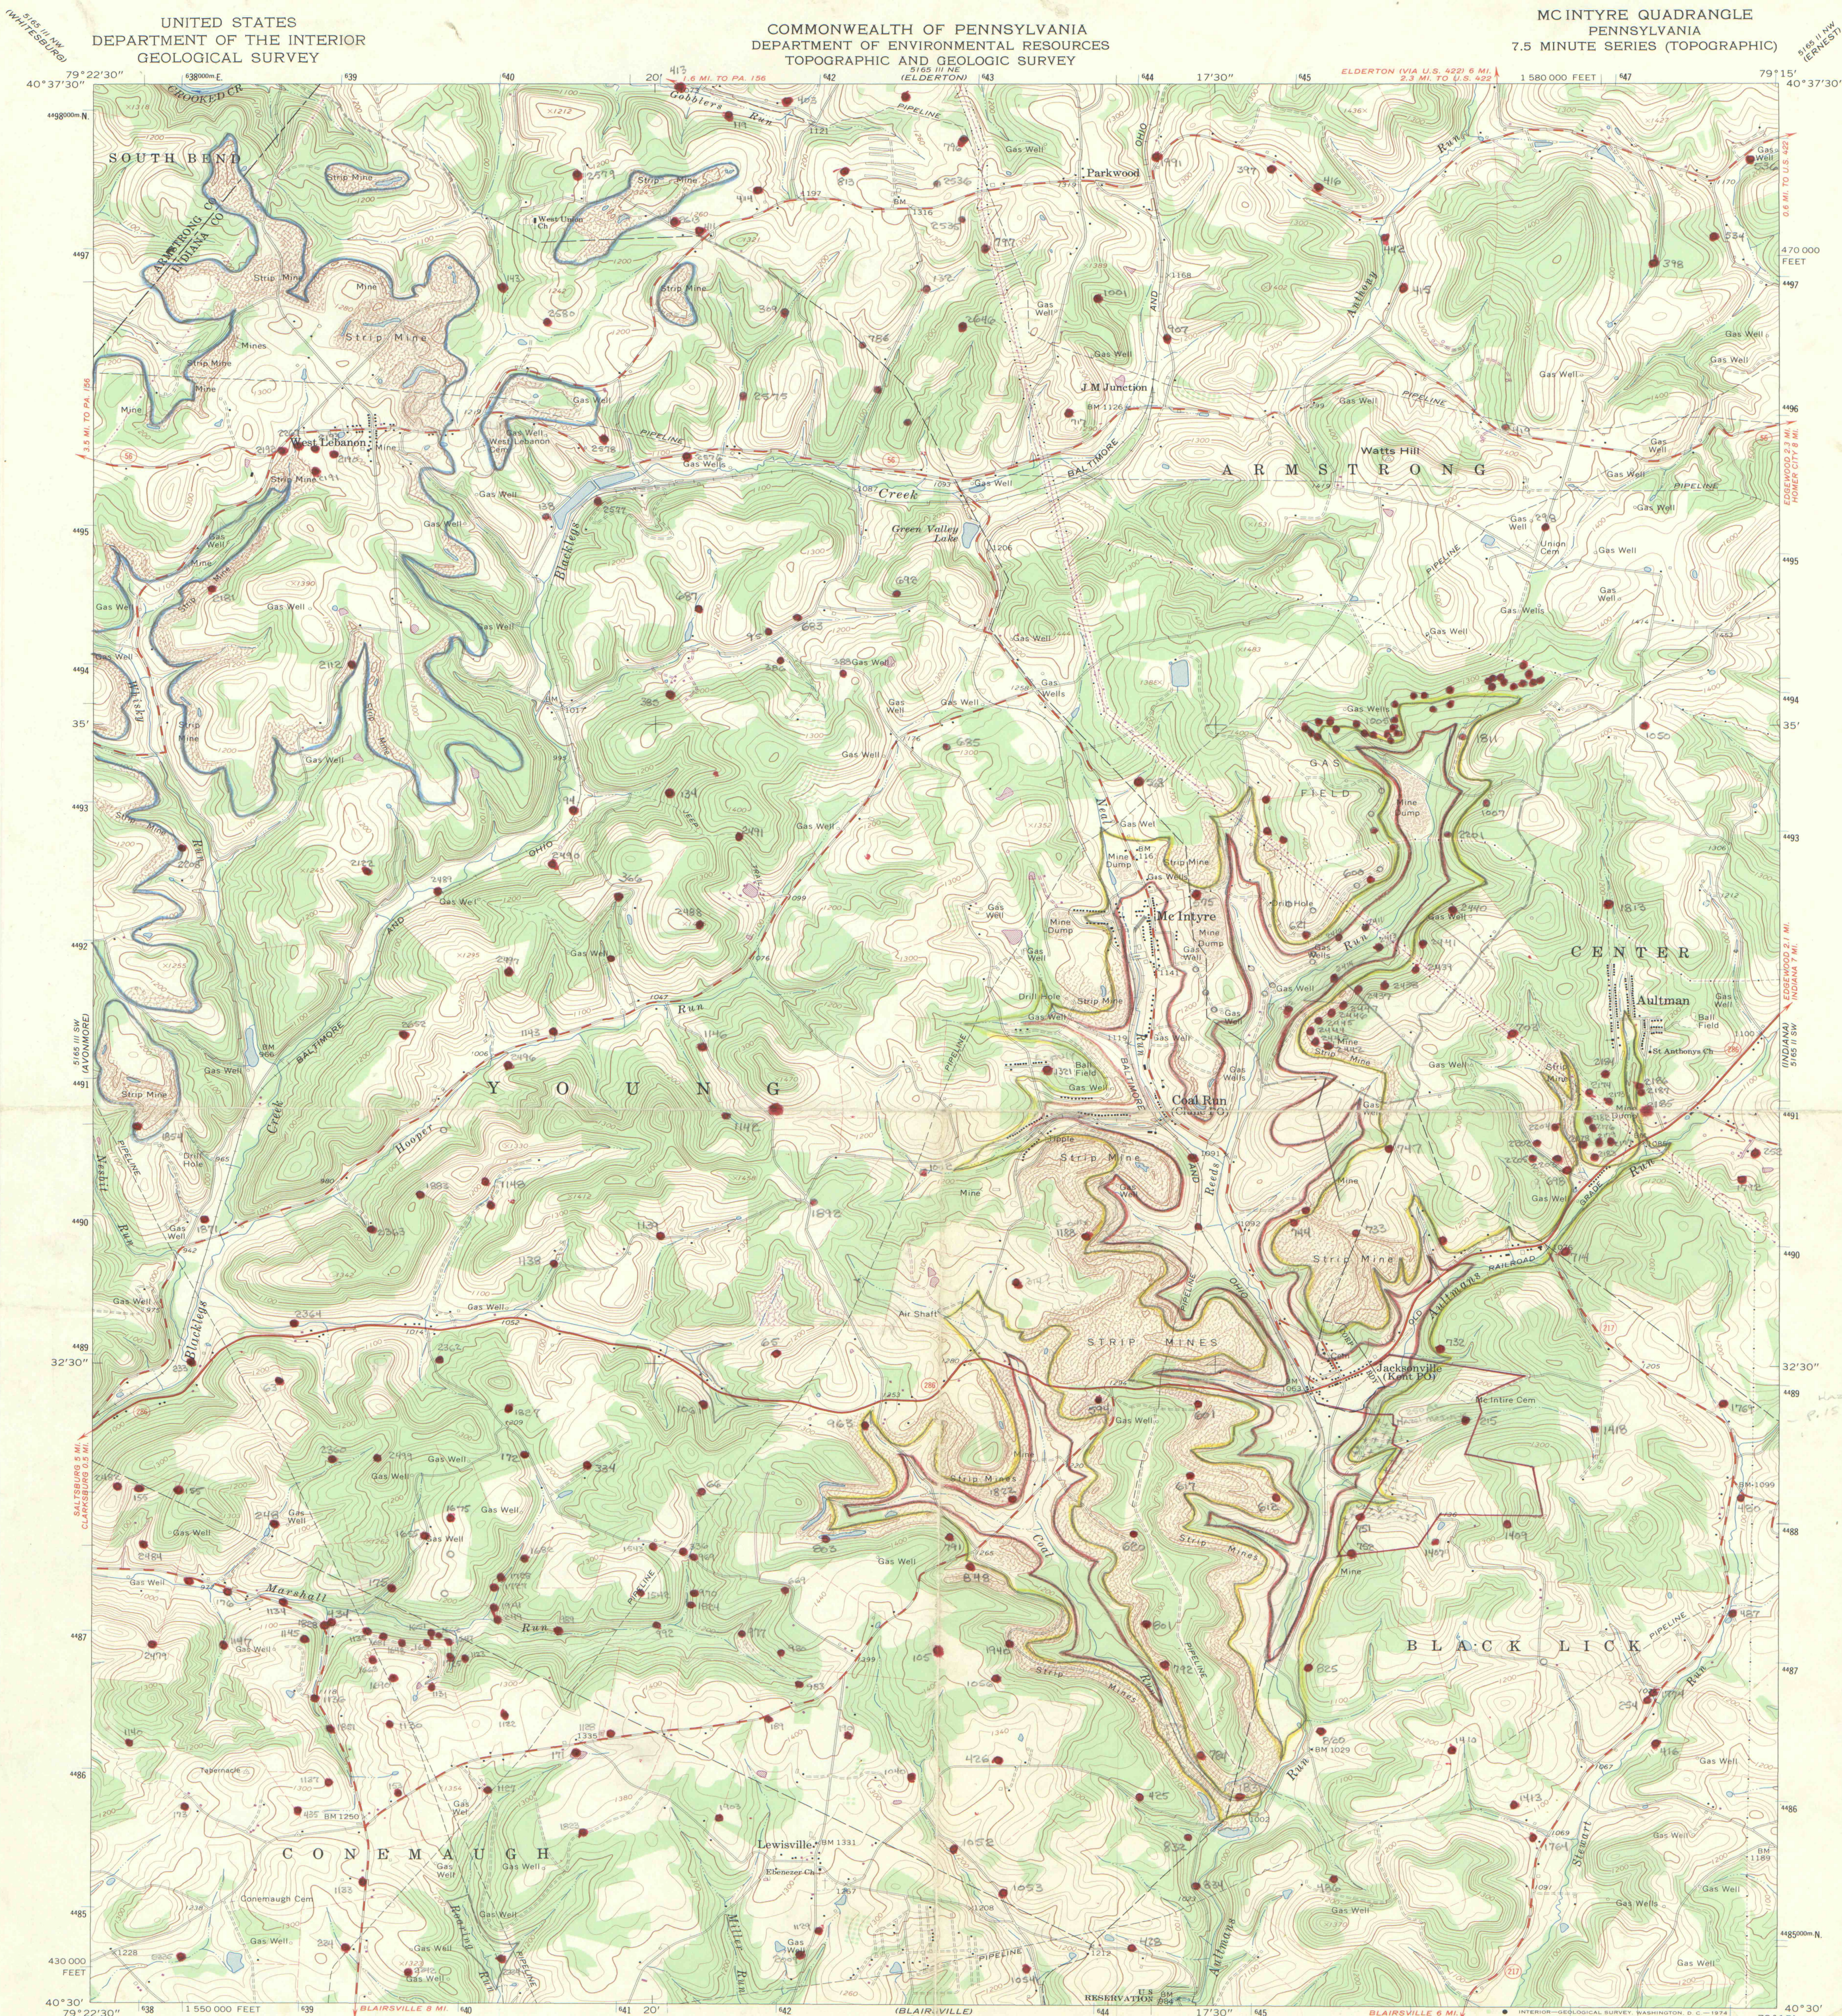



Mapped, edited, and published by the Geological Survey
Control by USGS, USCGS, and USCE

Topography by photogrammetric methods from aerial
photographs taken 1962 and 1963. Field checked 1964

Polyconic projection. 1927 North American datum
10,000-foot grid based on Pennsylvania coordinate system, south zone
1000-meter Universal Transverse Mercator grid ticks,
zone 17, shown in blue

Fine red dashed lines indicate selected fence and field lines where
generally visible on aerial photographs. This information is unchecked

U.S. Reservation boundary from maps by U.S. Corps of Engineers.
Area covered by dashed light-blue pattern is subject to controlled
inundation to 975 feet by Conemaugh Dam

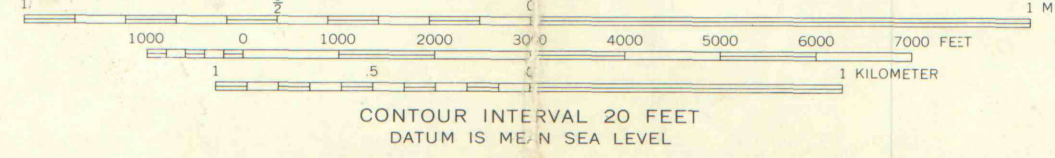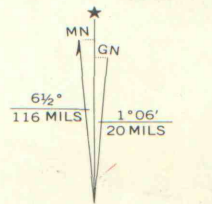

ROAD CLASSIFICATION

Heavy-duty	Light-duty
Medium-duty	Unimproved dirt
State Route	

D. Stadtmiller All Seam
MCINTYRE, PA.

N4030—W7915/7.5

THIS MAP COMPLIES WITH NATIONAL MAP ACCURACY STANDARDS
FOR SALE BY U.S. GEOLOGICAL SURVEY, WASHINGTON, D.C. 20242
A FOLDER DESCRIBING TOPOGRAPHIC MAPS AND SYMBOLS IS AVAILABLE ON REQUEST

Revisions shown in purple compiled in cooperation with
State of Pennsylvania agencies from aerial photographs
taken 1973. This information not field checked

1964
PHOTOREVISED 1973
AMS 5165 III SE—SERIES V831

1 MAPS # 09280