



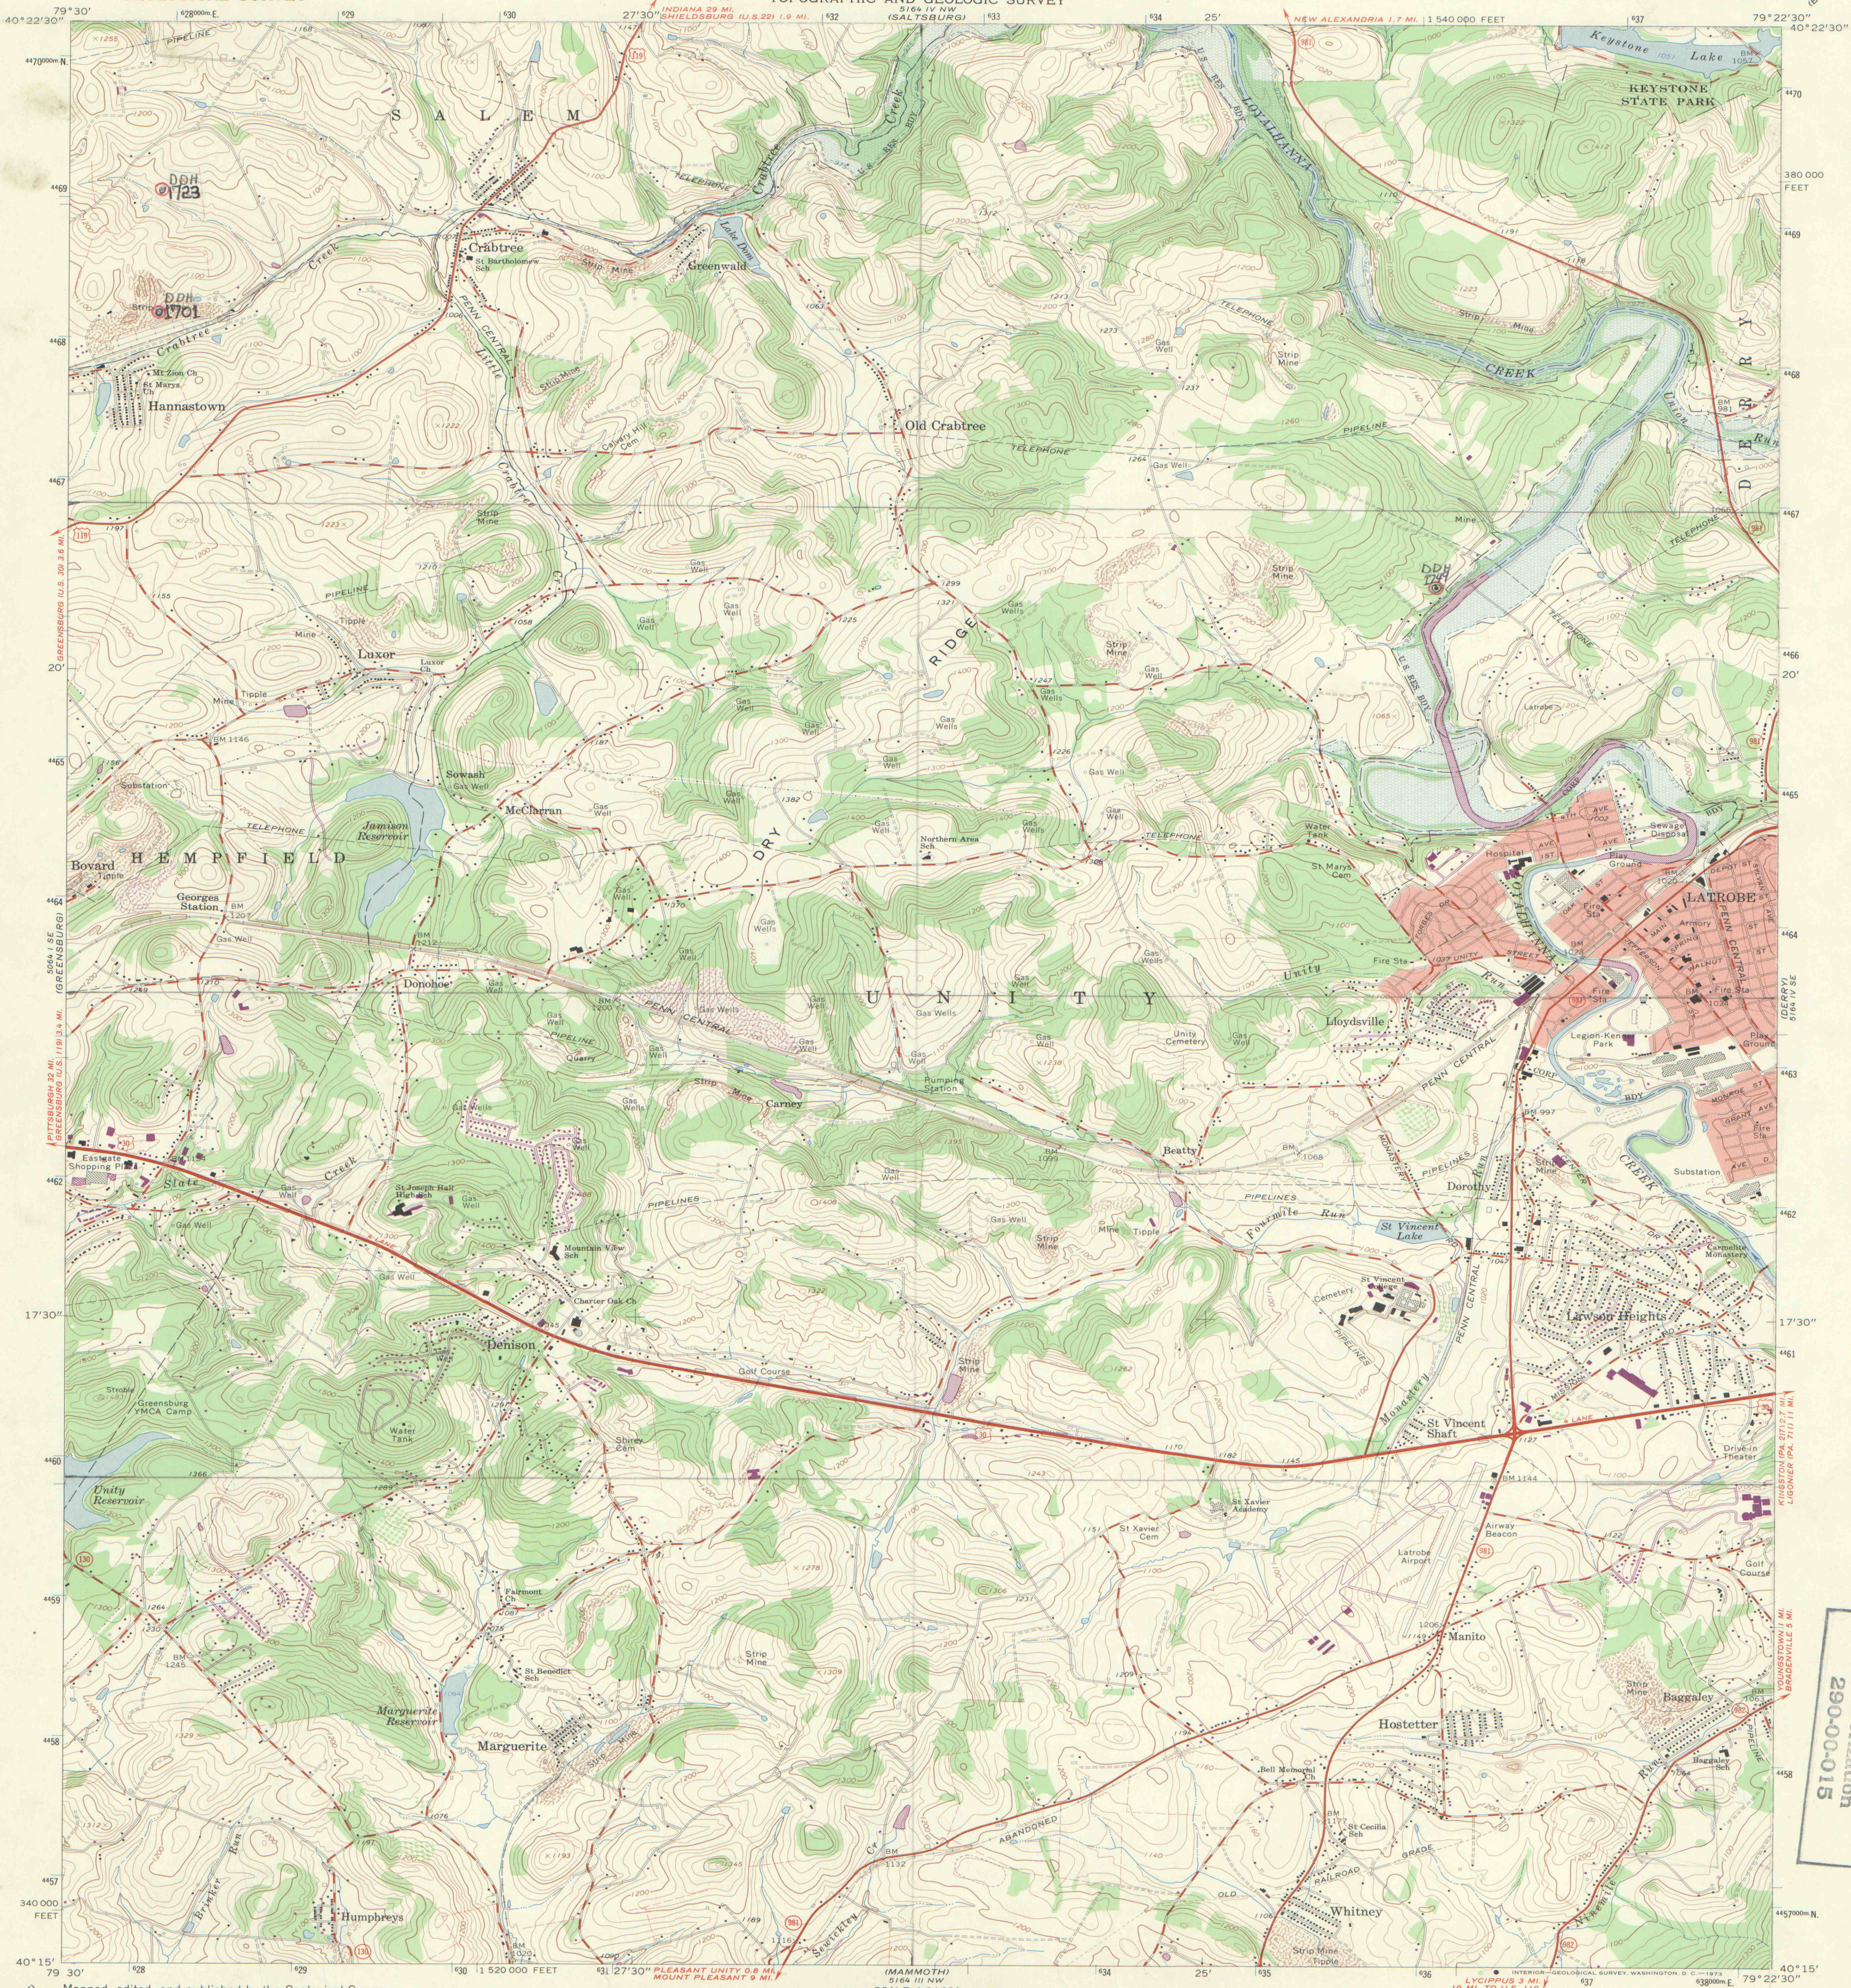

Exploration Services
Division
Authorization
290-00-015


Mapped, edited, and published by the Geological Survey
Control by USGS and USC&GS
Topography by photogrammetric methods from aerial
photographs taken 1962. Field checked 1964.
Polyconic projection. 1927 North American datum.
10,000-foot grid based on Pennsylvania coordinate system, south zone
1000-meter Universal Transverse Mercator grid ticks,
zone 17, shown in blue.
Red tint indicates areas in which only landmark buildings are shown.
Fine red dashed lines indicate selected fence and field lines where
generally visible on aerial photographs. This information is unchecked.
Reservation boundary from maps by U. S. Corps of Engineers.
Areas covered by dashed light-blue pattern are subject to controlled
inundation by Loyalhanna Dam.

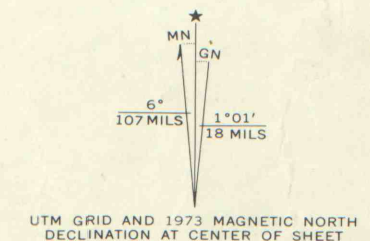

DIAMOND DRILL HOLE
Location Maps
A-02

4-7-C

NOT TO BE TAKEN FROM OFFICE

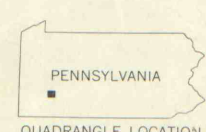

ROAD CLASSIFICATION
Heavy-duty ——— Light-duty ———
Medium-duty ——— Unimproved dirt ———
U.S. Route ——— State Route ———

LATROBE, PA.
N4015—W7922.5/7.5

1964
PHOTOREVISED 1973
AMS 5164 IV SW-SERIES 9831

Revisions shown in purple compiled in cooperation with
State of Pennsylvania agencies from aerial photographs
taken 1973. This information not field checked.