




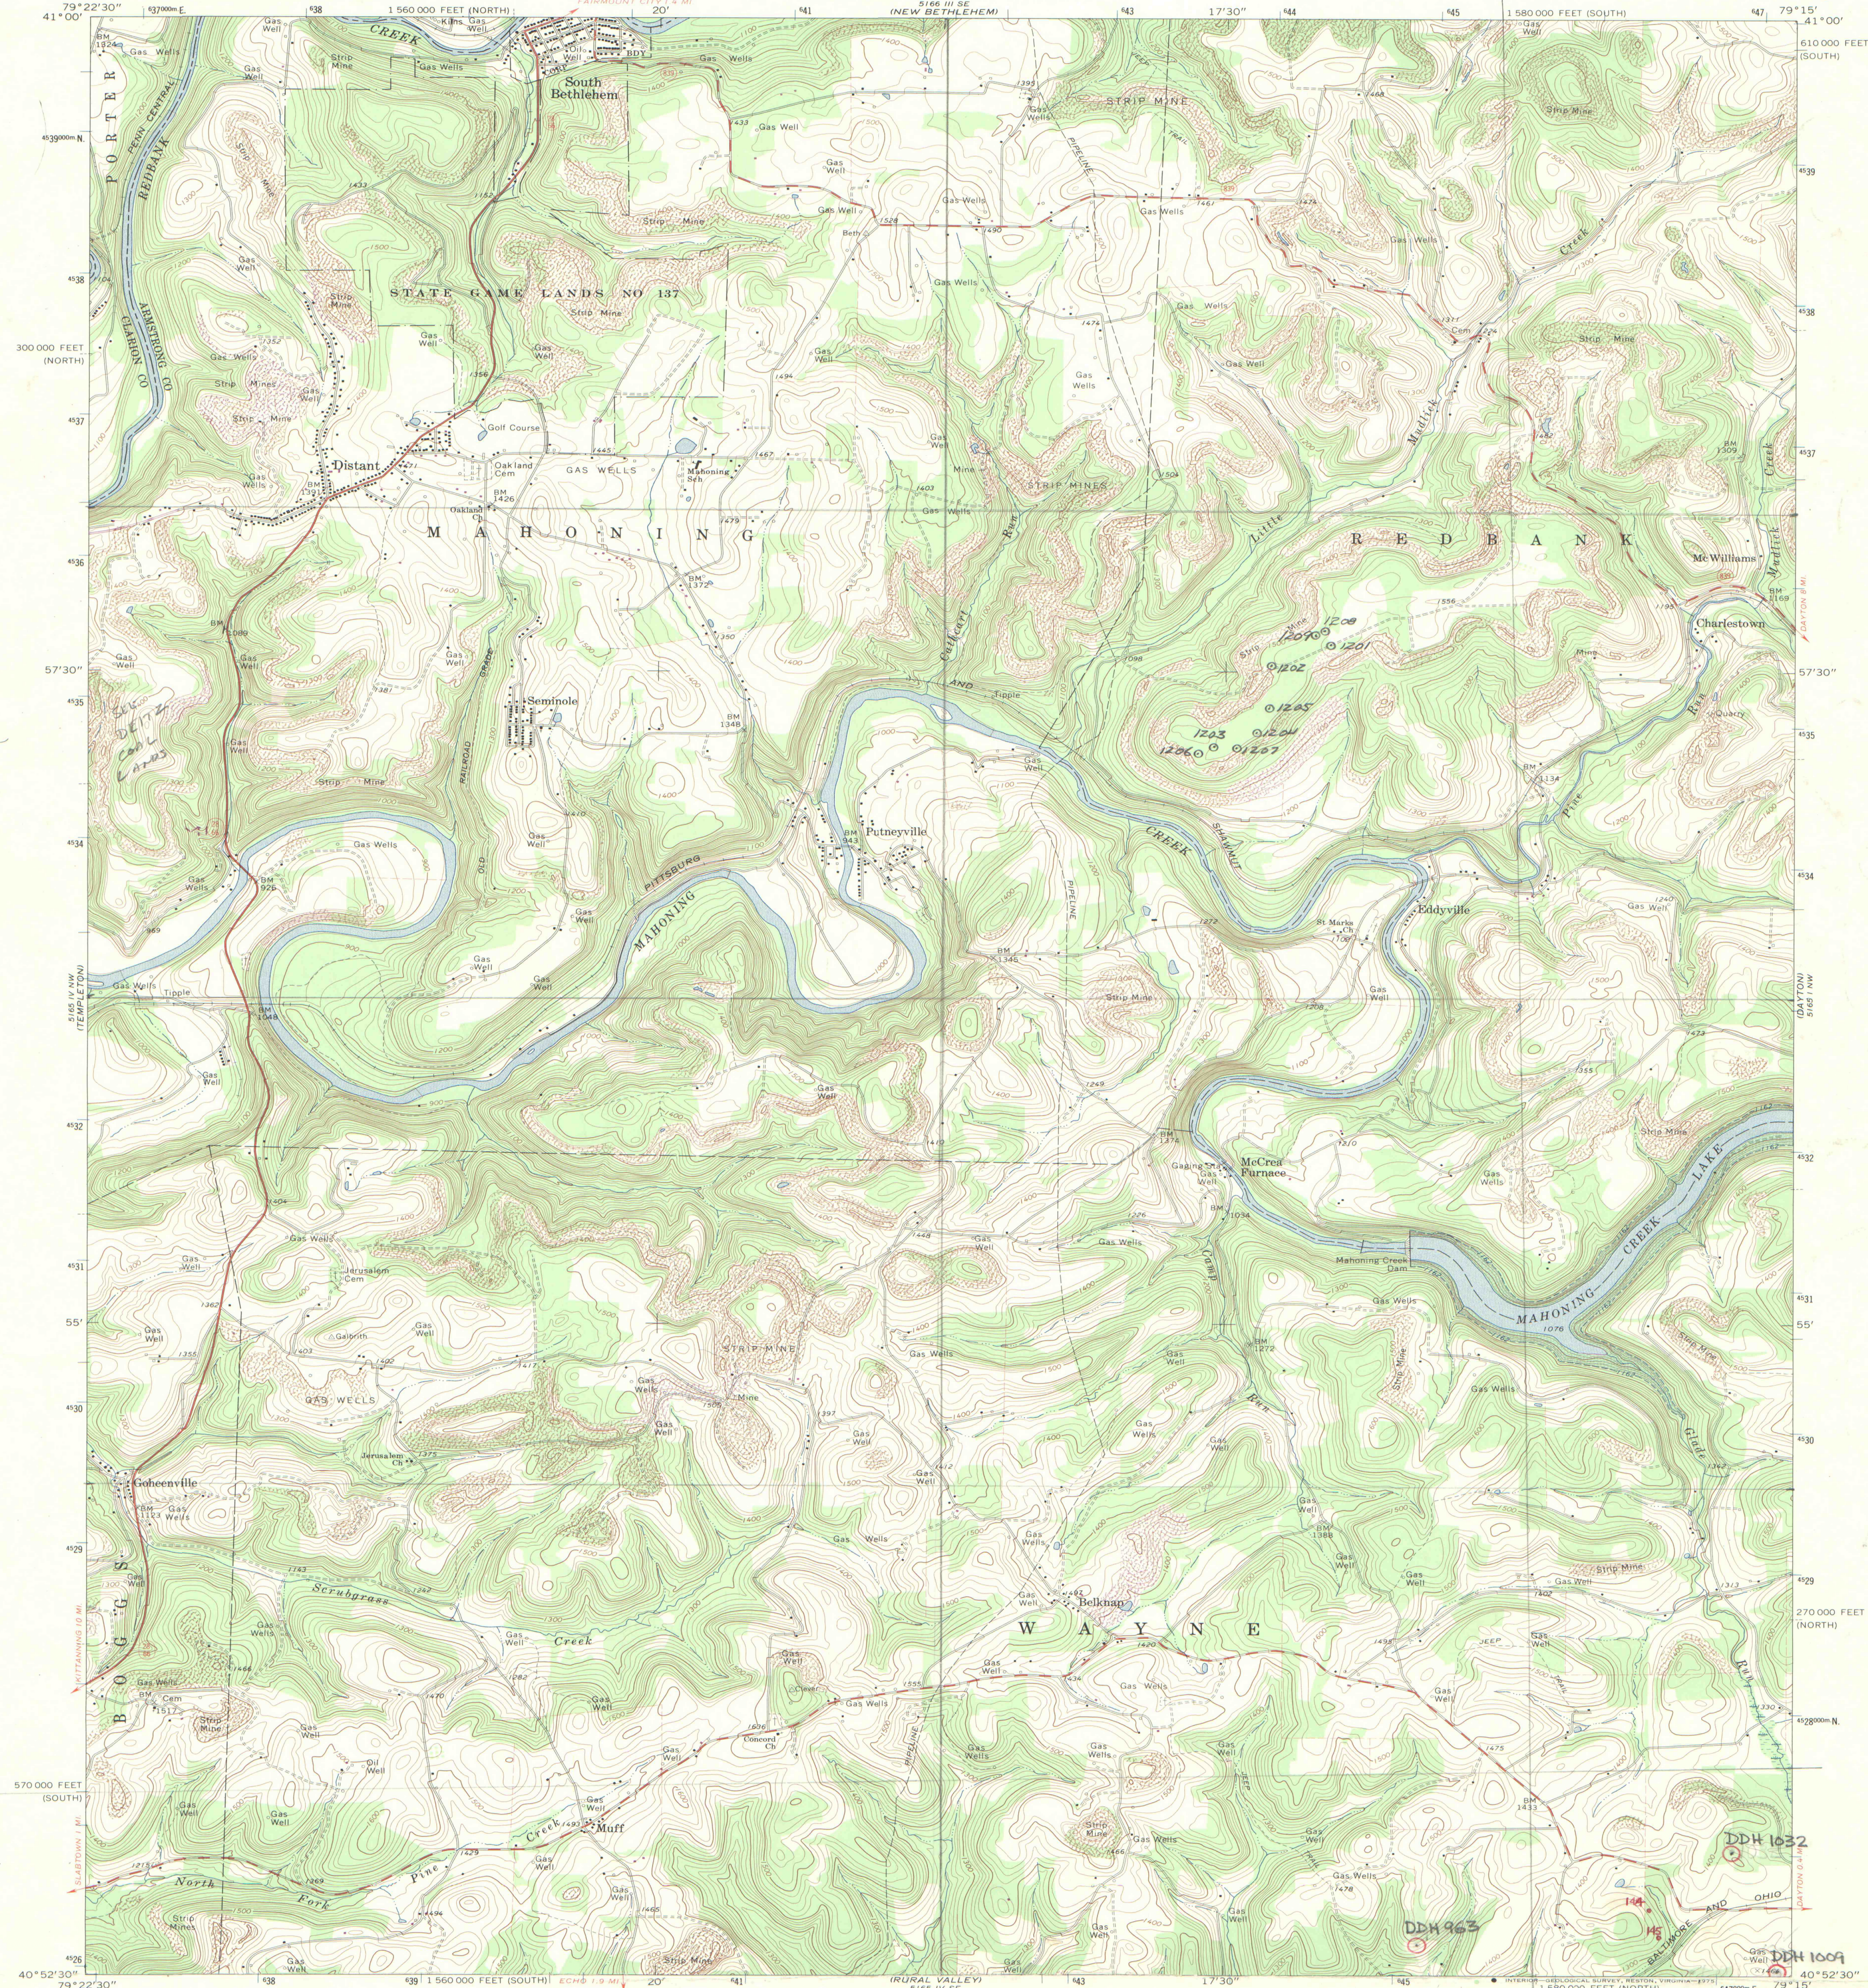

Mapped, edited, and published by the Geological Survey
Control by USGS and US&GS
Topography by photogrammetric methods from aerial
photographs taken 1966 and 1967. Field checked 1969
Polyconic projection. 1927 North American datum
10,000-foot grids based on Pennsylvania coordinate system,
south and north zones
1000-meter Universal Transverse Mercator grid ticks,
zone 17, shown in blue
Fine red dashed lines indicate selected fence and field lines where
generally visible on aerial photographs. This information is unchecked
Area covered by dashed light-blue pattern is subject to controlled inundation
Revisions shown in purple compiled in cooperation with
State of Pennsylvania agencies from aerial photographs
taken 1973. This information not field checked

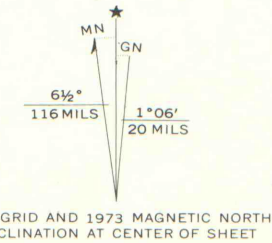

DIAMOND DRILL HOLE
Location Maps
A-02
4-5-B
NOT TO BE TAKEN FROM OFFICE

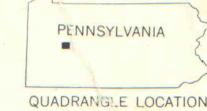

ROAD CLASSIFICATION
Primary highway, hard surface
Secondary highway, hard surface
Light-duty road, hard or improved surface
Unimproved road
Interstate Route
U. S. Route
State Route
DISTANT, PA.
N4052.5-W7915.7.5
1969
PHOTOREVISED 1973
AMS 5165 IV NE-SERIES V831

IMAPS#09293