


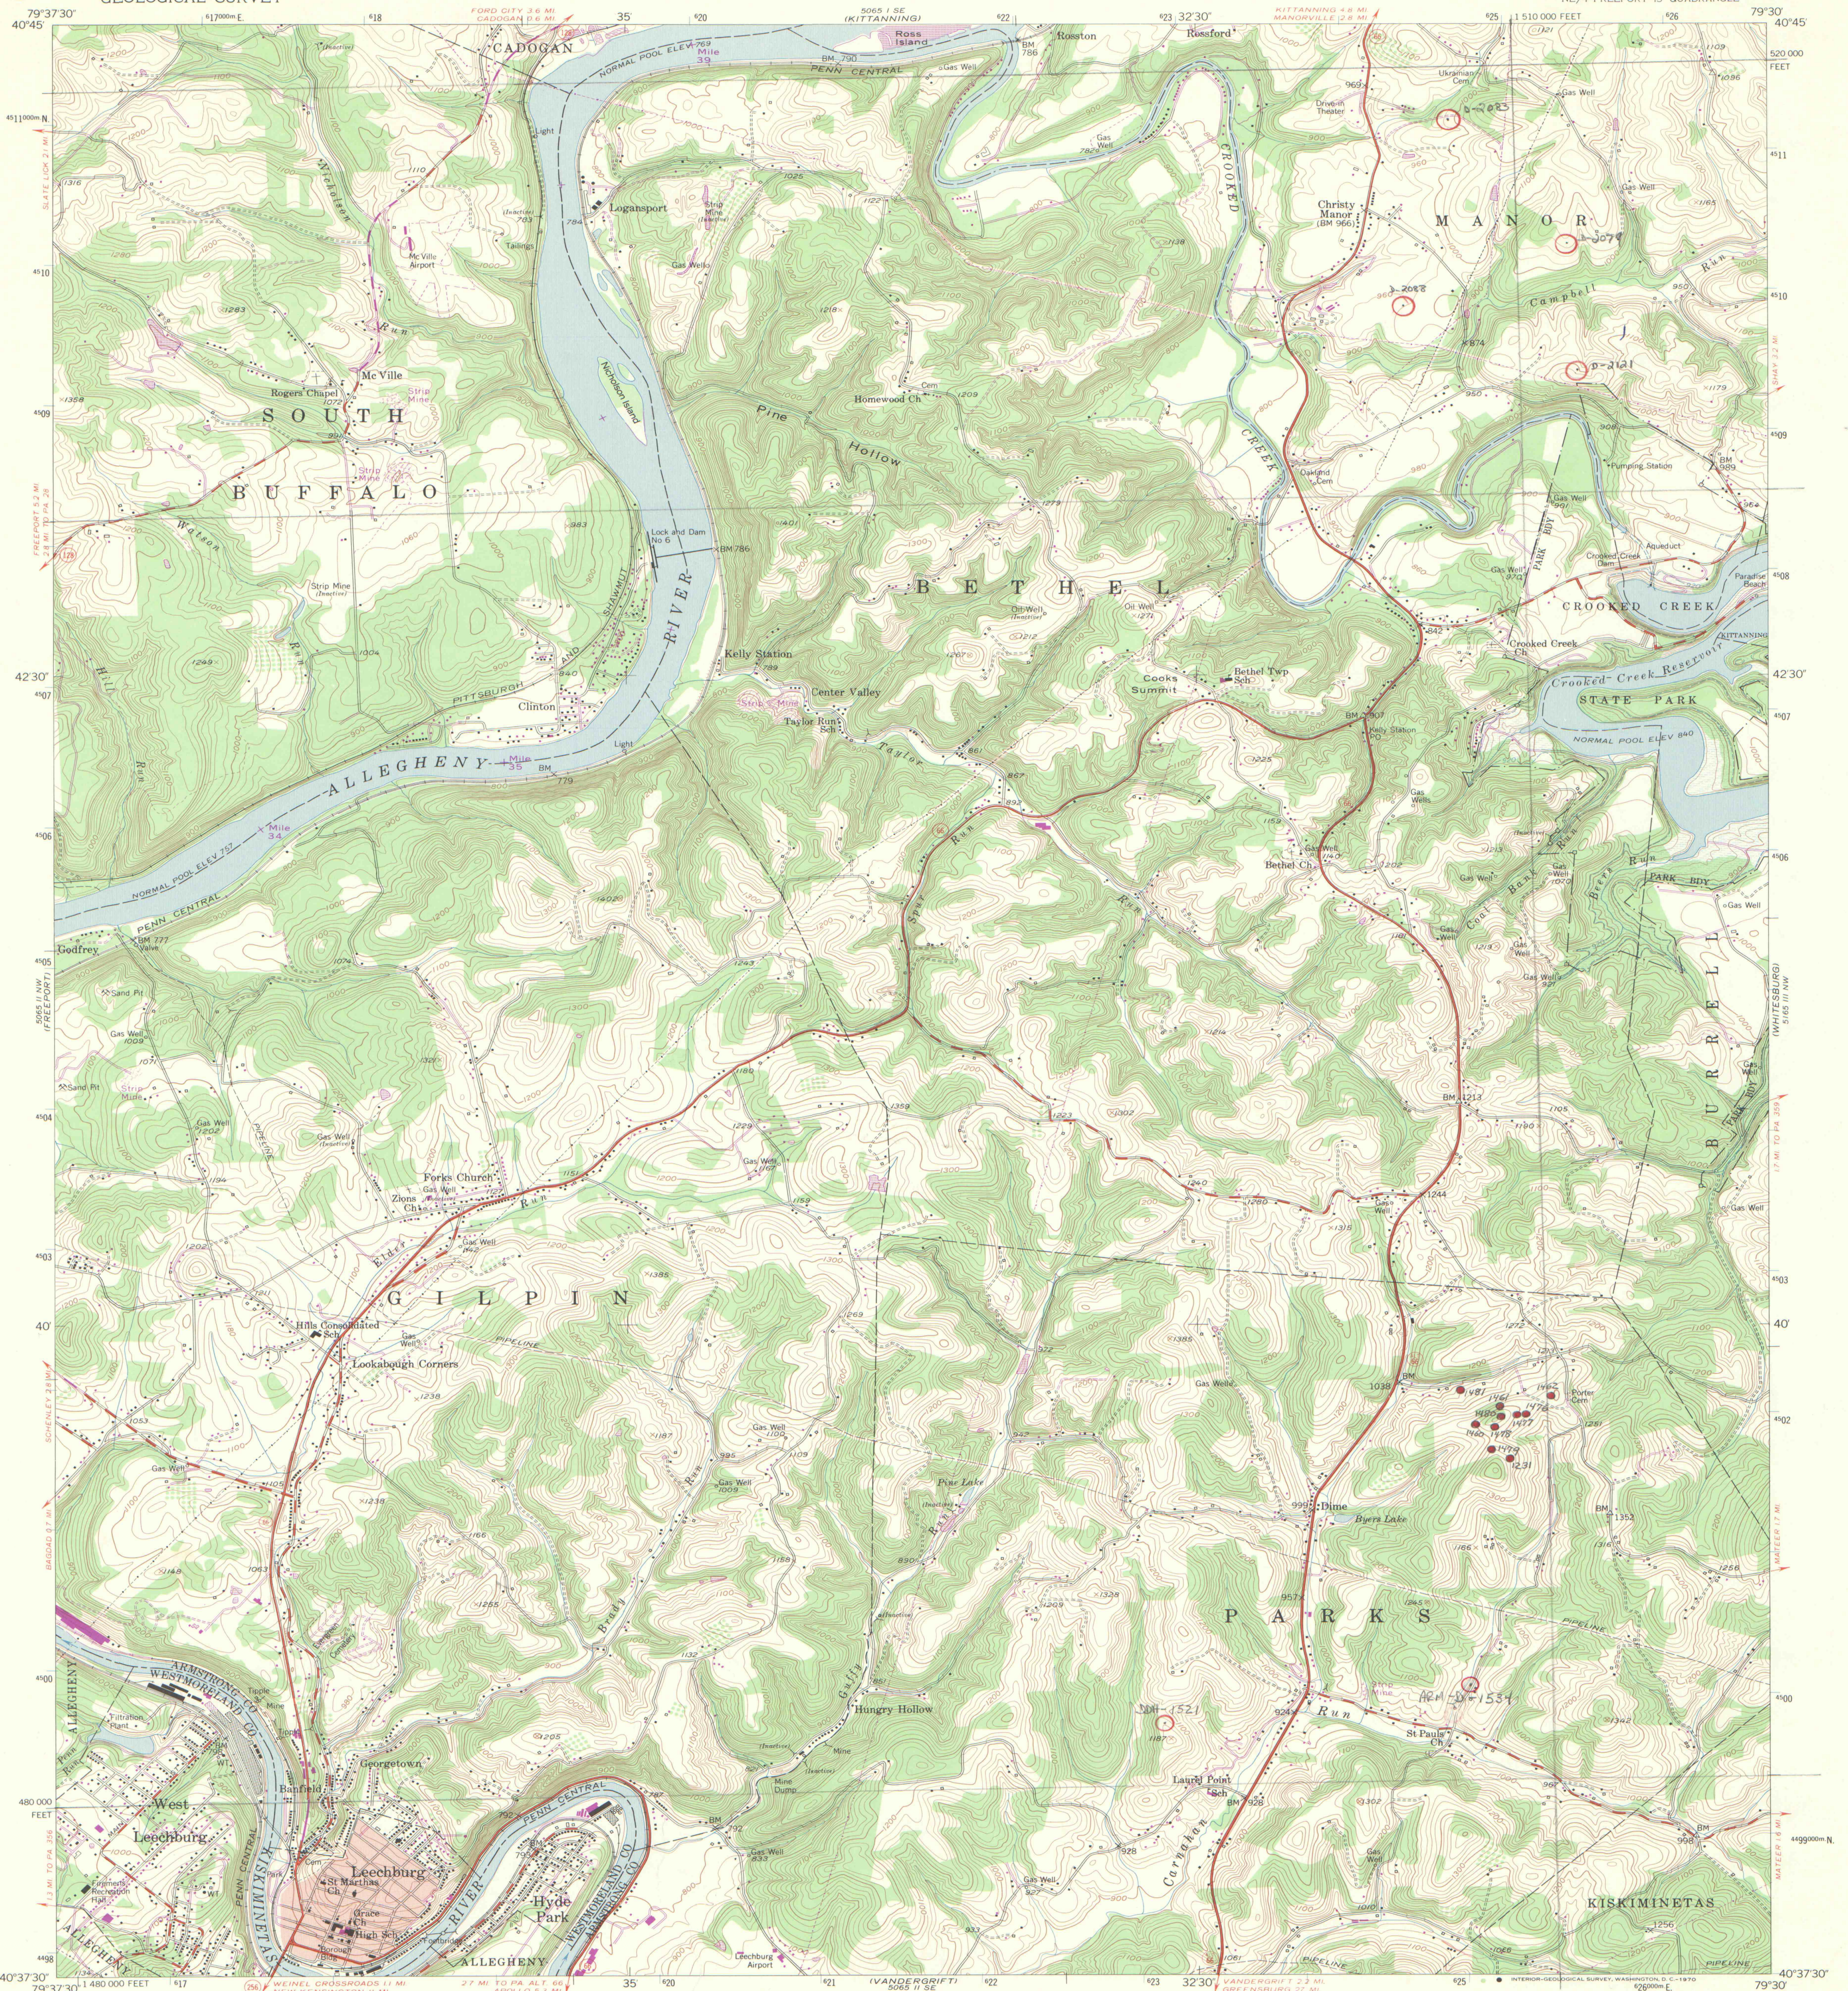

Mapped, edited, and published by the Geological Survey
Control by USGS and USC&GS

Topography from aerial photographs by multiplex methods
Aerial photographs taken 1952. Field check 1954

Polyconic projection. 1927 North American datum
10,000-foot grid based on Pennsylvania coordinate system, south zone
1000-meter Universal Transverse Mercator grid ticks, zone 17,
shown in blue

Red tint indicates area in which only landmark buildings are shown
Area covered by dashed light-blue pattern
is subject to controlled inundation

Revisions shown in purple compiled in cooperation with
State of Pennsylvania agencies from aerial photographs taken 1969
This information not field checked

UTM GRID AND 1969 MAGNETIC NORTH
DECLINATION AT CENTER OF SHEET

SCALE 1:24000

ROAD CLASSIFICATION
Heavy-duty ——— Light-duty ———
Medium-duty ——— Unimproved dirt ———
State Route

LEECHBURG, PA.
NE/4 FREEPORT 15' QUADRANGLE
N4037.5-W7930/7.5

1954
PHOTOGRAPHED 1969
AMS 5065 II NE-SERIES V831

DDH LOCATION
Office Copy
A-04
NOT TO BE TAKEN FROM OFFICE

PENNSYLVANIA
QUADRANGLE LOCATION

IMAPS # 09294