



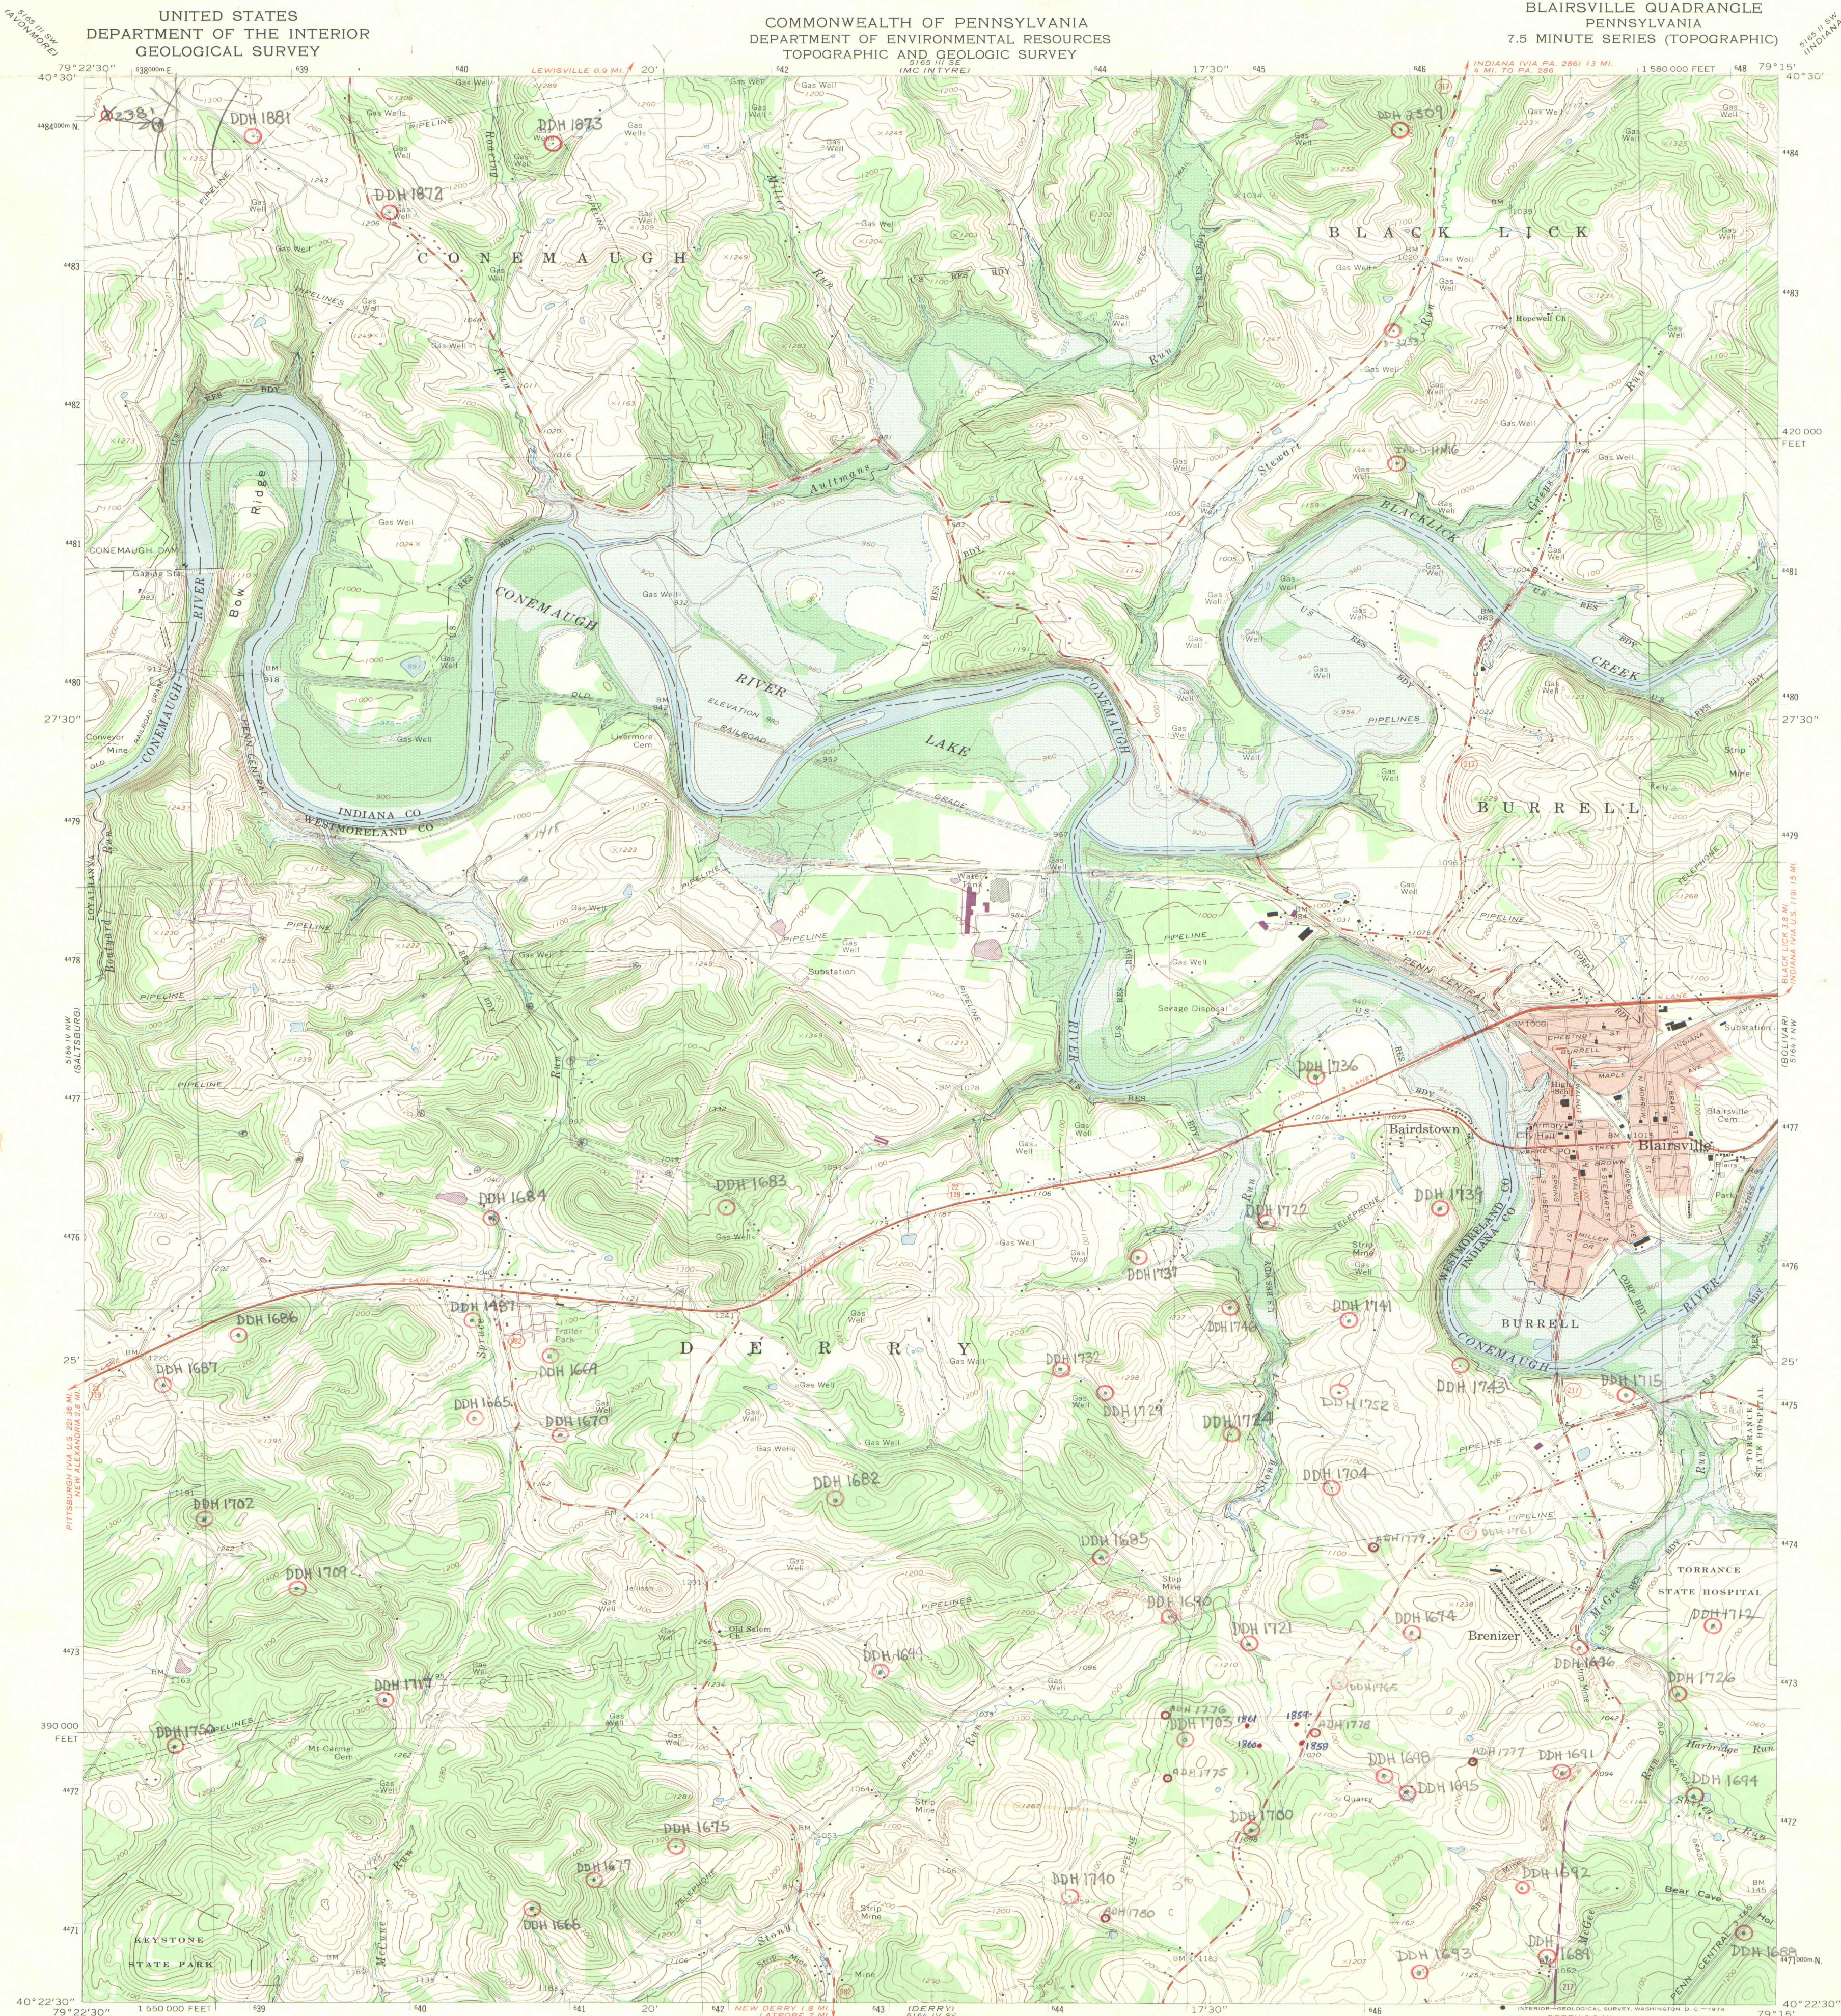

Mapped, edited, and published by the Geological Survey
Control by USGS and USC&GS
Topography by photogrammetric methods from aerial photographs
taken 1962. Field checked 1964
Polyconic projection. 1927 North American datum
10,000-foot grid based on Pennsylvania coordinate system, south zone
1000-meter Universal Transverse Mercator grid ticks,
zone 17, shown in blue
Fine red dashed lines indicate selected fence and field lines where
generally visible on aerial photographs. This information is unchecked
Red tint indicates areas in which only landmark buildings are shown
U.S. Reservation boundary from maps by U.S. Corps of Engineers
Areas covered by dashed light-blue pattern are subject to controlled
inundation

UTM GRID AND 1973 MAGNETIC NORTH
DECLINATION AT CENTER OF SHEET

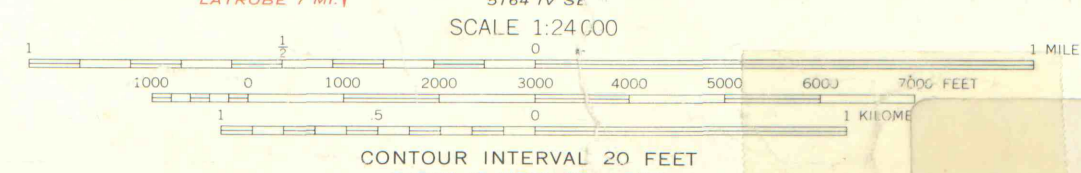

DIAMOND DRILL HOLE
Location Maps
A-02
4-7-8

NOT TO BE TAKEN FROM OFFICE

ROAD CLASSIFICATION
Heavy-duty ——— Light-duty ———
Unimproved dirt ———
U.S. Route ——— State Route ———

BLAIRSVILLE, PA.
N4022.5—W7915.7/5

1964
PHOTOREVISED 1973
AMS 5164 IV NE—SERIES V831

1MAPS# 09295