


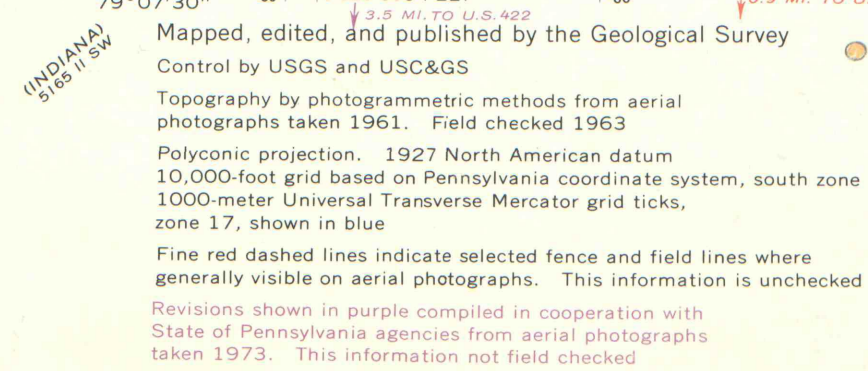

SCALE 1:24 000

1 MILE

0 1000 2000 3000 4000 5000 6000 7000 FEET

0 .5 1 KILOMETER

NOT TO BE TAKEN FROM OFFICE

CLYMER, PA.

N4037.5—W7900/7.5  
1963  
PHOTOREVISED 1973  
AMS 5165 II NE—SERIES V831