


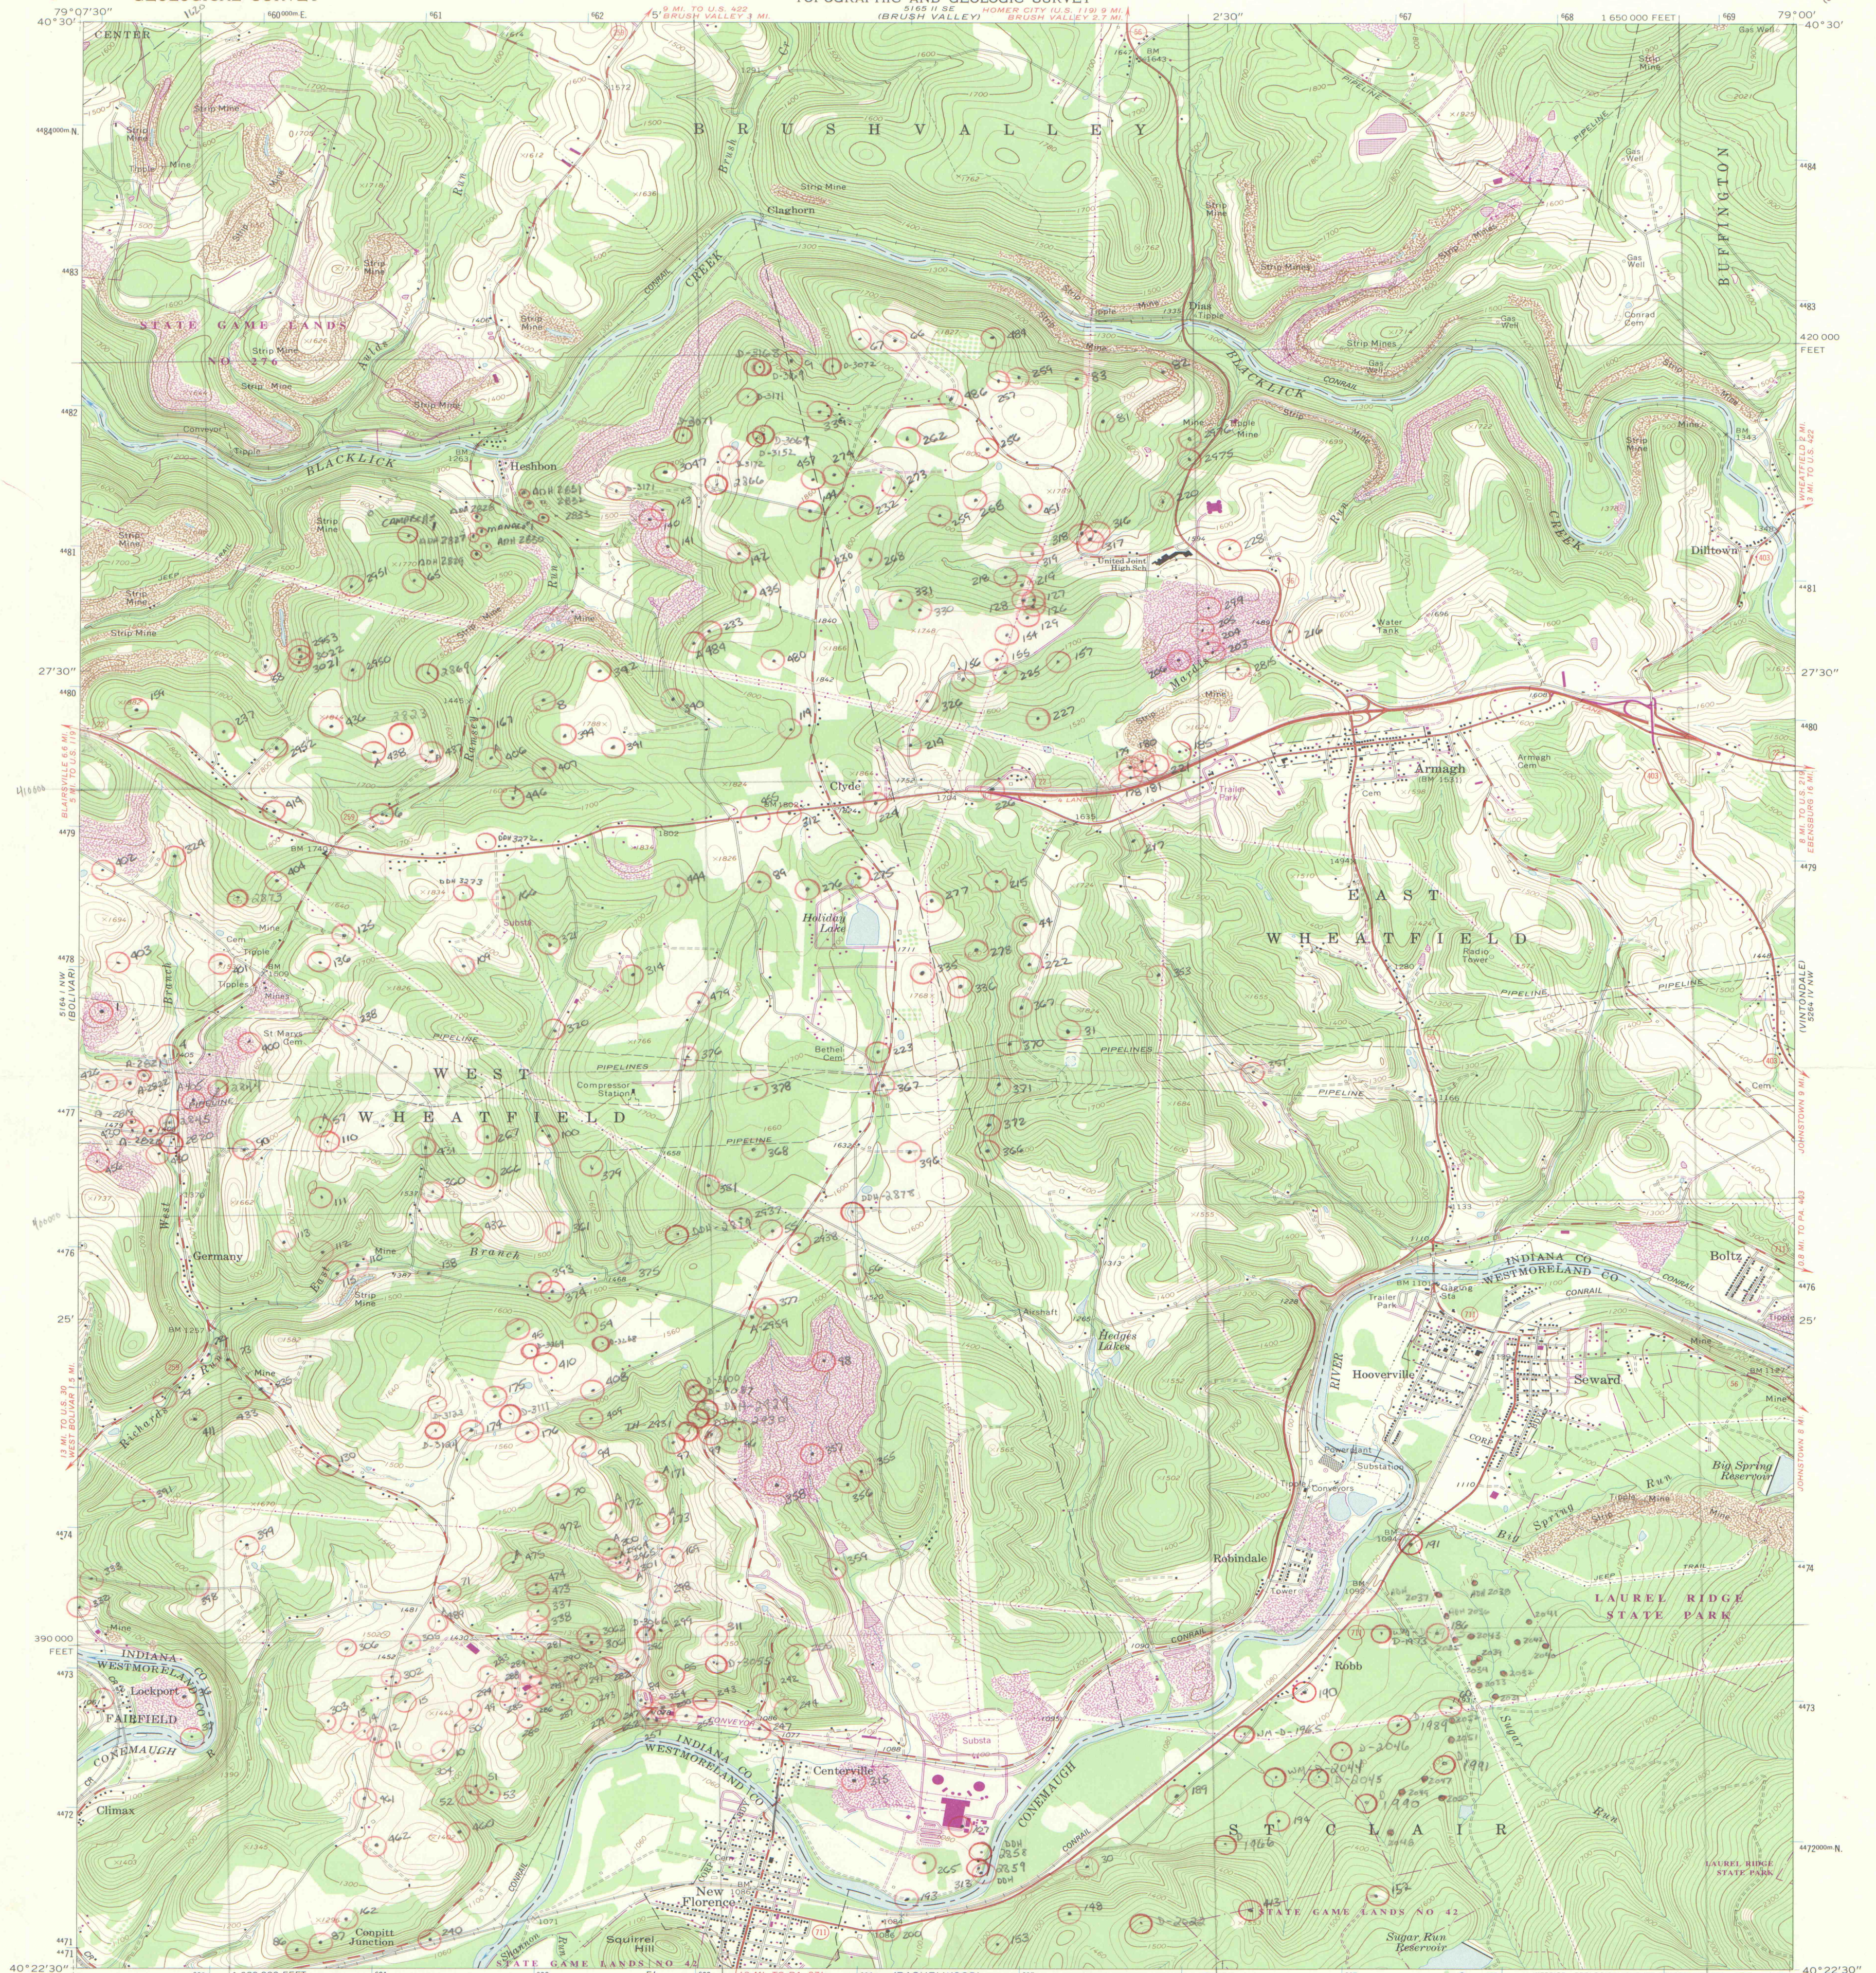


Mapped, edited, and published by the Geological Survey
Control by USGS and NOS/NOAA

Topography by photogrammetric methods from aerial photographs
taken 1962. Field checked 1964

Polyconic projection. 10,000-foot grid ticks based on Pennsylvania
coordinate system, south zone. 1000-meter Universal Transverse
Mercator grid ticks, zone 17, shown in blue. 1927 North
American Datum. To place on the predicted North American
Datum 1983 move the projection lines 4 meters south and
21 meters west as shown by dashed corner ticks

Fine red dashed lines indicate selected fence and field lines where
generally visible on aerial photographs. This information is unchecked

There may be private inholdings within the boundaries of
the National or State reservations shown on this map

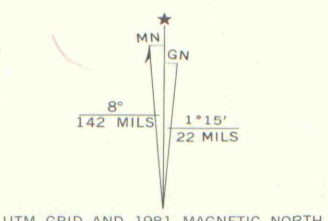

THIS MAP
FOR SALE
A FOLDER DESCRIBES

Diamond Drill Hole Location Map
Office Copy
A-02
NOT TO BE REMOVED FROM OFFICE
NOTE: MOST HOLES ARE "FMC" HOLES
1-500



ROAD CLASSIFICATION	
Heavy-duty	Light-duty
Medium-duty	Unimproved dirt
U.S. Route	State Route

NEW FLORENCE, PA.

N4022.5—W7900/7.5

1964
PHOTOREVISED 1981
DMA 5164 1 NE—SERIES V831

As shown in purple and woodland compiled in cooperation with
Pennsylvania agencies from aerial photographs taken 1977
and other sources. This information not field checked. Map edited 1981

IMAPS#09299