


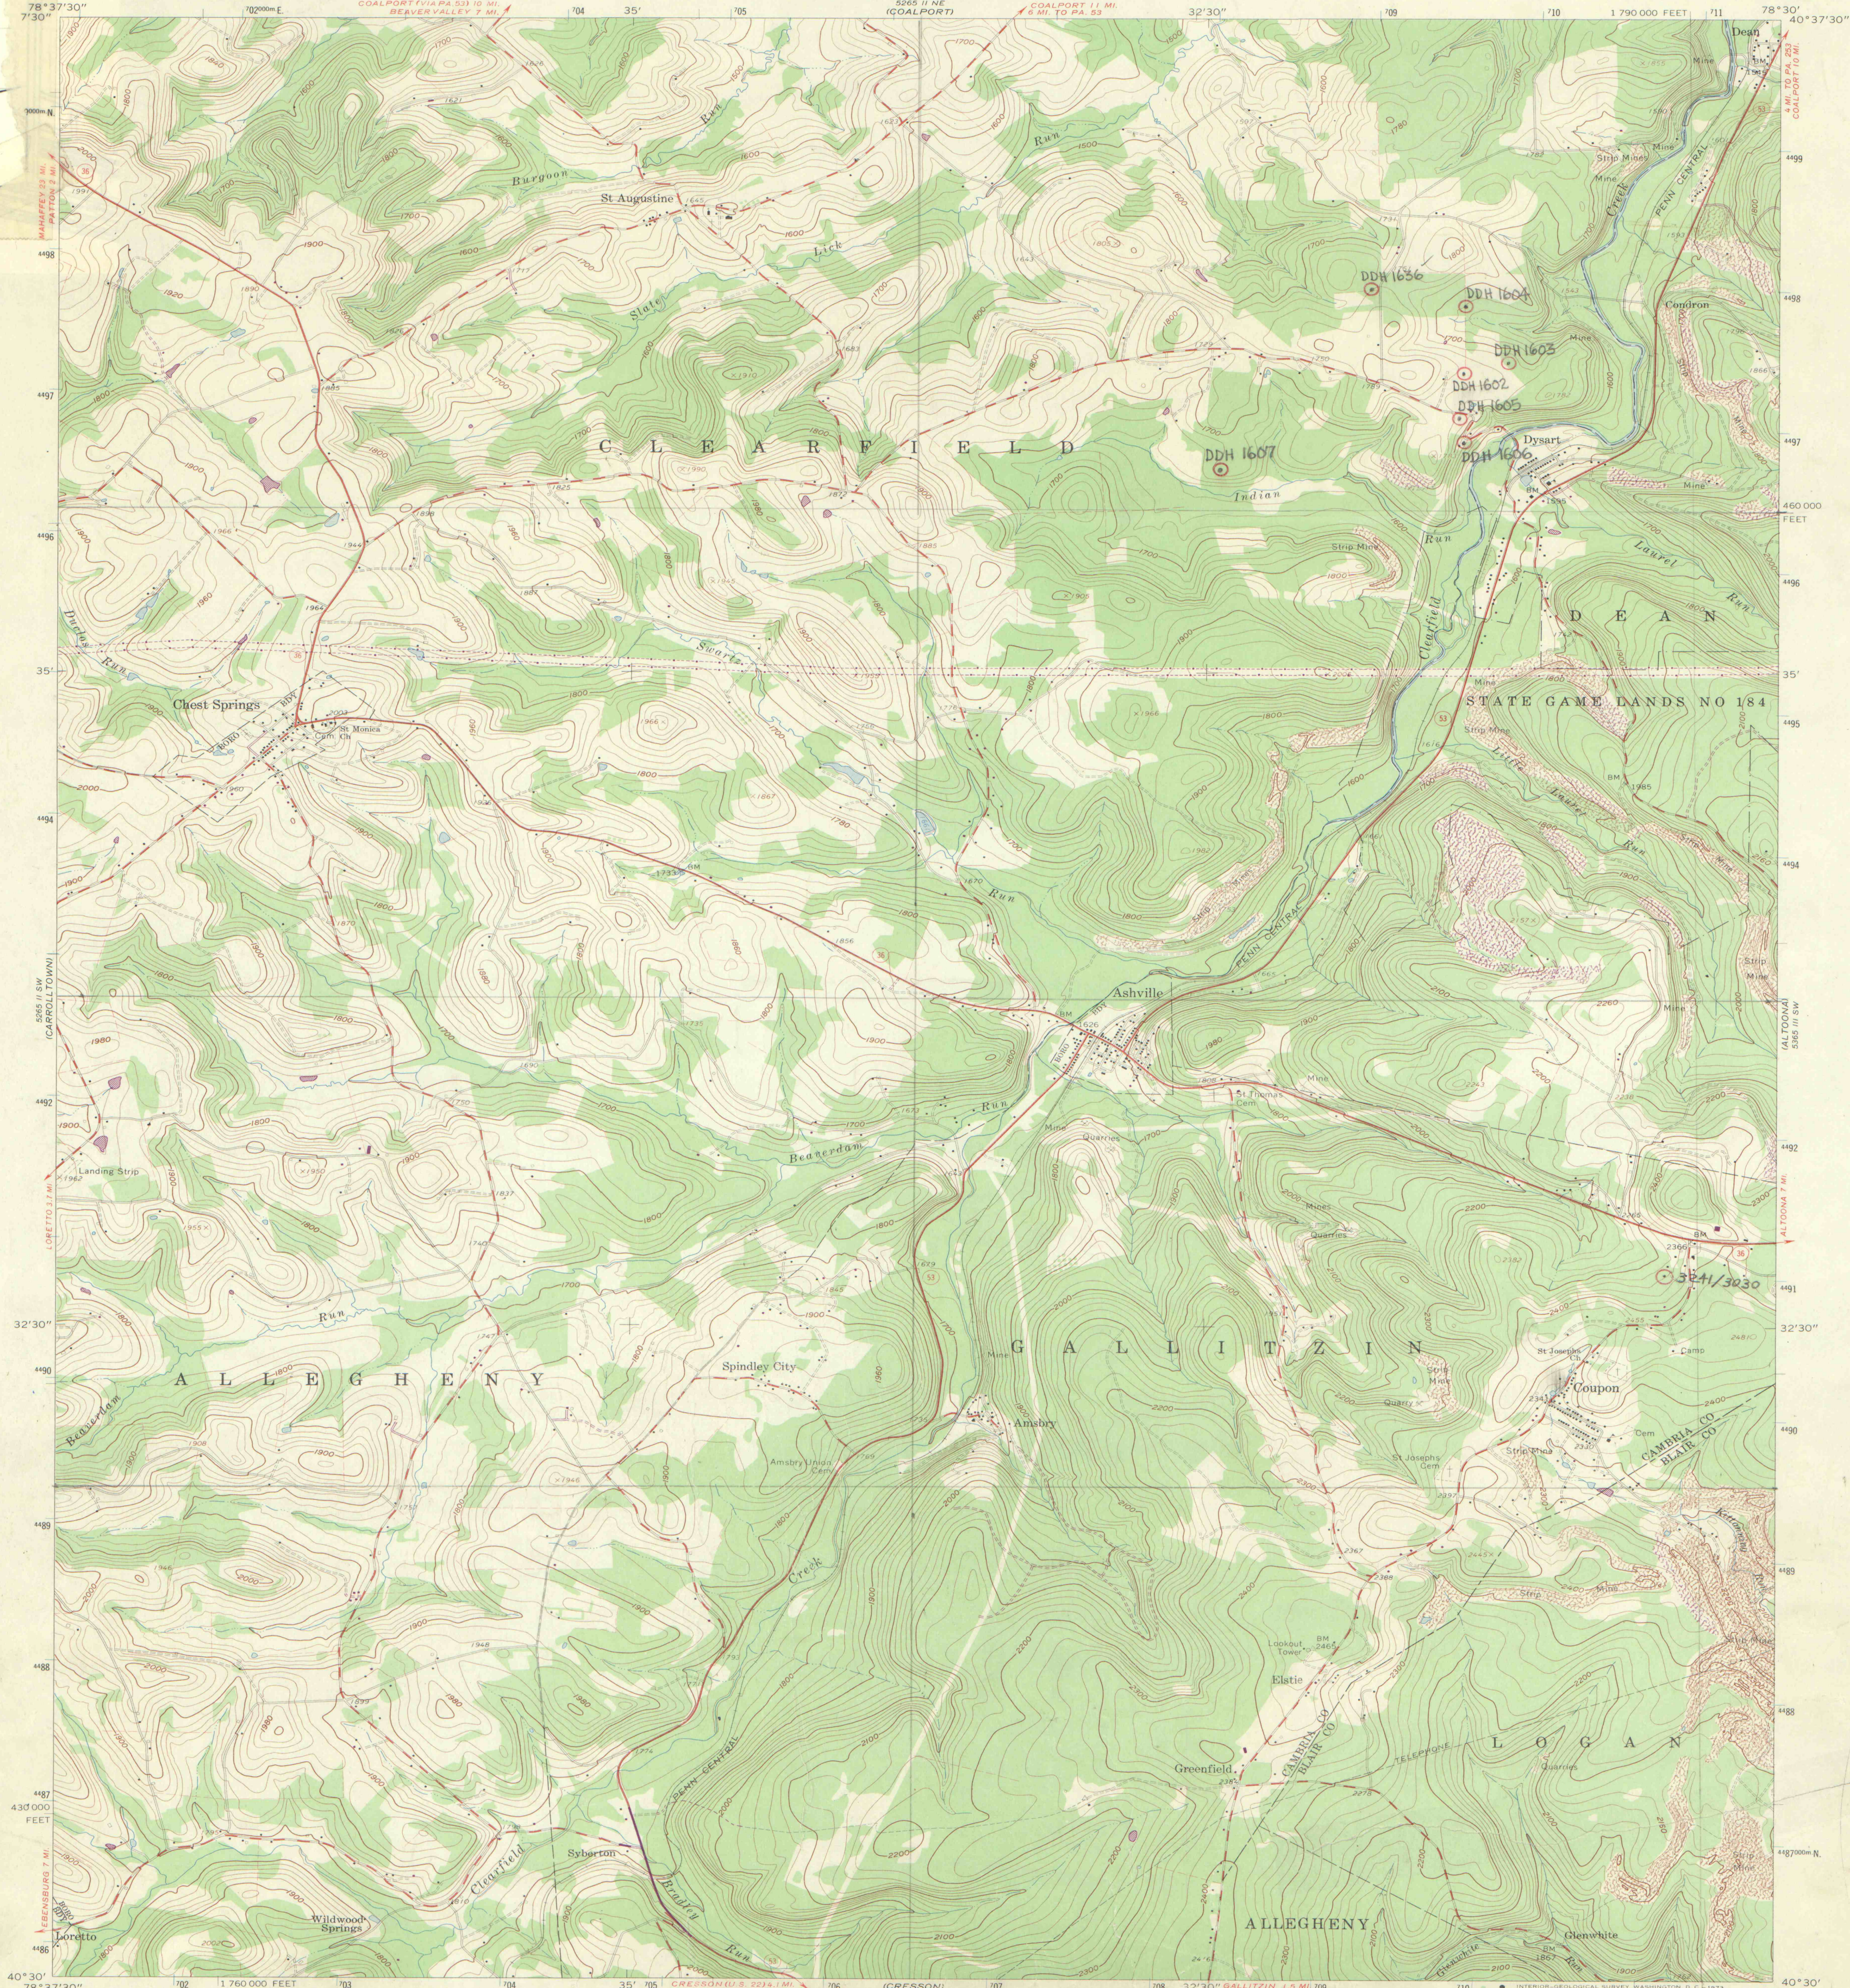

Mapped, edited, and published by the Geological Survey
Control by USGS and USC&GS
Topography by photogrammetric methods from aerial
photographs taken 1958. Field checked 1961
Polyconic projection. 1927 North American datum
10,000-foot grid based on Pennsylvania coordinate system,
south zone
1000-meter Universal Transverse Mercator grid ticks,
zone 17, shown in blue
Fine red dashed lines indicate selected fence and field lines where
generally visible on aerial photographs. This information is unchecked

UTM GRID AND 1972 MAGNETIC NORTH
DECLINATION AT CENTER OF SHEET

SCALE 1:24,000
1 1000 0 1000 2000 3000 4000 5000 6000 7000 FEET
1 MILE

DIAMOND DRILL HOLE
Location Maps
A-02
7-6-D
NOT TO BE TAKEN FROM OFFICE

ROAD CLASSIFICATION
Heavy-duty Light-duty
Medium-duty Unimproved dirt
State Route

ASHVILLE, PA.
N4030—W7830/7.5
1961
PHOTOREVISED 1972
AMS 5265 II SE—SERIES V82.1

Revisions shown in purple compiled in cooperation with
State of Pennsylvania agencies from aerial photographs
taken 1972. This information not field checked

IMAPS#09307