




Mapped, edited, and published by the Geological Survey  
Control by USGS, USC&GS, and USCE  
Topography by photogrammetric methods from aerial photographs  
taken 1962. Field checked 1964.  
Polyconic projection. 1927 North American datum  
10,000-foot grid based on Pennsylvania coordinate system, south zone  
1000-meter Universal Transverse Mercator grid ticks, zone 17,  
shown in blue  
Fine red dashed lines indicate selected fence and field lines where  
generally visible on aerial photographs. This information is unchecked  
U.S. Reservation boundary from maps by U.S. Corps of Engineers  
Areas covered by dashed light-blue pattern are subject to controlled  
inundation by Conemaugh Dam

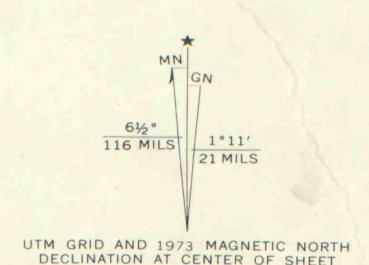

SCALE 1:24,000  
DIAMOND DRILL HOLE  
Location Maps  
A-02  
5-7A  
NOT TO BE TAKEN FROM OFFICE

ROAD CLASSIFICATION  
Heavy-duty ——— Light-duty ———  
Medium-duty ——— Unimproved dirt ———  
U.S. Route ——— State Route ———  
BOLIVAR, PA.  
N4922.5—W7907.5/7.5  
1964  
PHOTOREVISED 1973  
AMS 5164 1 NW—SERIES V831

Exploration Services  
Division  
Authorization  
290-00-015

60360#J50W1