


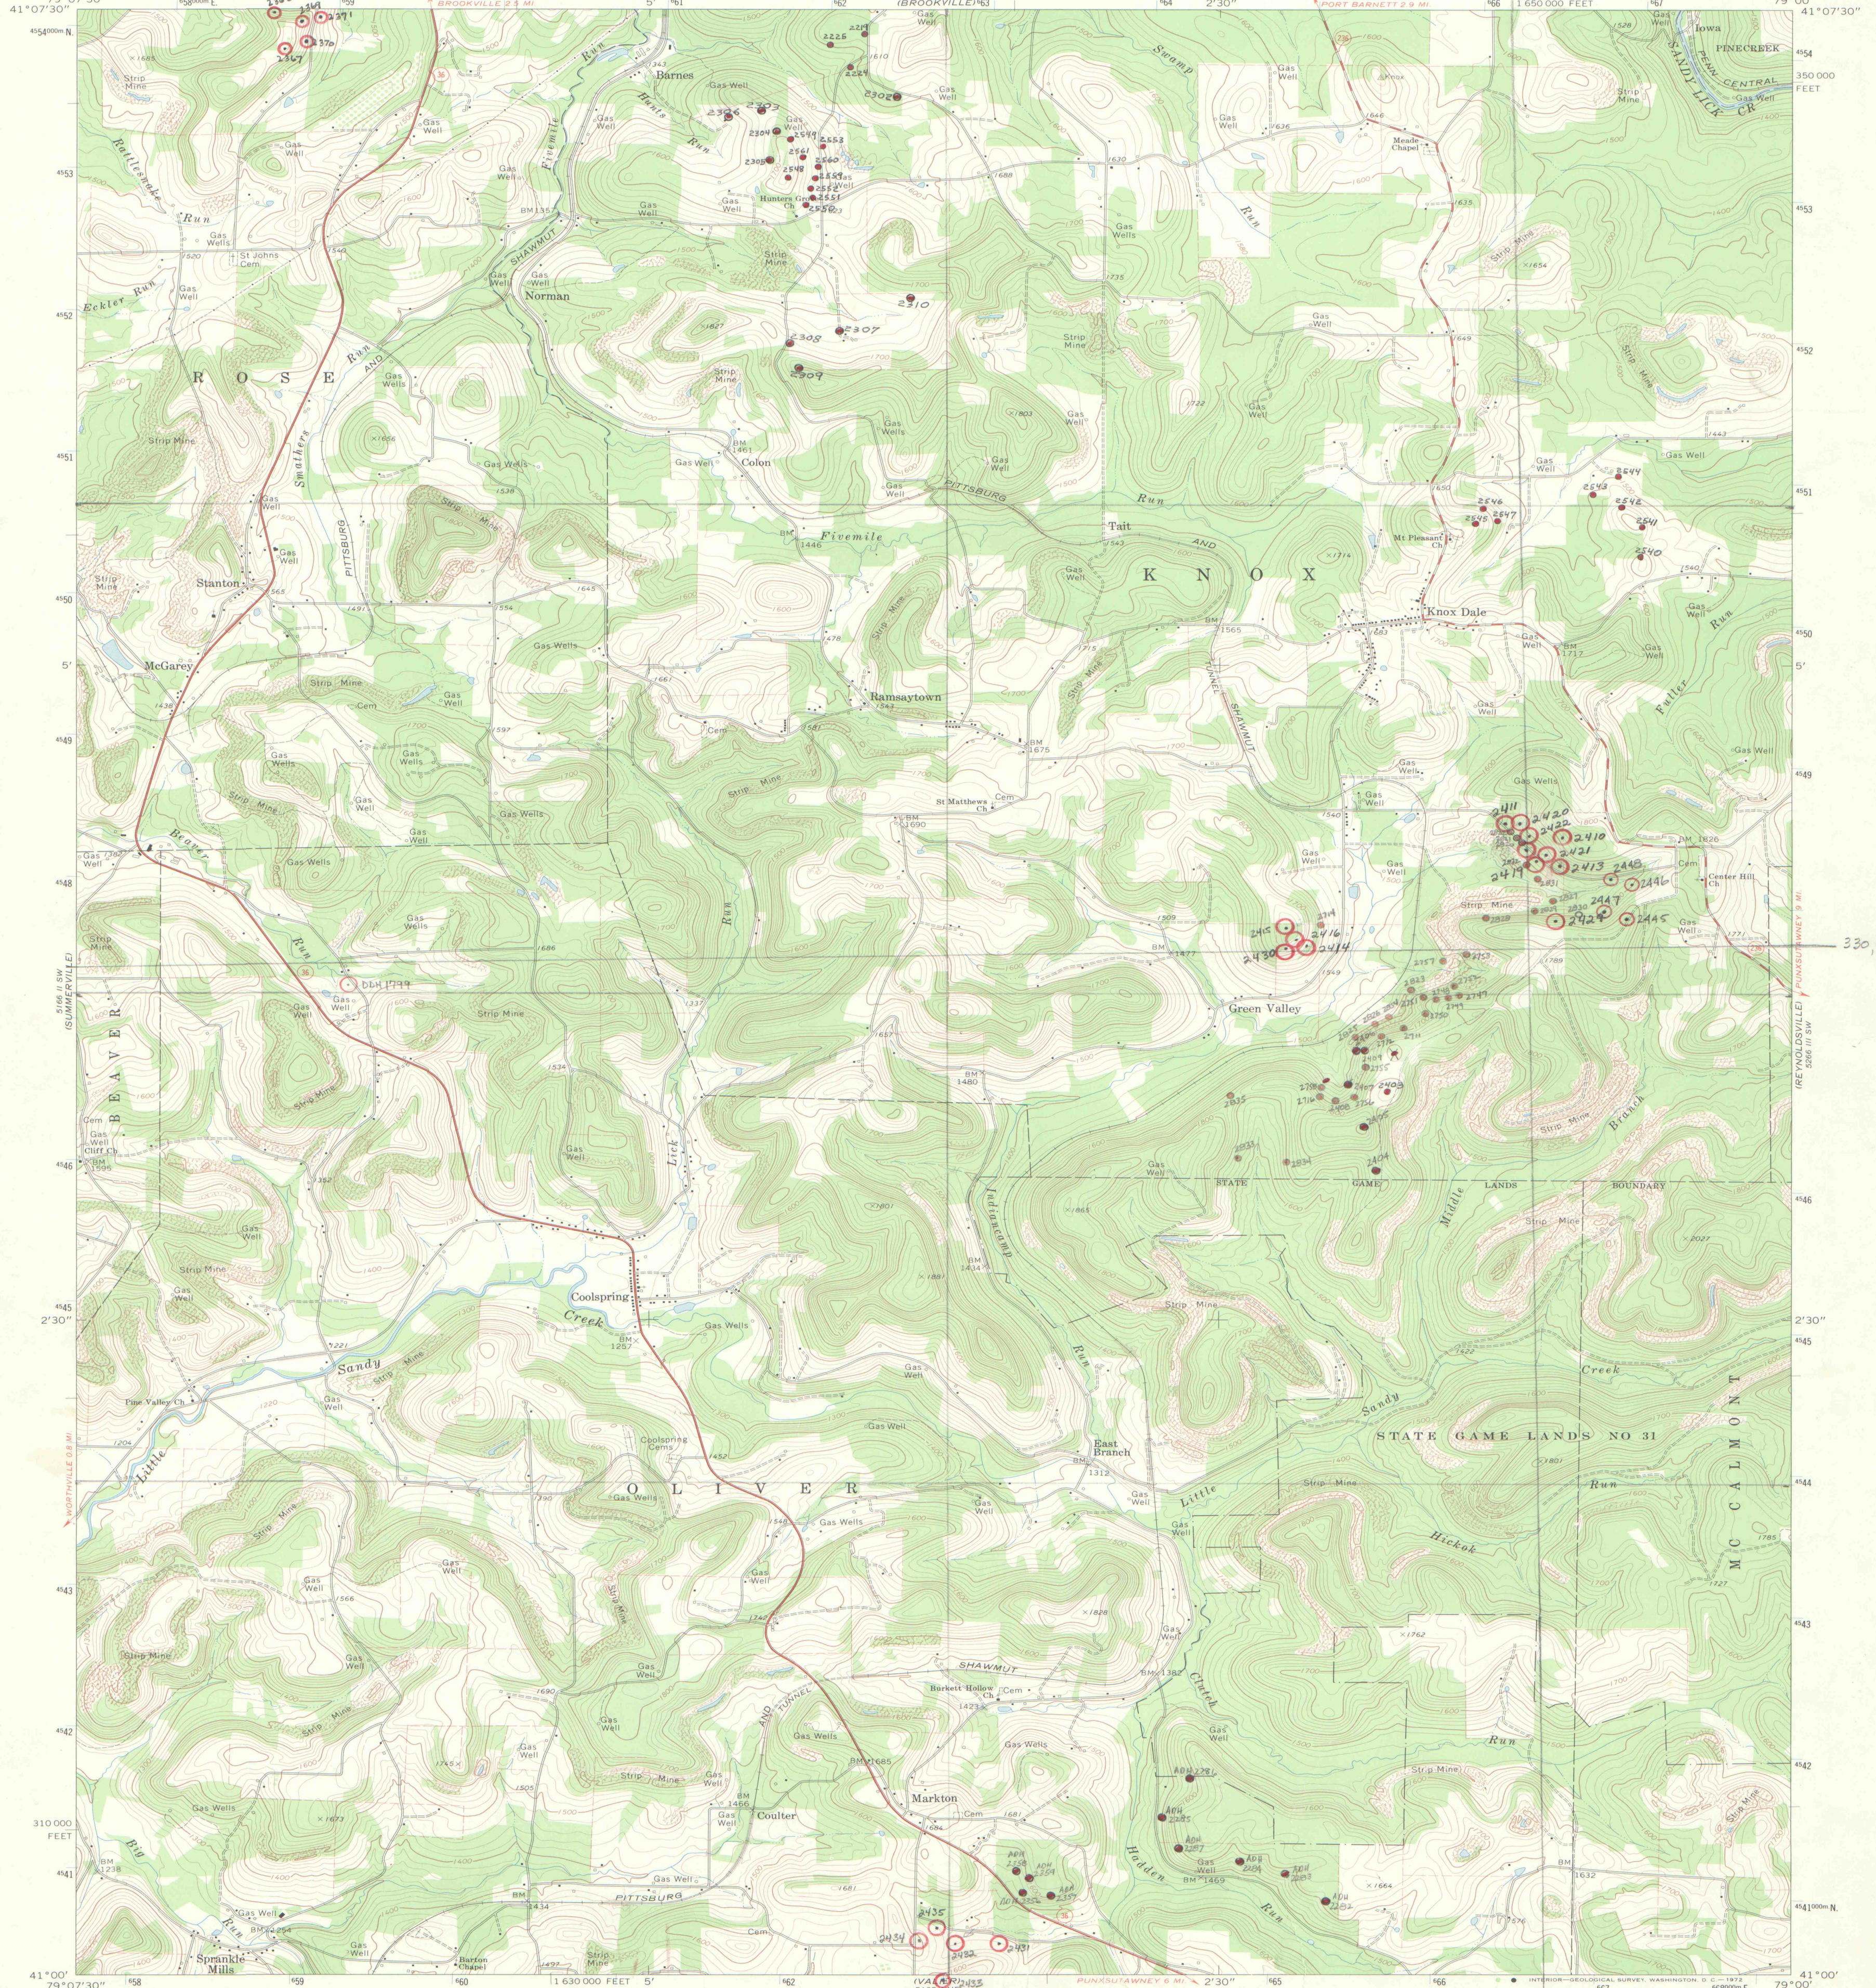

IMAPS#09319