


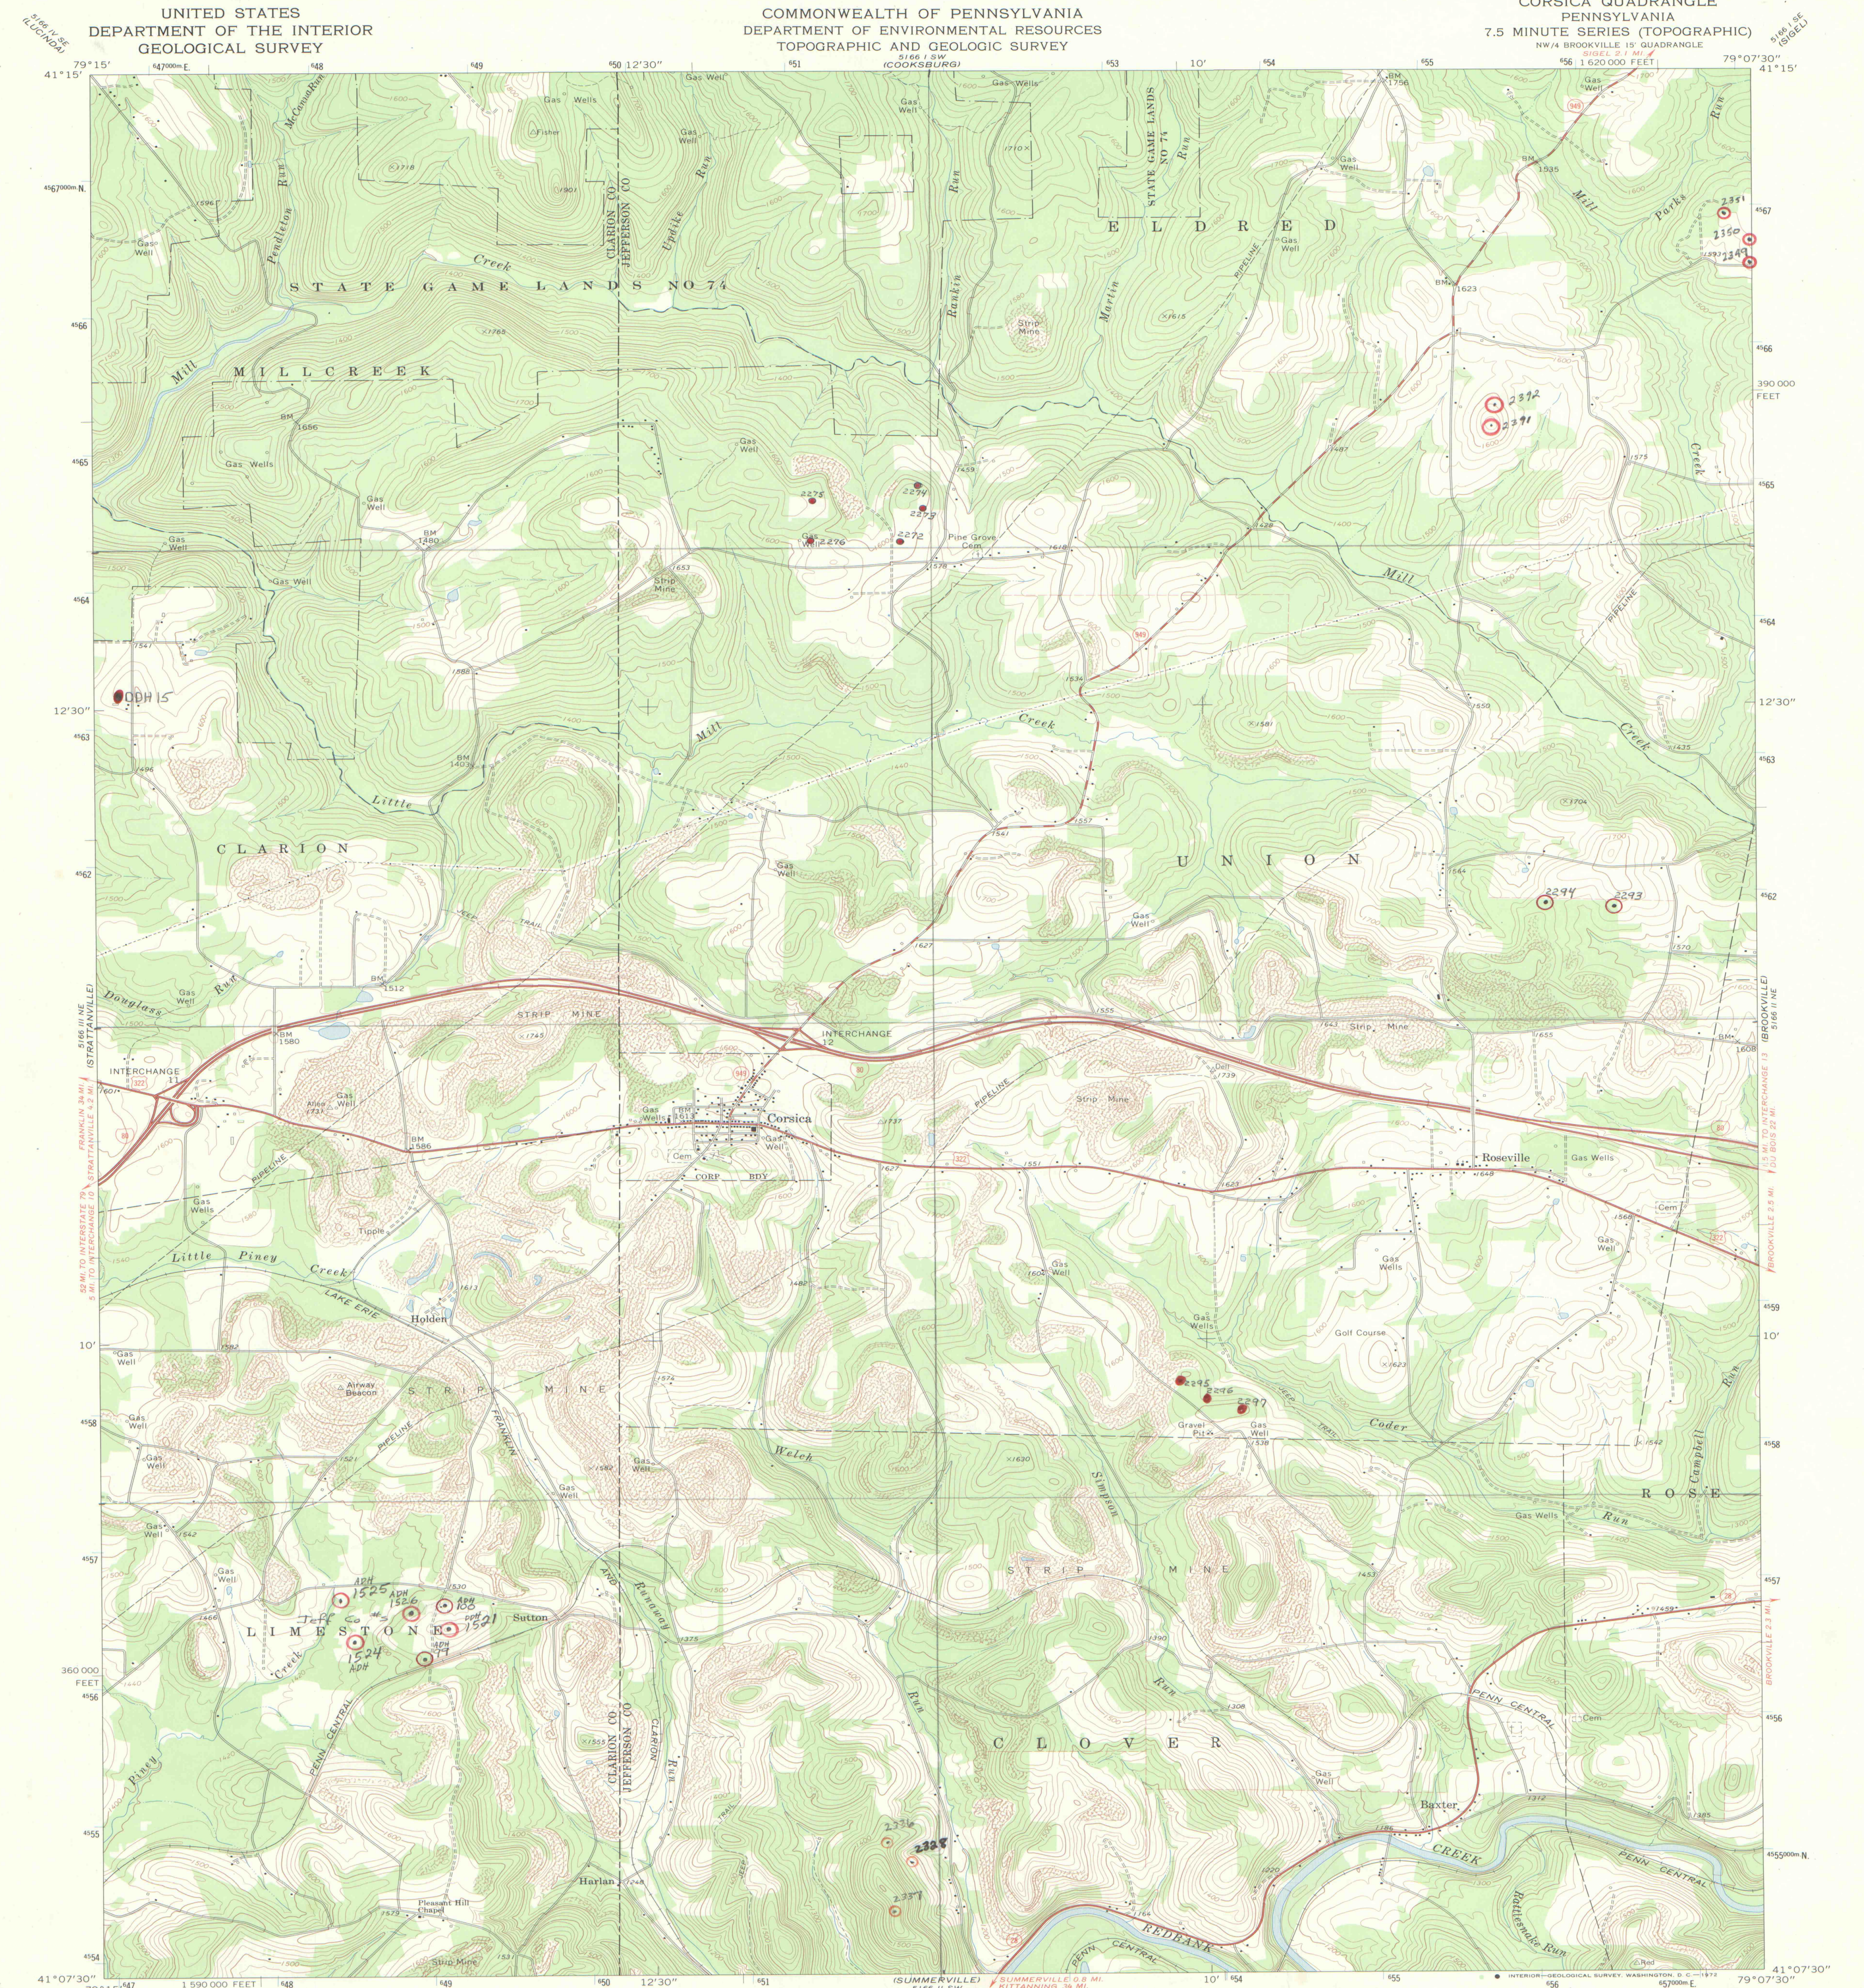

UNITED STATES
DEPARTMENT OF THE INTERIOR
GEOLOGICAL SURVEY

COMMONWEALTH OF PENNSYLVANIA
DEPARTMENT OF ENVIRONMENTAL RESOURCES
TOPOGRAPHIC AND GEOLOGIC SURVEY

CORSIKA QUADRANGLE
PENNSYLVANIA
7.5 MINUTE SERIES (TOPOGRAPHIC)
NW 1/4 BROOKVILLE 15' QUADRANGLE
SHEET 214
5166 II NW
1:62,500
79°07'30" 41°15'

Maped, edited, and published by the Geological Survey
Control by USGS and USC&GS
Topography by photogrammetric methods from aerial
photographs taken 1967. Field checked 1969
Polyconic projection. 1927 North American datum
10,000-foot grid based on Pennsylvania coordinate system, north zone
1000-meter Universal Transverse Mercator grid ticks, zone 17,
shown in blue
Fine red dashed lines indicate selected fence and field lines where
generally visible on aerial photographs. This information is unchecked

UTM GRID AND 1969 MAGNETIC NORTH
DECLINATION AT CENTER OF SHEET

7°
124 MILS
1°12'
21 MILS

DIAMOND DRILL HOLE
Location Maps
A-02
5-4-A
NOT TO BE TAKEN FROM OFFICE

SCALE 1:24,000
1 1000 0 1000 2000 3000 4000 5000 6000 7000 FEET
1 5 10 KILOMETER

PENNSYLVANIA
QUADRANGLE LOCATION
A-19

ROAD CLASSIFICATION

Primary highway, hard surface
Secondary highway, hard surface
Interstate Route
Light-duty road, hard or improved surface
Unimproved road
U. S. Route
State Route

CORSICA, PA.
NW 1/4 BROOKVILLE 15' QUADRANGLE
N4107.5—W7907.5/7.5
1969
AMS 5166 II NW—SERIES V831