


UNITED STATES
DEPARTMENT OF THE INTERIOR
GEOLOGICAL SURVEY

CURTISVILLE QUADRANGLE
PENNSYLVANIA
7.5 MINUTE SERIES (TOPOGRAPHIC)
NE/4 NEW KENSINGTON 15' QUADRANGLE

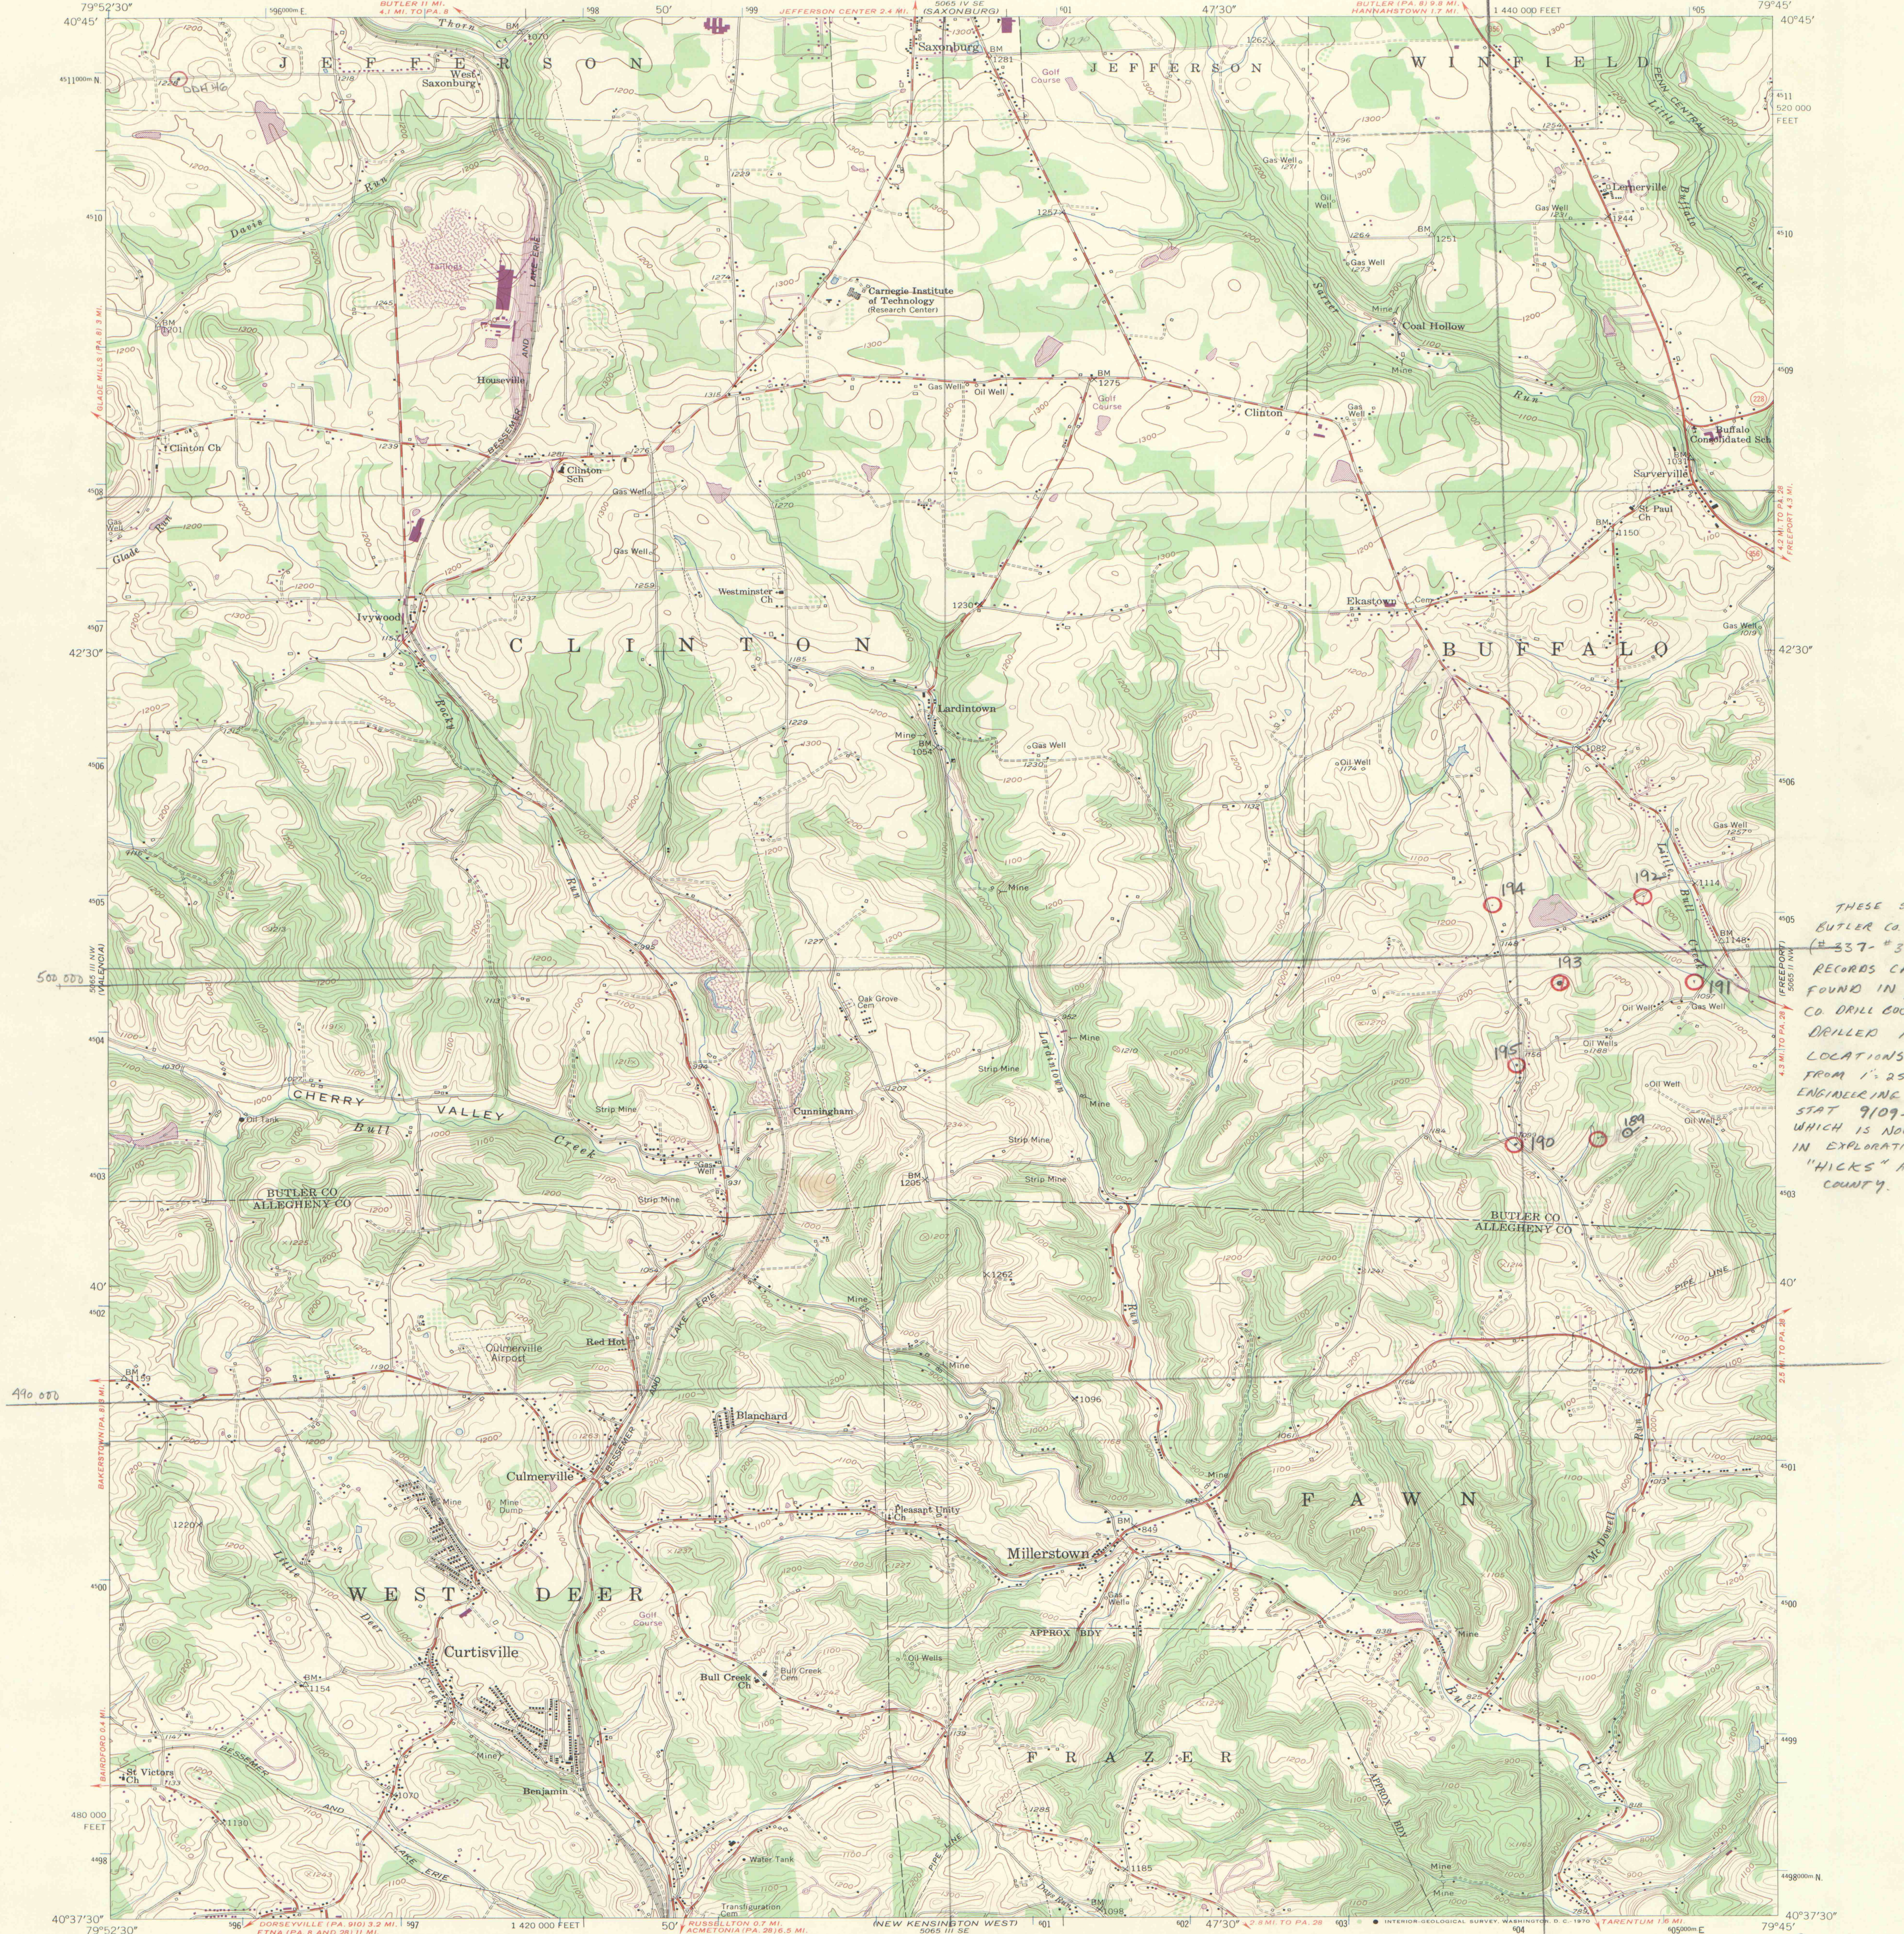


Mapped, edited, and published by the Geological Survey
Control by USGS and USC&GS

Topography from aerial photographs by multiplex methods
Aerial photographs taken 1952. Field check 1953

Polyconic projection. 1927 North American datum
10,000-foot grid based on Pennsylvania coordinate system, south zone
1000-meter Universal Transverse Mercator grid ticks, zone 17,
shown in blue

Broken contours in strip mine areas indicate mining
since photography

Revisions shown in purple compiled in cooperation with
State of Pennsylvania agencies from aerial photographs taken 1969
This information not field checked

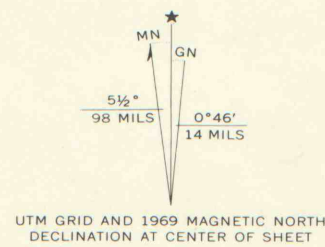

CONTOUR INTERVAL 20
DATUM IS MEAN SEA LEVEL

DIAMOND DRILL HOLE
Location Maps
A-02

THIS MAP COMPLIES WITH NATIONAL MAP A
FOR SALE BY U.S. GEOLOGICAL SURVEY, V
A FOLDER DESCRIBING TOPOGRAPHIC MAPS AND SYM

ROAD CLASSIFICATION
U.S. Route ———— State Route ————

CURTISVILLE, PA.
NE/4 NEW KENSINGTON 15' QUADRANGLE
N4037.5-W7945/7.5

1953
PHOTOREVISED 1969
AMS 5065 III NE-SERIES V831

NOT TO BE TAKEN FROM OFFICE

IMAPS # 01322