


UNITED STATES
DEPARTMENT OF THE INTERIOR
GEOLOGICAL SURVEY

CURWENSVILLE QUADRANGLE
PENNSYLVANIA—CLEARFIELD CO.
7.5 MINUTE SERIES (TOPOGRAPHIC)

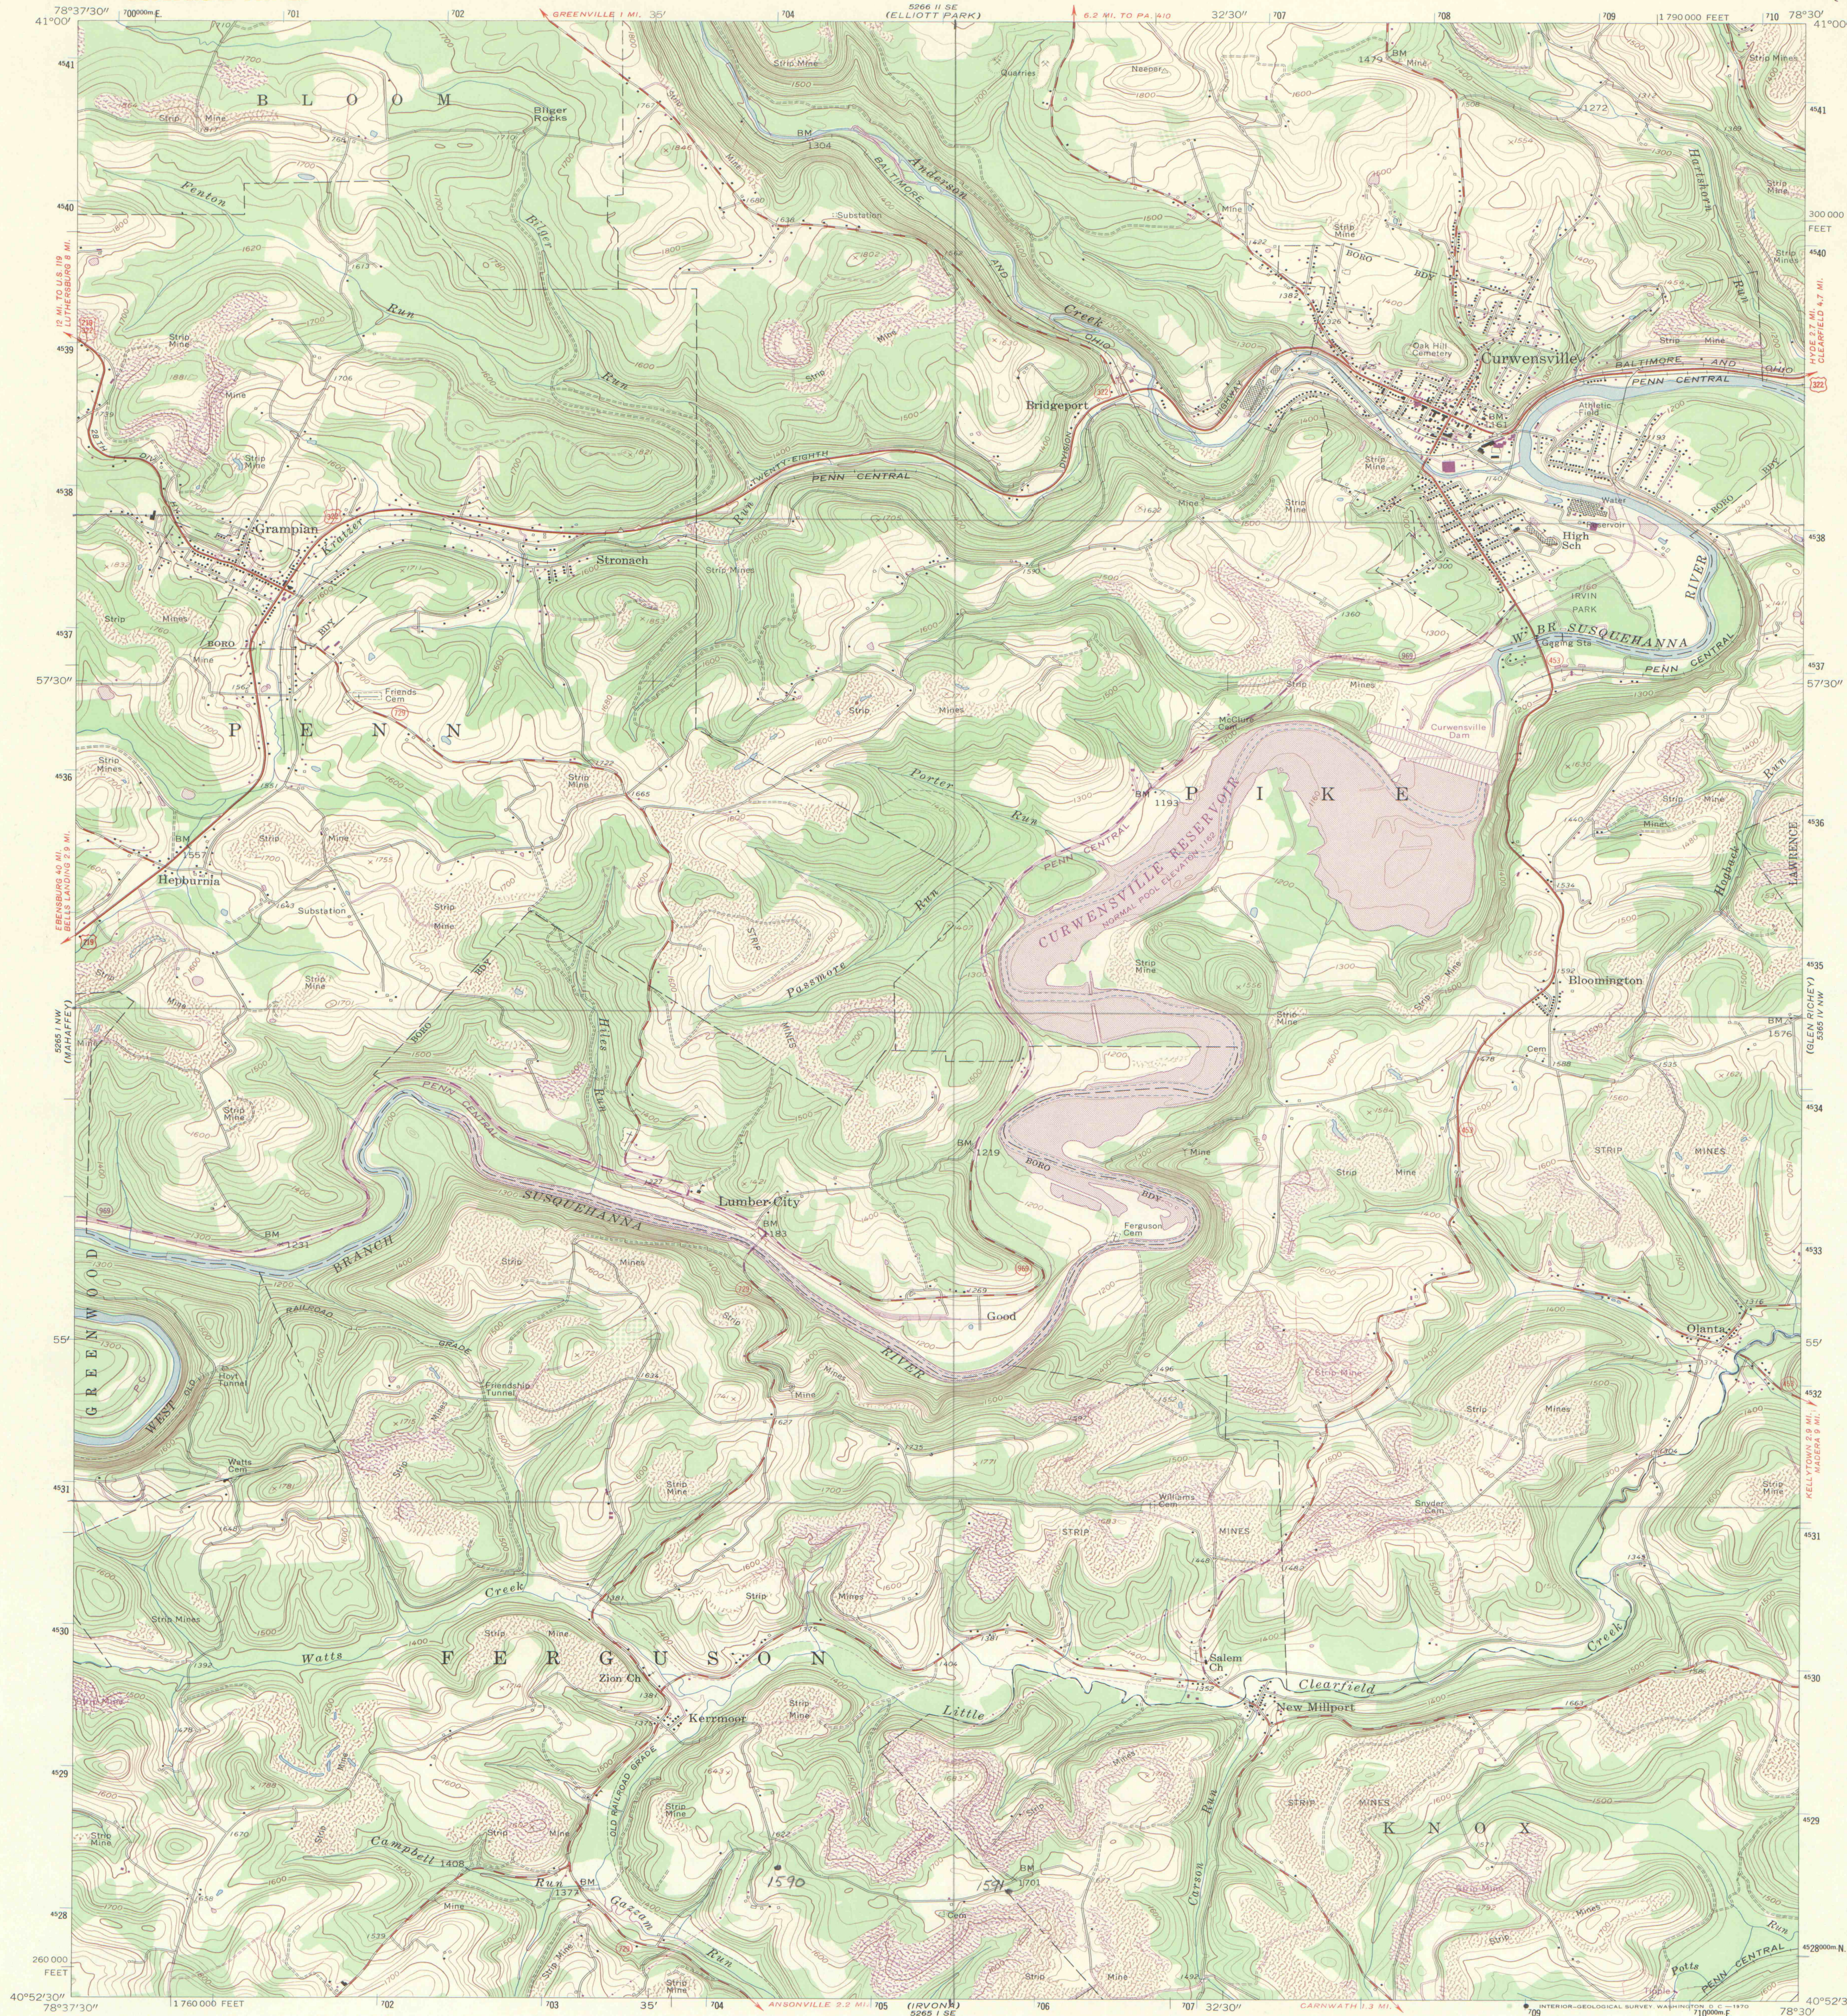

Mapped, edited, and published by the Geological Survey
Control by USGS and USC&GS


Topography from aerial photographs by photogrammetric methods
Aerial photographs taken 1957. Field check 1959

Polyconic projection. 1927 North American datum
10,000-foot grid based on Pennsylvania coordinate system,
north zone

1000-meter Universal Transverse Mercator grid ticks,
zone 17, shown in blue

Fine red dashed lines indicate selected fence and field lines
visible on aerial photographs. This information is unchecked

Curwensville Reservoir is subject to controlled inundation to 1228 feet
Revisions shown in purple compiled in cooperation with State of
Pennsylvania agencies from aerial photographs taken 1969. This
information not field checked

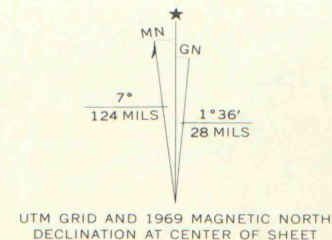


SCALE 1:24,000
1 0 1000 2000 3000 4000 5000 6000 7000 FEET
1 MILE
1000 METER

DIAMOND DRILL HOLE
Location Maps
A-02
7-5-B

NOT TO BE TAKEN FROM OFFICE

242
REQUEST

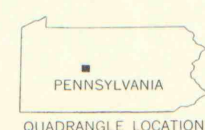

ROAD CLASSIFICATION
Heavy-duty ——— Light-duty ———
Medium-duty ——— Unimproved dirt ———
U.S. Route State Route

CURWENSVILLE, PA.

N 4052.5—W 7830.7/7.5

1959
PHOTOREVISED 1969
AMS 5265 1 NE—SERIES V831

Exploration Services
Division
Authorization
290-00-015

22360 #5 JVTW