

3  
800' Series  
Diamond Holes  
- 1/2 Mile 70ps  
S.E. of  
Rt 219  
Northwest Mining  
& Exchange Co.  
Elk Co.

Mapped, edited, and published by the Geological Survey


Control by USGS and NOS/NOAA

Topography by photogrammetric methods from aerial photographs taken 1968. Field checked 1970

Polyconic projection. 10,000-foot grid ticks based on Pennsylvania coordinate system, north zone 1000-meter Universal Transverse Mercator grid ticks zone 17, shown in blue, 1927 North American Datum To place on the predicted North American Datum 1983 move the projection lines 3 meters south and 22 meters west as shown by dashed corner ticks

Fine red dashed lines indicate selected fence and field lines where generally visible on aerial photographs. This information is unchecked

There may be private inholdings within the boundaries of the National or State reservations shown on this map

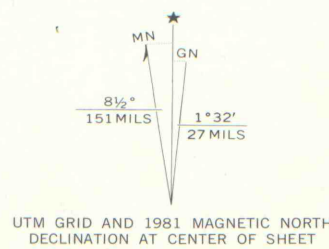




NOT TO BE TAKEN FROM THE OFFICE

FOR  
A FOLDER DESCRIBING FOR CON...

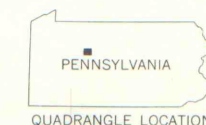

ROAD CLASSIFICATION  
Primary highway, hard surface  
Secondary highway, hard surface  
Interstate Route  
Light-duty road, hard or improved surface  
Unimproved road  
U. S. Route  
State Route

BRANDY CAMP, PA.

N4115-W7837.5/7.5

Revisions shown in purple compiled in cooperation with Commonwealth of Pennsylvania agencies from aerial photographs taken 1977 and other sources. This information not field checked. Map edited 1981

1970  
PHOTOREVISED 1981  
DMA 52661 SW-SERIES V831

IMAPS#09324