


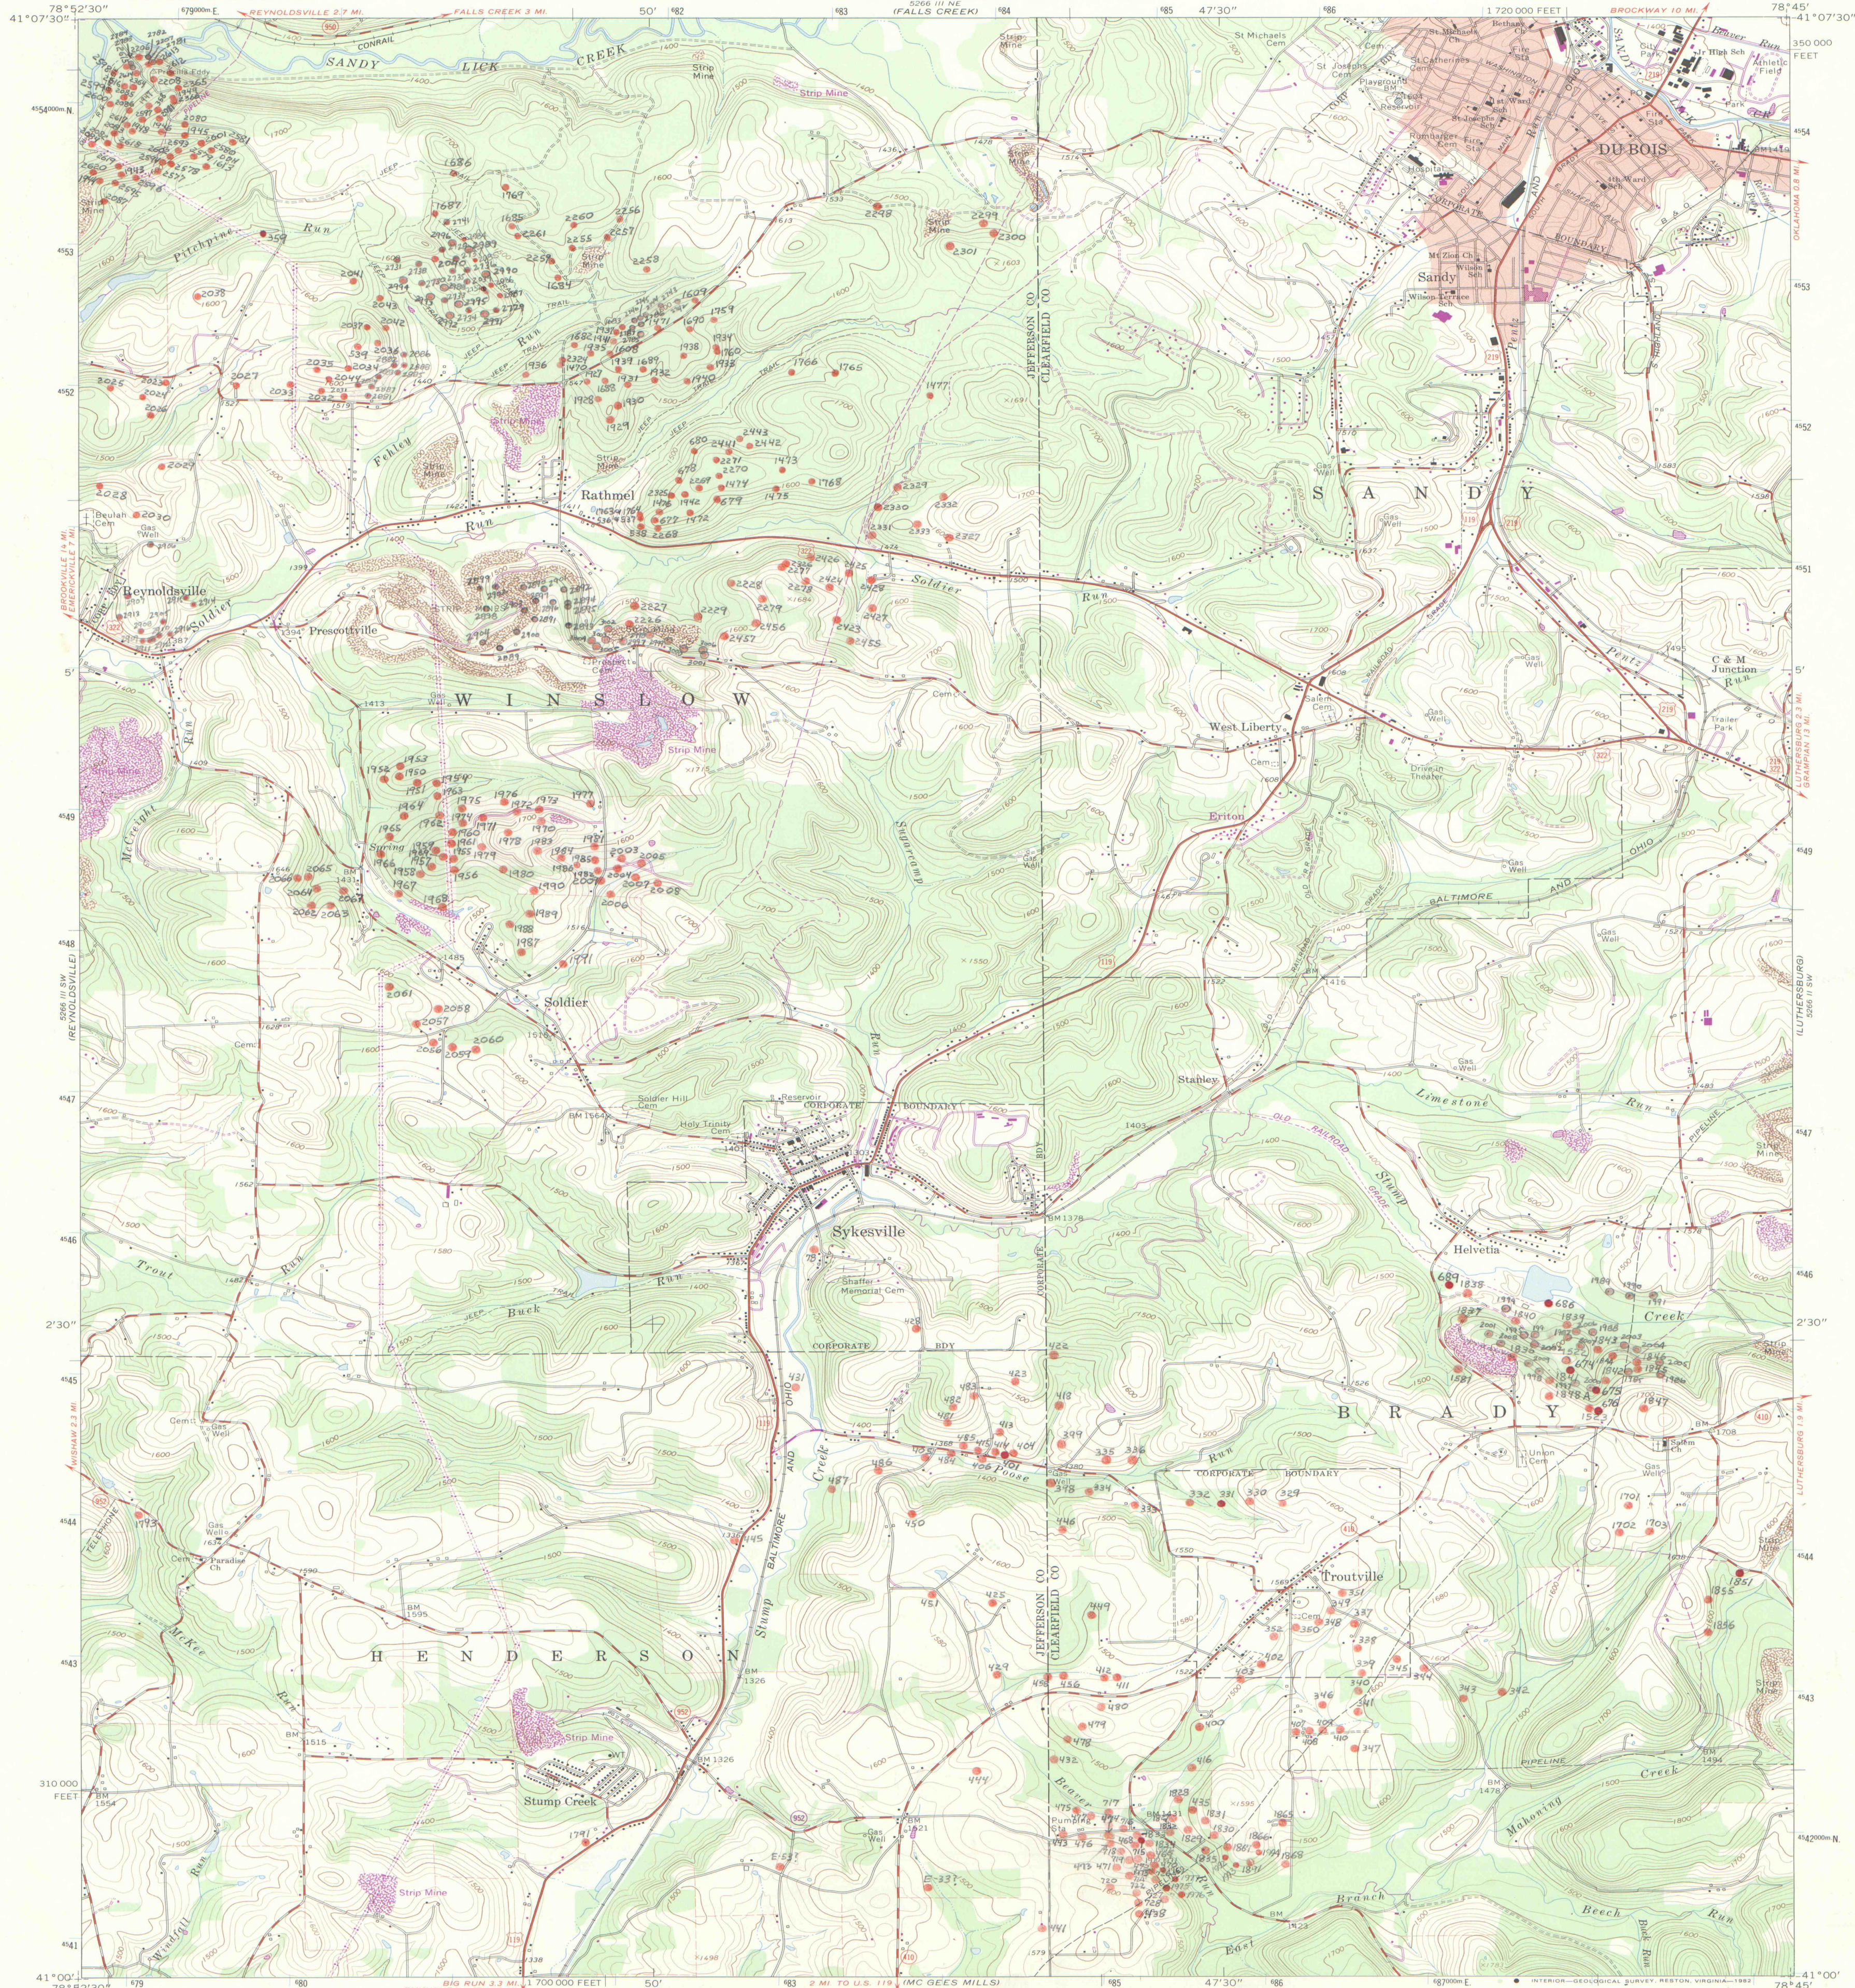

Mapped, edited, and published by the Geological Survey



Control by USGS and NOS/NOAA

Topography by photogrammetric methods from aerial photographs taken 1964. Field checked 1966

Polyconic projection. 10,000-foot grid ticks based on Pennsylvania coordinate system, north zone 1000-meter Universal Transverse Mercator grid ticks, zone 17, shown in blue. 1927 North American Datum To place on the predicted North American Datum 1983 move the projection lines 3 meters south and 21 meters west as shown by dashed corner ticks

Fine red dashed lines indicate selected fence and field lines where generally visible on aerial photographs This information is unchecked


Red tins indicates area in which only landmark buildings are shown

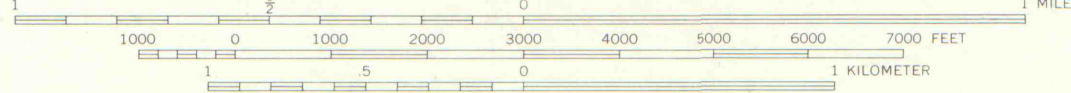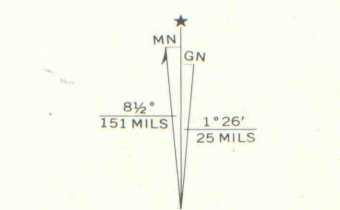

NATIONAL GEODETIC VERTICAL DATUM OF 1929

Drill Hole Location Map 10/20/86

THIS MAP COMPLIES WITH NATIONAL MAP ACCURACY STANDARDS
FOR SALE BY U.S. GEOLOGICAL SURVEY, RESTON, VIRGINIA 22092
A FOLDER DESCRIBING TOPOGRAPHIC MAPS AND SYMBOLS IS AVAILABLE ON REQUEST

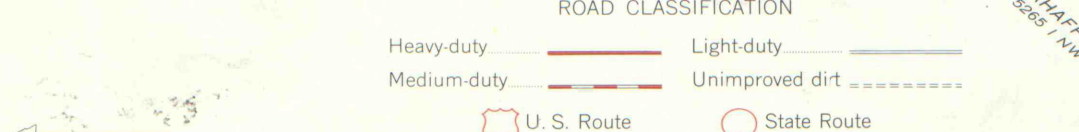

ROAD CLASSIFICATION
Heavy-duty ——— Light-duty ———
Medium-duty ——— Unimproved dirt ———
U.S. Route ——— State Route ———

DU BOIS, PA.
N4100—W7845/7.5
1966
PHOTOGRAPHED 1981
DMA 5266 III SE-SERIES V831

Revisions shown in purple and woodland compiled in cooperation with Commonwealth of Pennsylvania agencies from aerial photographs taken 1977 and other sources. This information not field checked. Map edited 1981

IMAPS #09325