



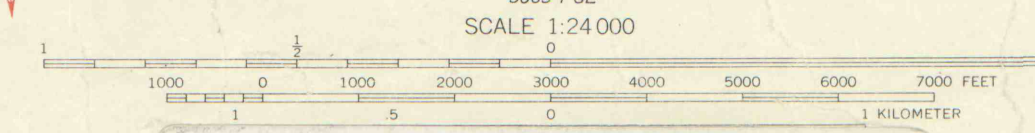


Mapped, edited, and published by the Geological Survey
Control by USGS, USCGS, and USCE
Topography by photogrammetric methods from aerial
photographs taken 1962. Field checked 1963.
Polyconic projection. 1927 North American datum
10,000-foot grids based on Pennsylvania coordinate system, south
and north zones
1000-meter Universal Transverse Mercator grid ticks,
zone 17, shown in blue
Fine red dashed lines indicate selected fence and field lines where
generally visible on aerial photographs. This information is unchecked
Revisions shown in purple compiled in cooperation with
State of Pennsylvania agencies from aerial photographs
taken 1972. This information not field checked

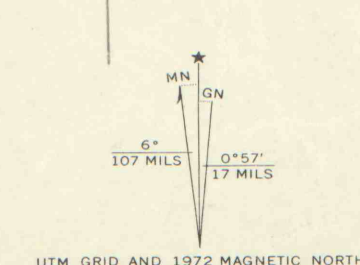

DIAMOND DRILL HOLE
Location Maps
A-02
3-5-B

NOT TO BE TAKEN FROM OFFICE

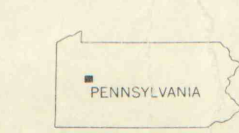

ROAD CLASSIFICATION
Heavy-duty ——— Light-duty ———
Medium-duty ——— Unimproved dirt ———
State Route ———

EAST BRADY, PA.
N4052.5—W7930.7.5
1963
PHOTOREVISED 1972
AMS 5065 I NE—SERIES V851

Exploration Services
Division
Authorization
990-00-015

IMAPS #09330