




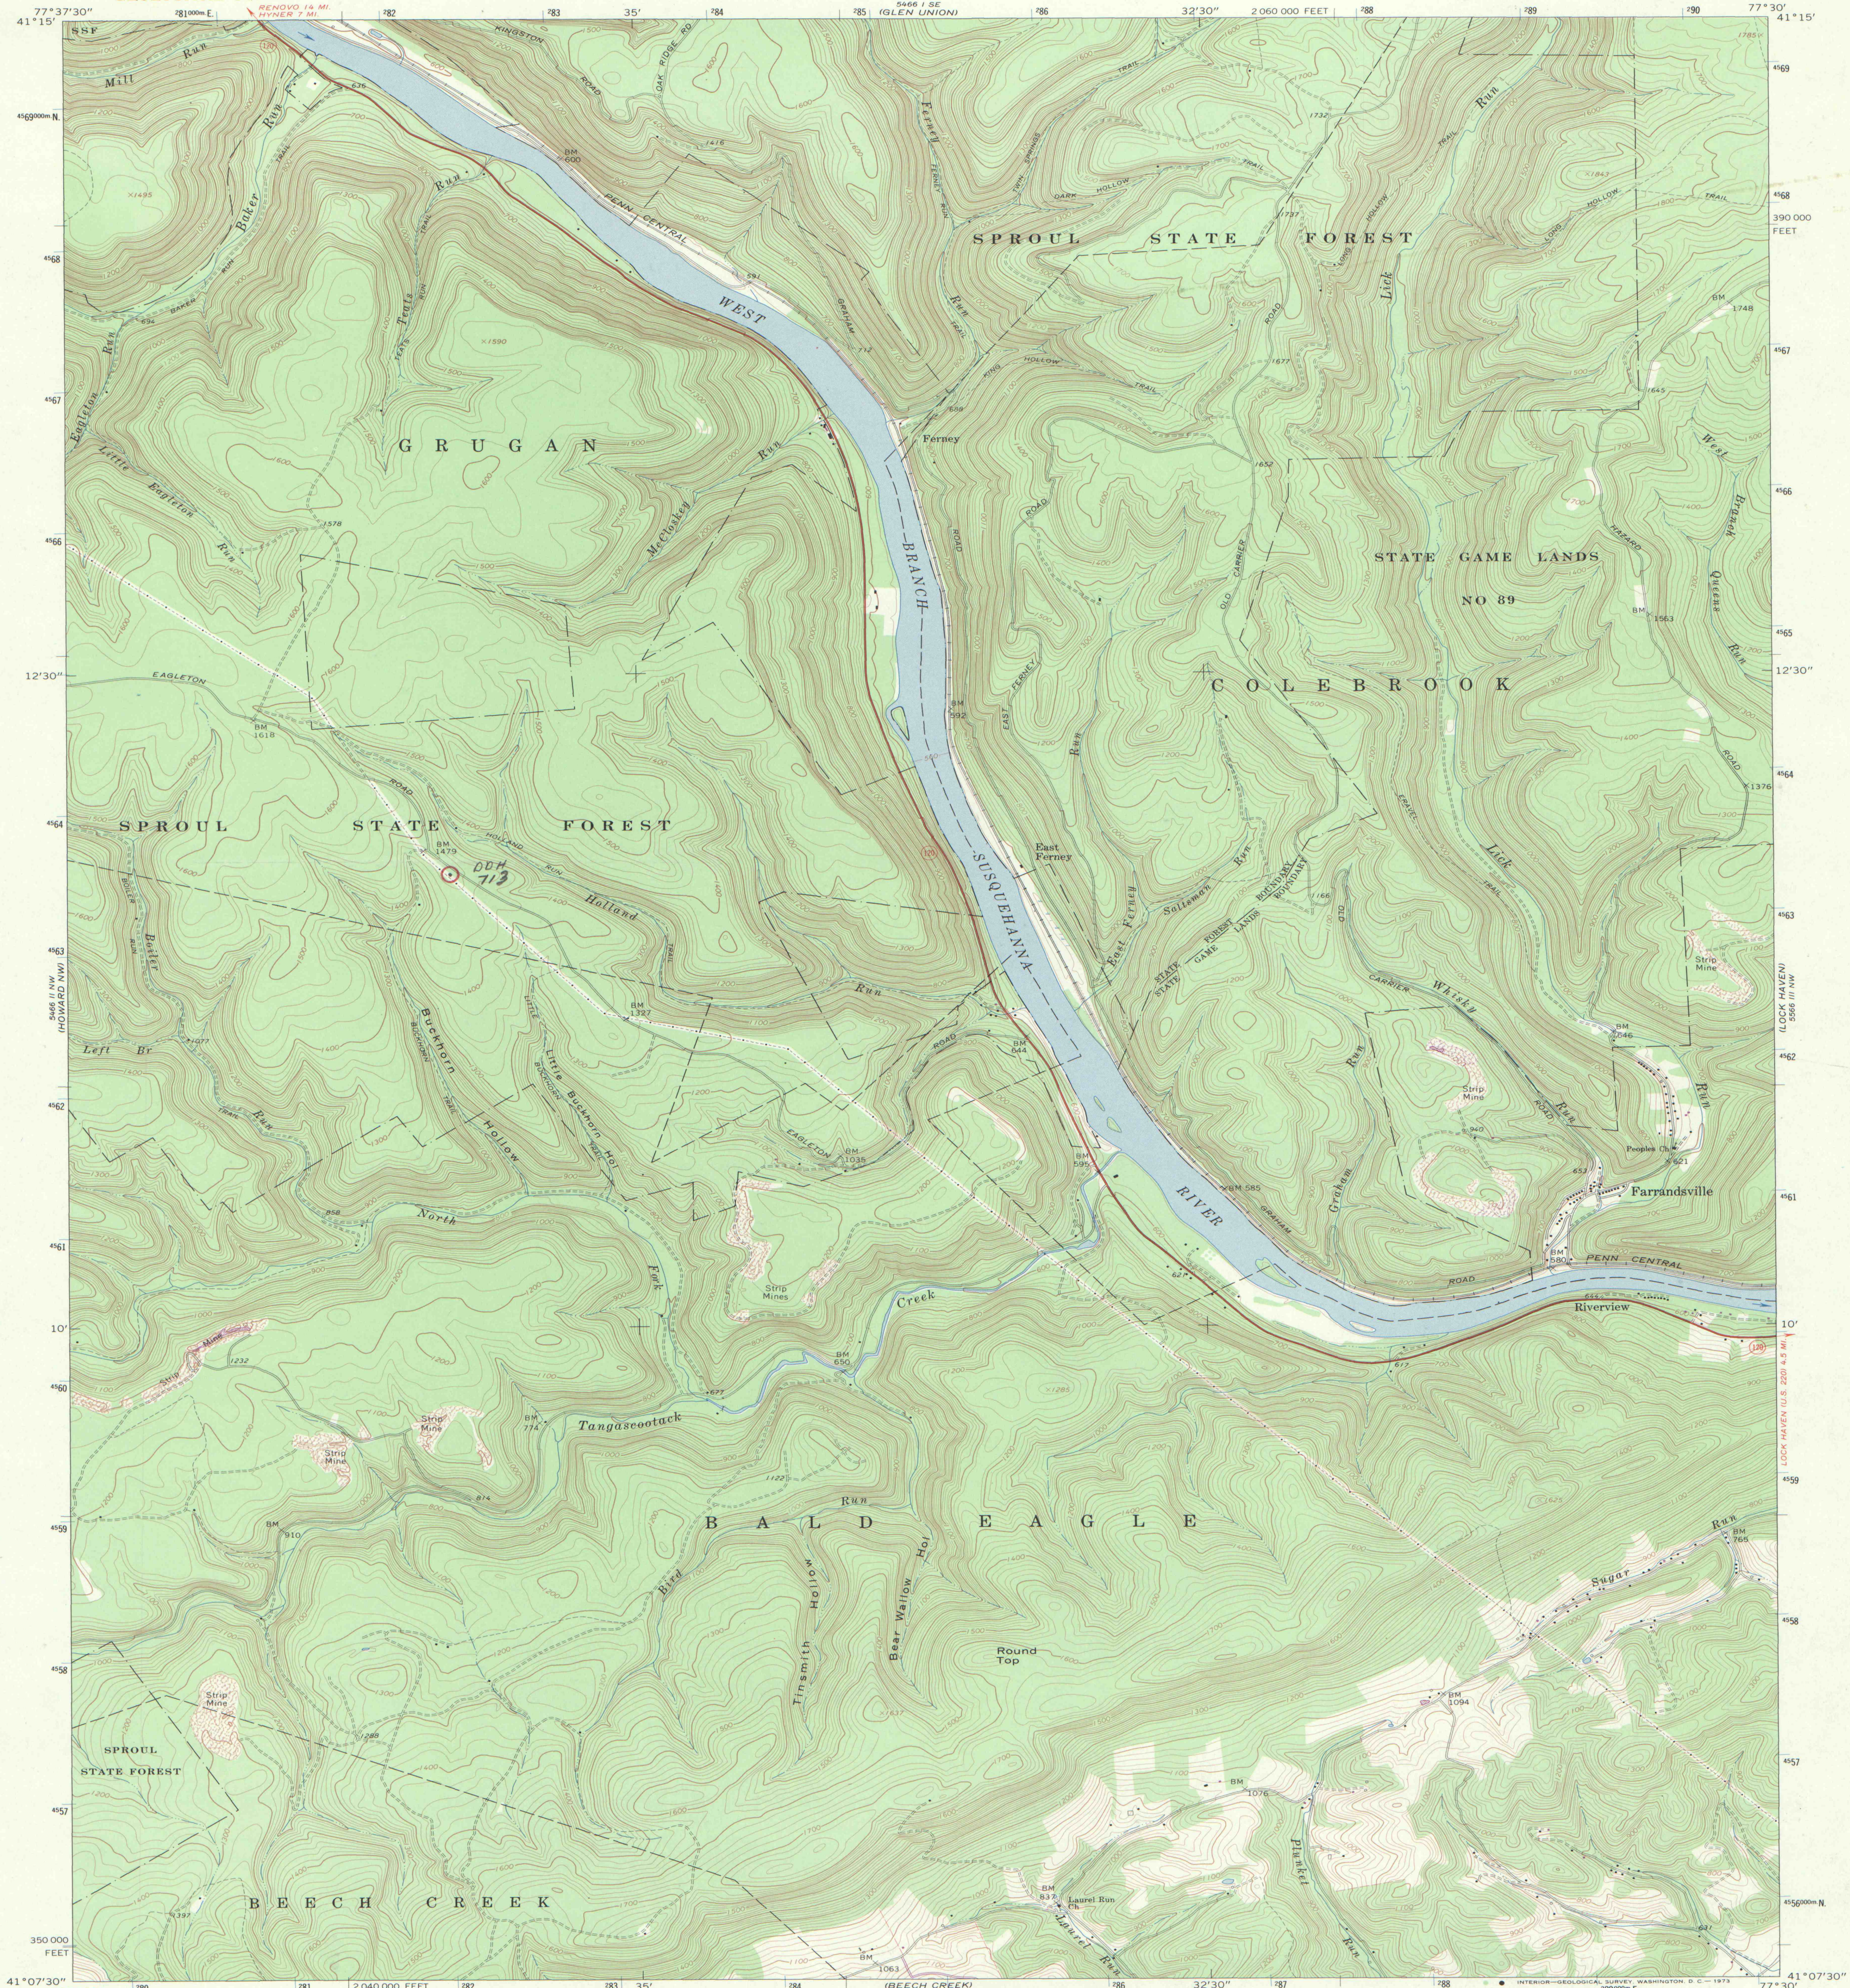

Mapped, edited, and published by the Geological Survey
Control by USGS and USC&GS
Topography by photogrammetric methods from aerial photographs
taken 1966. Field checked 1966
Polyconic projection. 1927 North American datum
10,000-foot grid based on Pennsylvania coordinate system, north zone
1000-meter Universal Transverse Mercator grid ticks, zone 18,
shown in blue
Fine red dashed lines indicate selected fence and field lines where
generally visible on aerial photographs. This information is unchecked

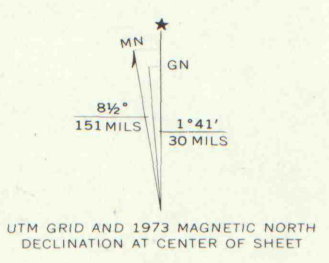

DIAMOND DRILL HOLE
Location Maps
A-02
11-4-B
NOT TO BE REMOVED FROM THE OFFICE

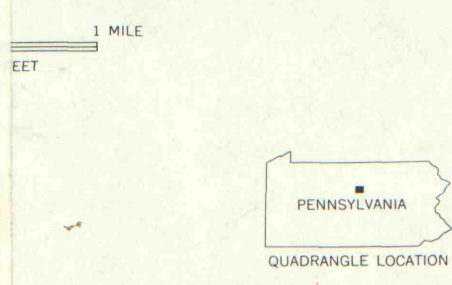

ROAD CLASSIFICATION
Primary highway, all weather, hard surface
Light duty road, all weather, improved surface
Unimproved road, fair or dry weather
State Route

FARRANDSVILLE, PA.
N4107.5—W7730/7.5
1966
PHOTOREVISED 1973
AMS 5466 II NE—SERIES V831

IMAPS#09333