


UNITED STATES
DEPARTMENT OF THE INTERIOR
GEOLOGICAL SURVEY


FREEPORT QUADRANGLE
PENNSYLVANIA
7.5 MINUTE SERIES (TOPOGRAPHIC)
NW/4 FREEPORT 15 QUADRANGLE

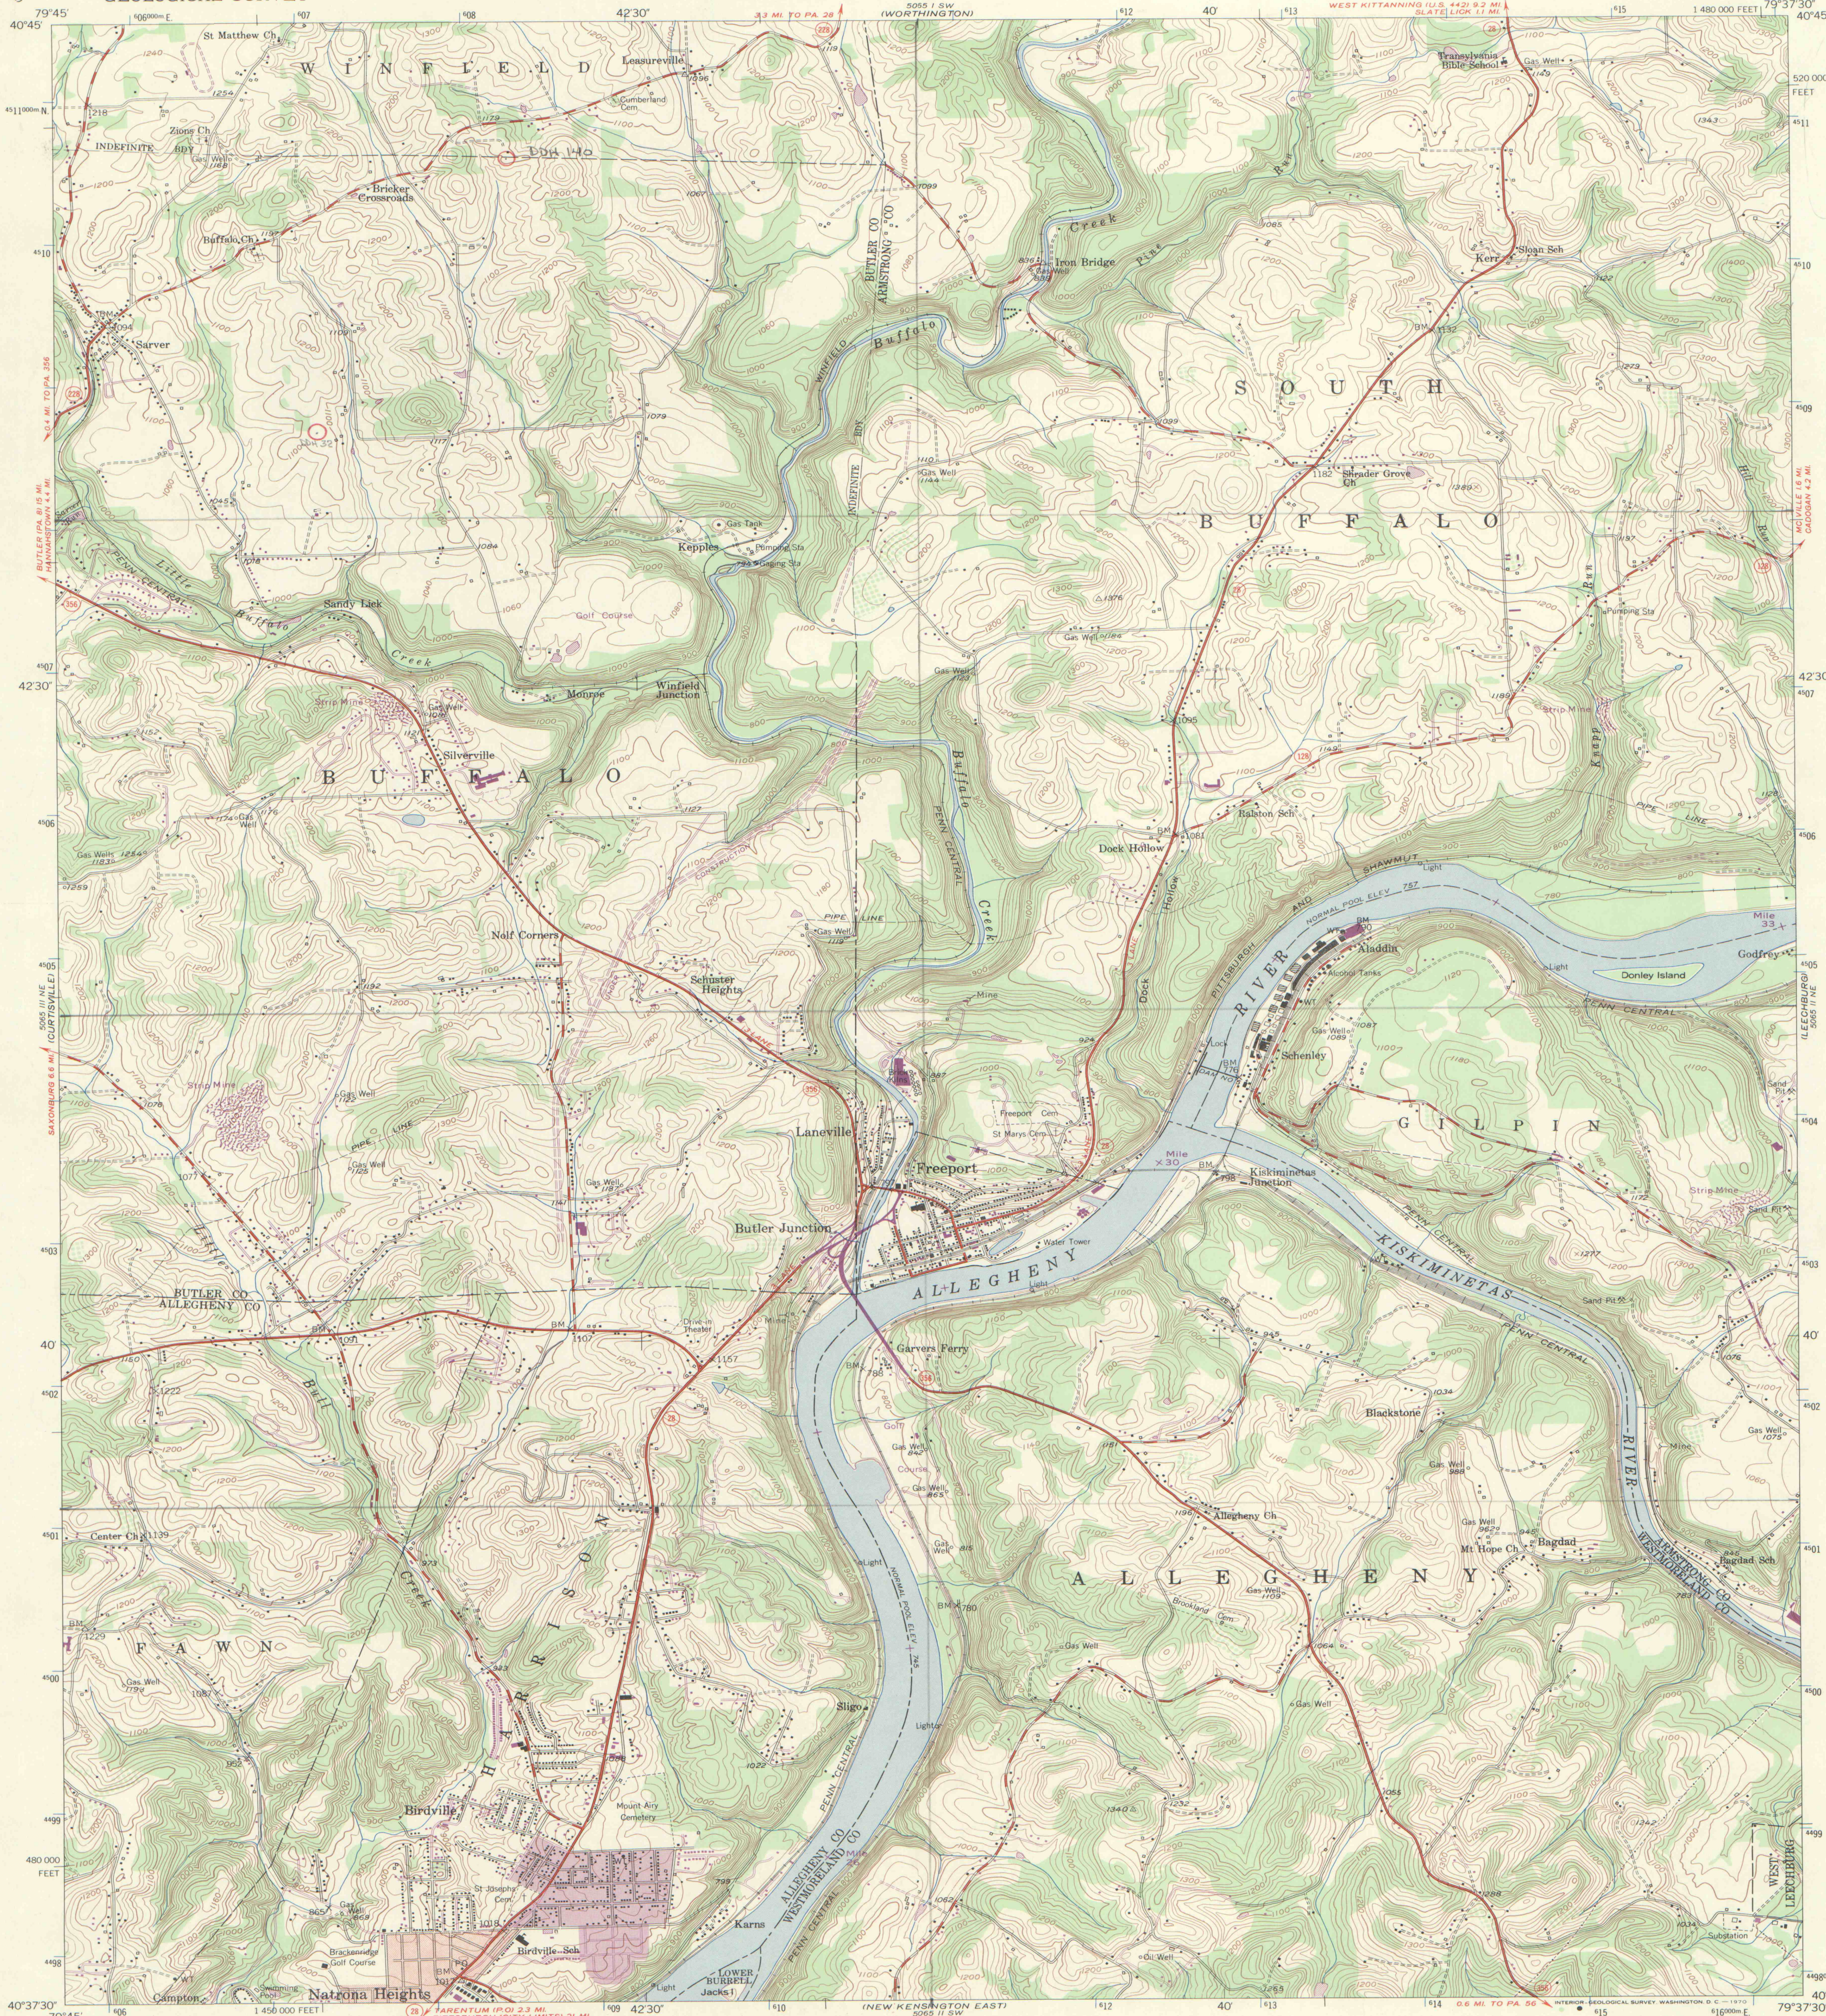

Exploration Services
Division
Authorization
290-00-015

SS 560 #538W1


Mapped, edited, and published by the Geological Survey
Control by USGS and USC&GS
Topography from aerial photographs by multiplex methods
Aerial photographs taken 1952. Field check 1953
Polyconic projection. 1927 North American datum
10,000-foot grid based on Pennsylvania coordinate system, south zone
1000-meter Universal Transverse Mercator grid ticks, zone 17
shown in blue
Red tint indicates areas in which only landmark buildings are shown
Revisions shown in purple compiled in cooperation with
State of Pennsylvania agencies from aerial photographs taken 1969
This information not field checked
Purple tint indicates extension of urban areas

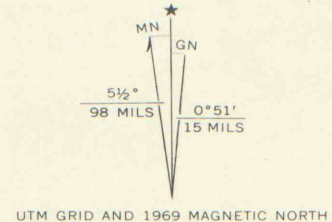

SCALE 1:24,000

DIAMOND DRILL HOLE
Location Maps
A-02

3-6-0 I MAPS # 09335

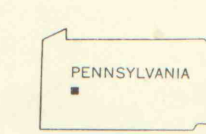

ROAD CLASSIFICATION
Heavy-duty ——— Light-duty ———
Medium-duty ——— Unimproved dirt ———
U. S. Route ——— State Route ———

FREEPORT, PA.
NW/4 FREEPORT 15 QUADRANGLE
N4037.5-W7937.5/7.5

1953
PHOTO REVISITED 1969
AMS 5065 II NW-SERIES V831