



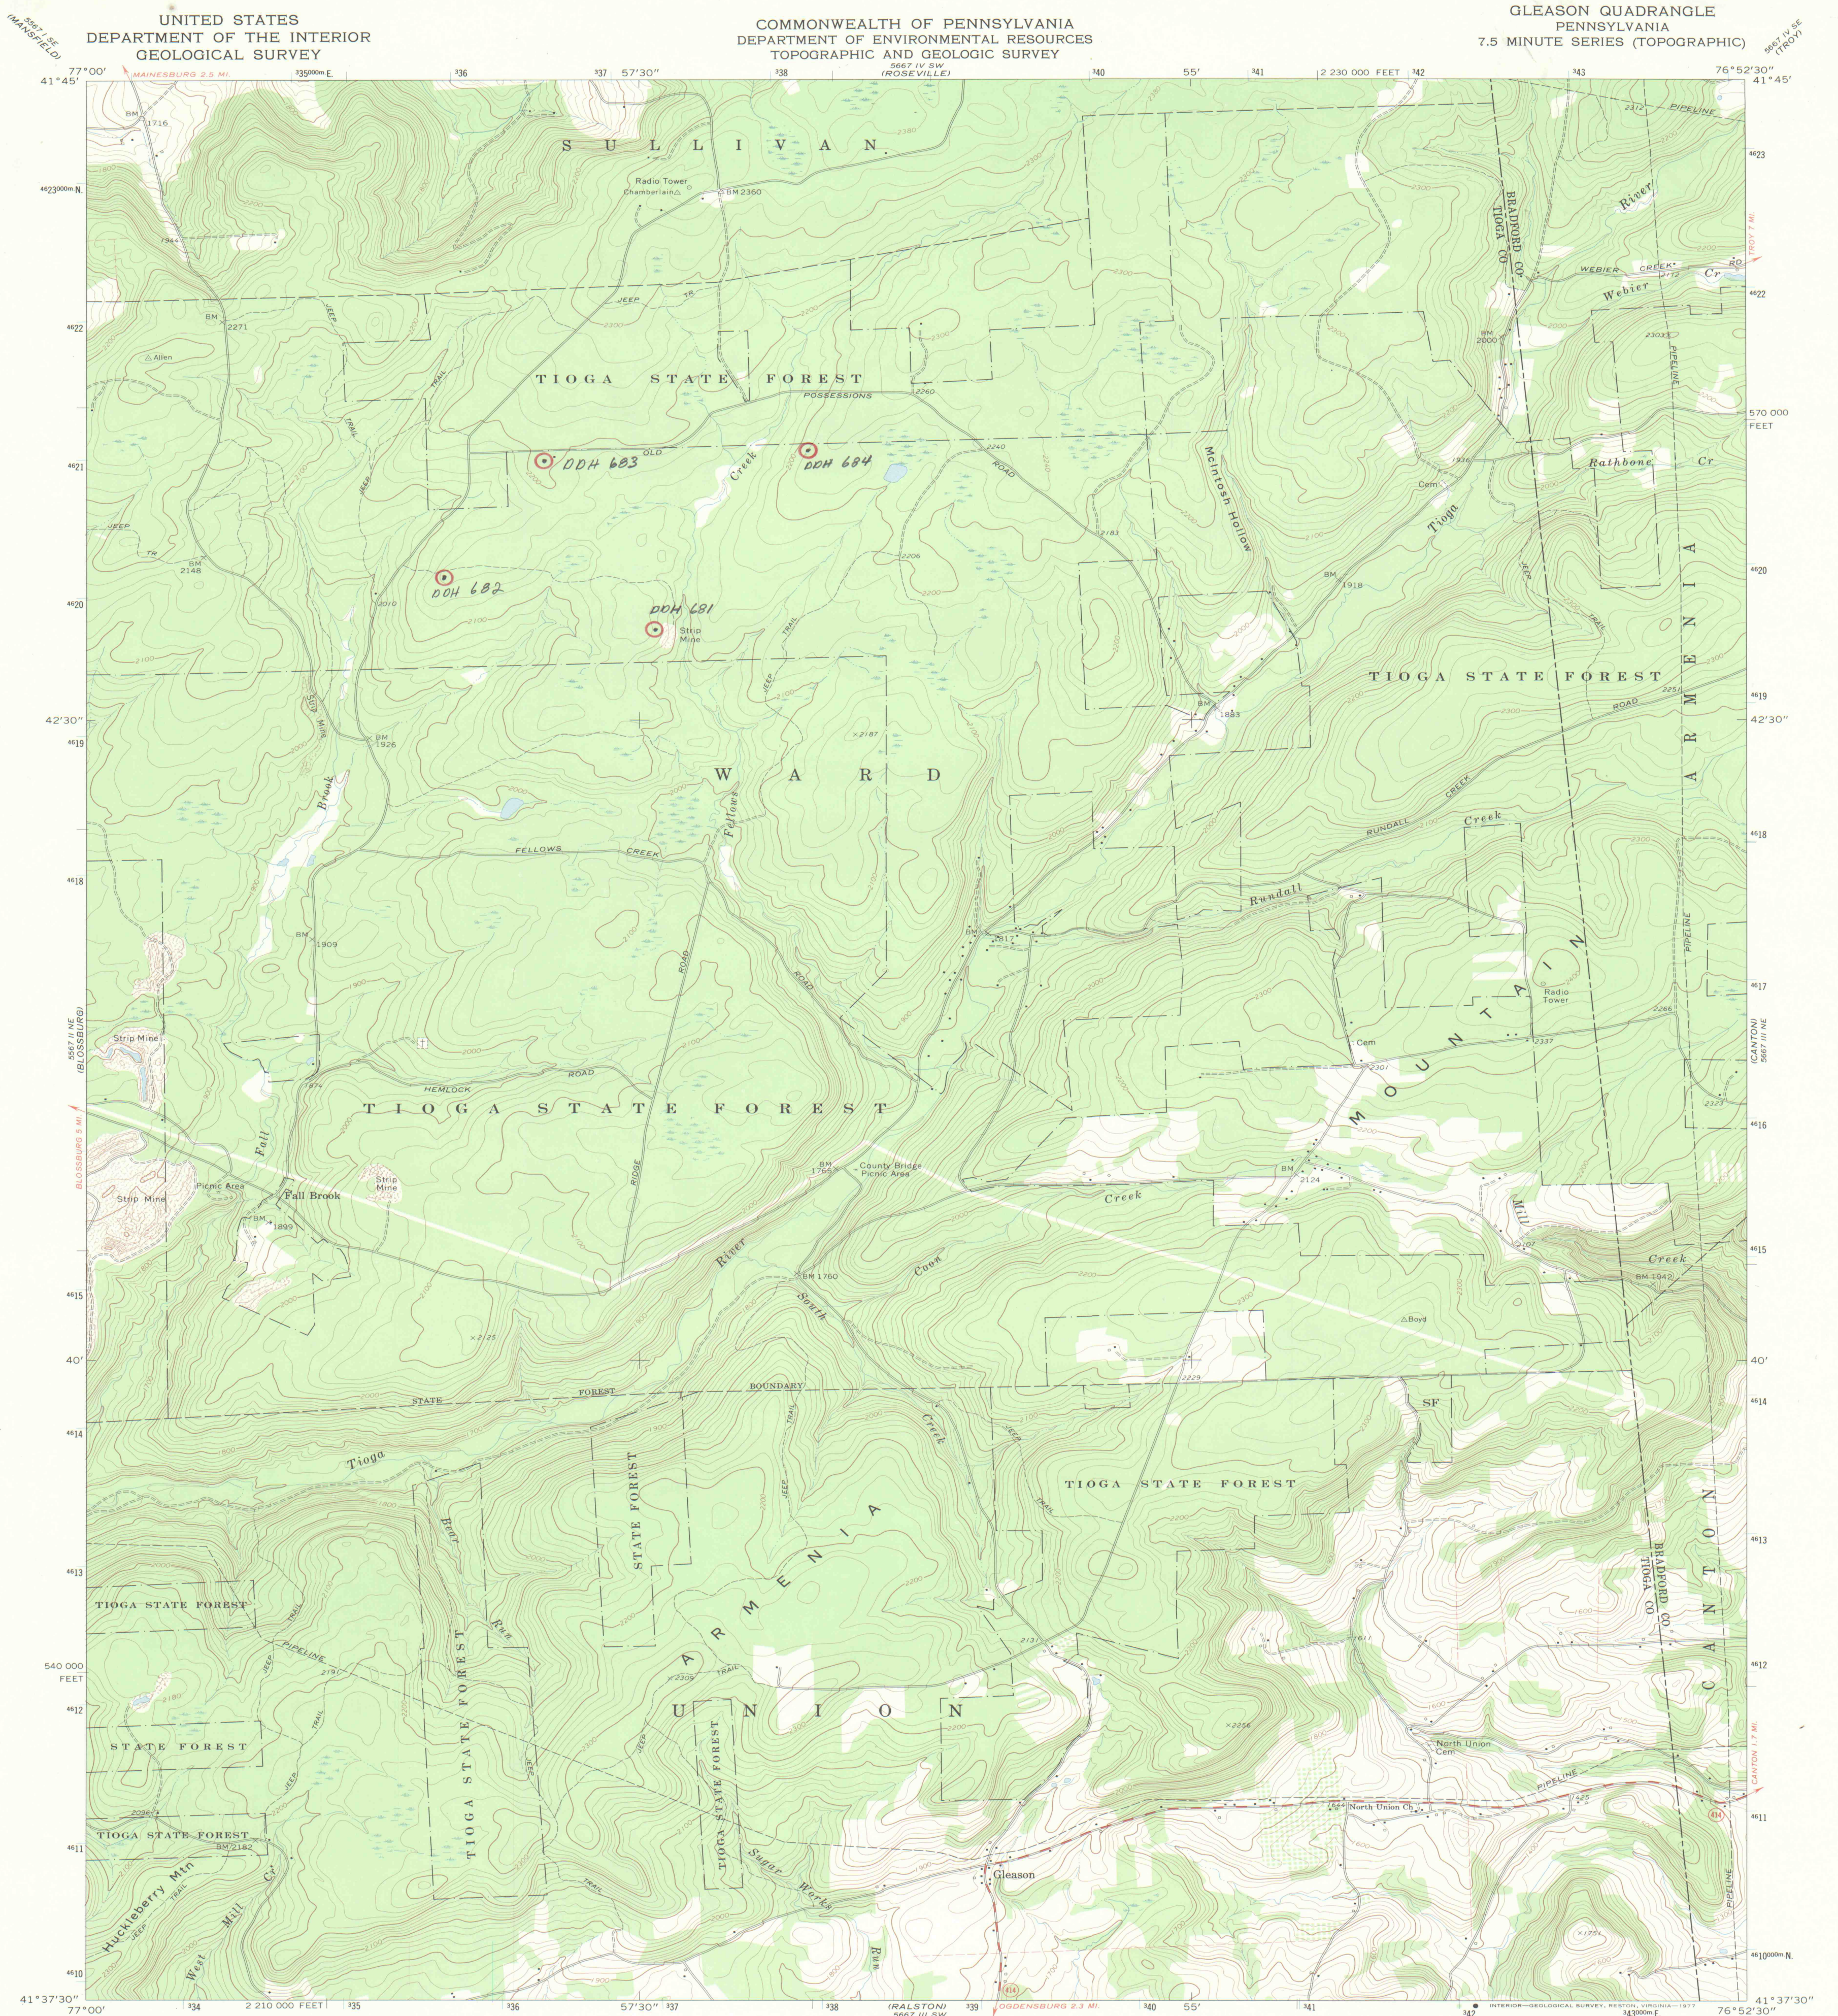

Mapped, edited, and published by the Geological Survey
Control by USGS and USC&GS
Topography by photogrammetric methods from aerial photographs
taken 1969 and 1970. Field checked 1970
Polyconic projection. 1927 North American datum
10,000-foot grid based on Pennsylvania coordinate system, north zone
1000-meter Universal Transverse Mercator grid ticks, zone 18,
shown in blue
Fine red dashed lines indicate selected fence and field lines where
generally visible on aerial photographs. This information is unchecked

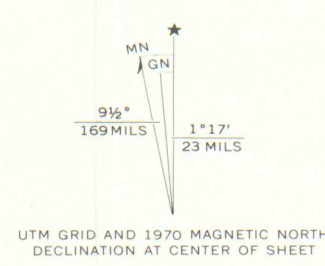

DIAMOND DRILL HOLE
Location Maps
A-02
14-2-A

NOT TO BE REMOVED FROM THE OFFICE

SCALE 1:24,000

1 MILE
0 100 200 300 400 500 600 700 800 900 1000 FEET
0 100 200 300 400 500 600 700 800 900 1000 METERS

QUADRANGLE LOCATION

GLEASON, PA.
N4137.5—W7652.5/7.5
1970
AMS 5667 III NW—SERIES V831

ROAD CLASSIFICATION

Primary highway, hard surface	Light-duty road, hard or improved surface
Secondary highway, hard surface	Unimproved road
Interstate Route	U. S. Route
	State Route

GLEASON, PA.
N4137.5—W7652.5/7.5
1970
AMS 5667 III NW—SERIES V831