


Mapped, edited, and published by the Geological Survey

Control by USGS and USCGS

Topography by photogrammetric methods from aerial photographs taken 1969. Field checked 1969

Polyconic projection. 1927 North American datum 10,000-foot grid based on Pennsylvania coordinate system, north zone 1000-meter Universal Transverse Mercator grid ticks, zone 17, shown in blue

Fine red dashed lines indicate selected fence and field lines where generally visible on aerial photographs. This information is unchecked Area covered by dashed light-blue pattern is subject to controlled inundation

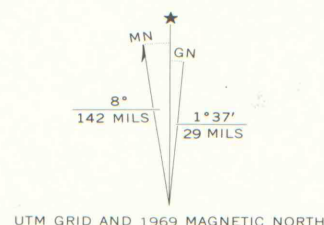


DIAMOND DRILL HOLE
Location Maps
A-02

7-2-D

NOT TO BE REMOVED FROM THE OFFICE

A FOLDER DESCRIBING TOPOGRAPHIC MAPS AND SYMBOLS IS AVAILABLE ON REQUEST

ROAD CLASSIFICATION
Primary highway, hard surface
Secondary highway, hard surface
Unimproved road
Interstate Route
U. S. Route
State Route

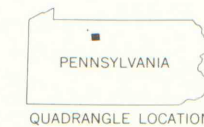

GLEN HAZEL, PA.
SE/4 MT. JEWETT 15' QUADRANGLE
N4130—W7830/7.5

1969

AMS 5267 II SE—SERIES V831

IMAPS #09338