

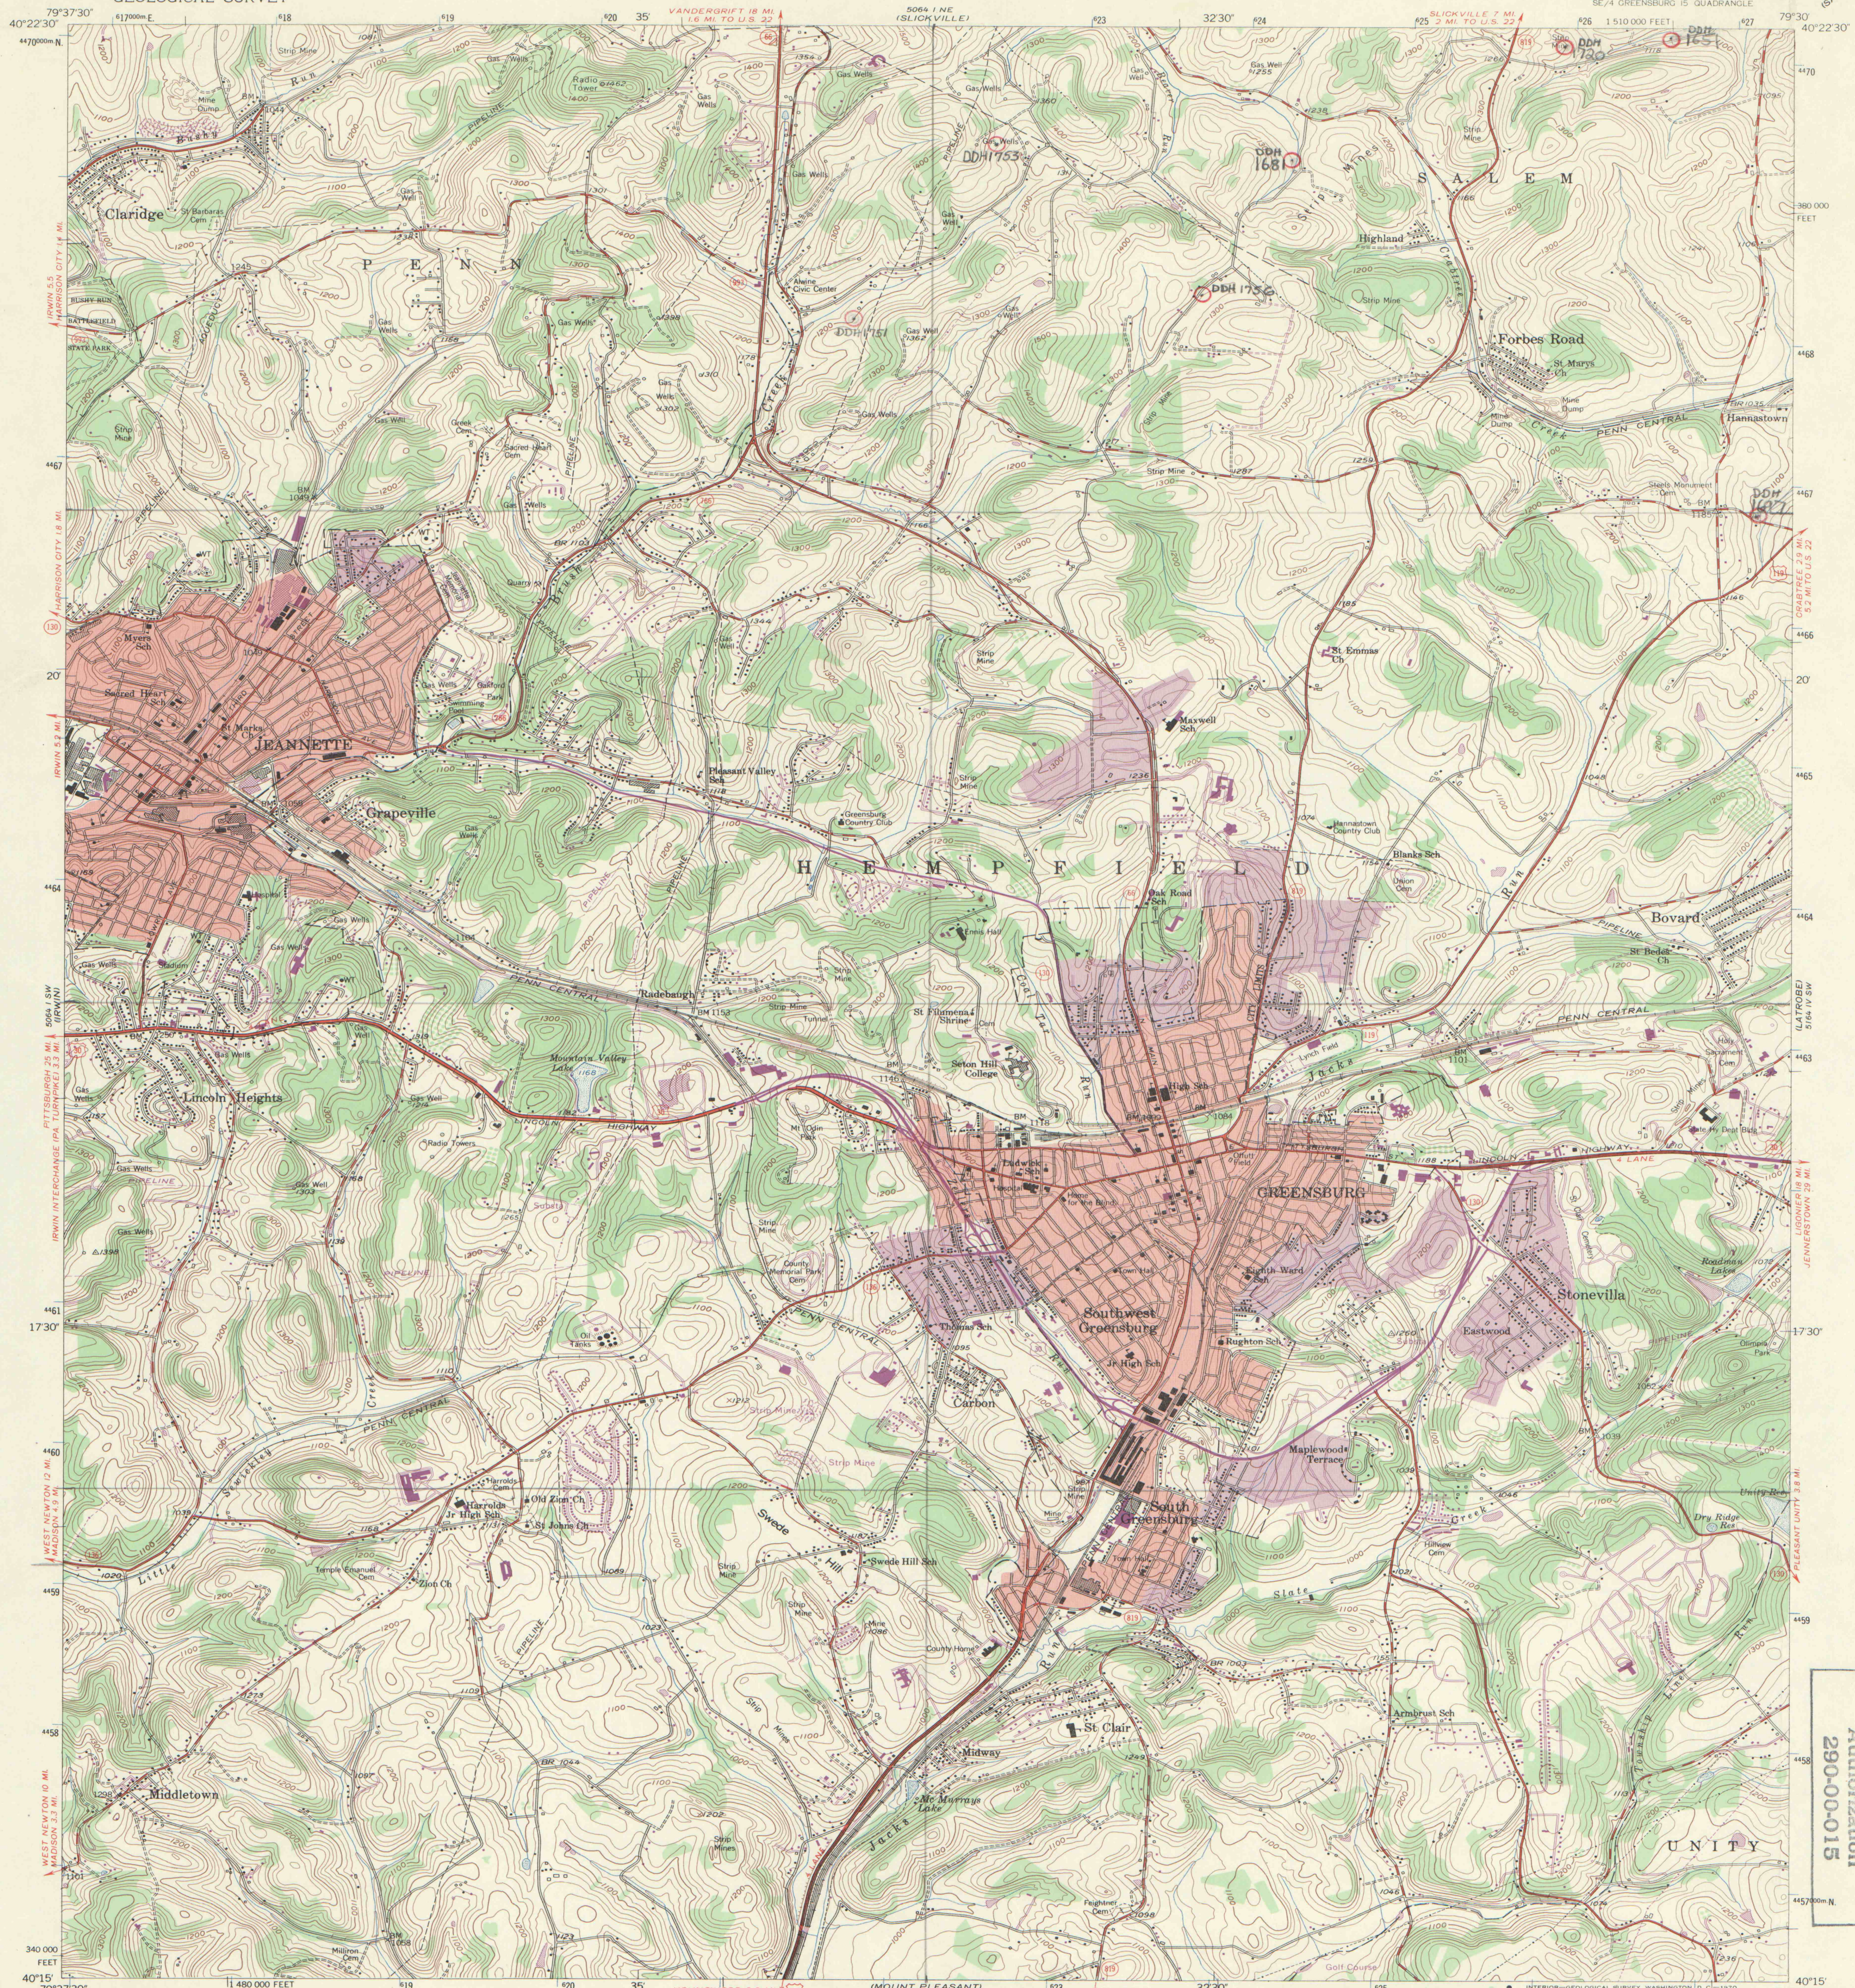


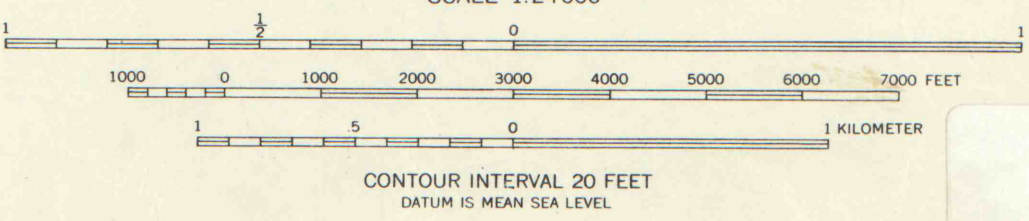

Exploration Services
Division
Authorization
290-00-015

Mapped, edited, and published by the Geological Survey
Control by USGS and USC&GS
Topography by photogrammetric methods from aerial
photographs taken 1952. Field checked 1954
Polyconic projection. 1927 North American datum
10,000-foot grid based on Pennsylvania coordinate system, south zone
1000-meter Universal Transverse Mercator grid ticks, zone 17,
shown in blue
Red tint indicates areas in which only landmark buildings are shown
All wells shown are active gas wells
Revisions shown in purple compiled in cooperation with
State of Pennsylvania agencies, from aerial photographs taken 1969
This information not field checked
Purple tint indicates extension of urban areas

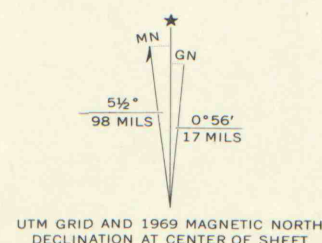

THIS MAP COMPLIES WITH NATIONAL MAP ACCURACY STANDARDS
FOR SALE BY U.S. GEOLOGICAL SURVEY, WASHINGTON, D.C. 20242
A FOLDER DESCRIBING TOPOGRAPHIC MAPS AND SYMBOLS IS AVAILABLE ON REQUEST

DIAMOND DRILL HOLE
Location Maps
A-02
3-7-D
NOT TO BE TAKEN FROM OFFICE

ROAD CLASSIFICATION
Heavy-duty ——— Light-duty ———
Medium-duty ——— Unimproved dirt ———
J. S. Route ——— State Route ———

GREENSBURG, PA.
SE/4 GREENSBURG 15 QUADRANGLE
N4015—W7930/7.5
1954
PHOTOREVISED 1969
AMS 5064 1 SE—SERIES V831

65260 #5JW/I