





Mapped, edited, and published by the Geological Survey
Control by USGS and USC&GS
Topography by photogrammetric methods from aerial
photographs taken 1969. Field checked 1969
Polyconic projection. 1927 North American datum
10,000-foot grid based on Pennsylvania coordinate system,
north zone
1000-meter Universal Transverse Mercator grid ticks,
zone 17, shown in blue
Areas covered by dashed light-blue pattern are subject to controlled
inundation
Only selected wells are shown in gas field. Numerous
wells omitted

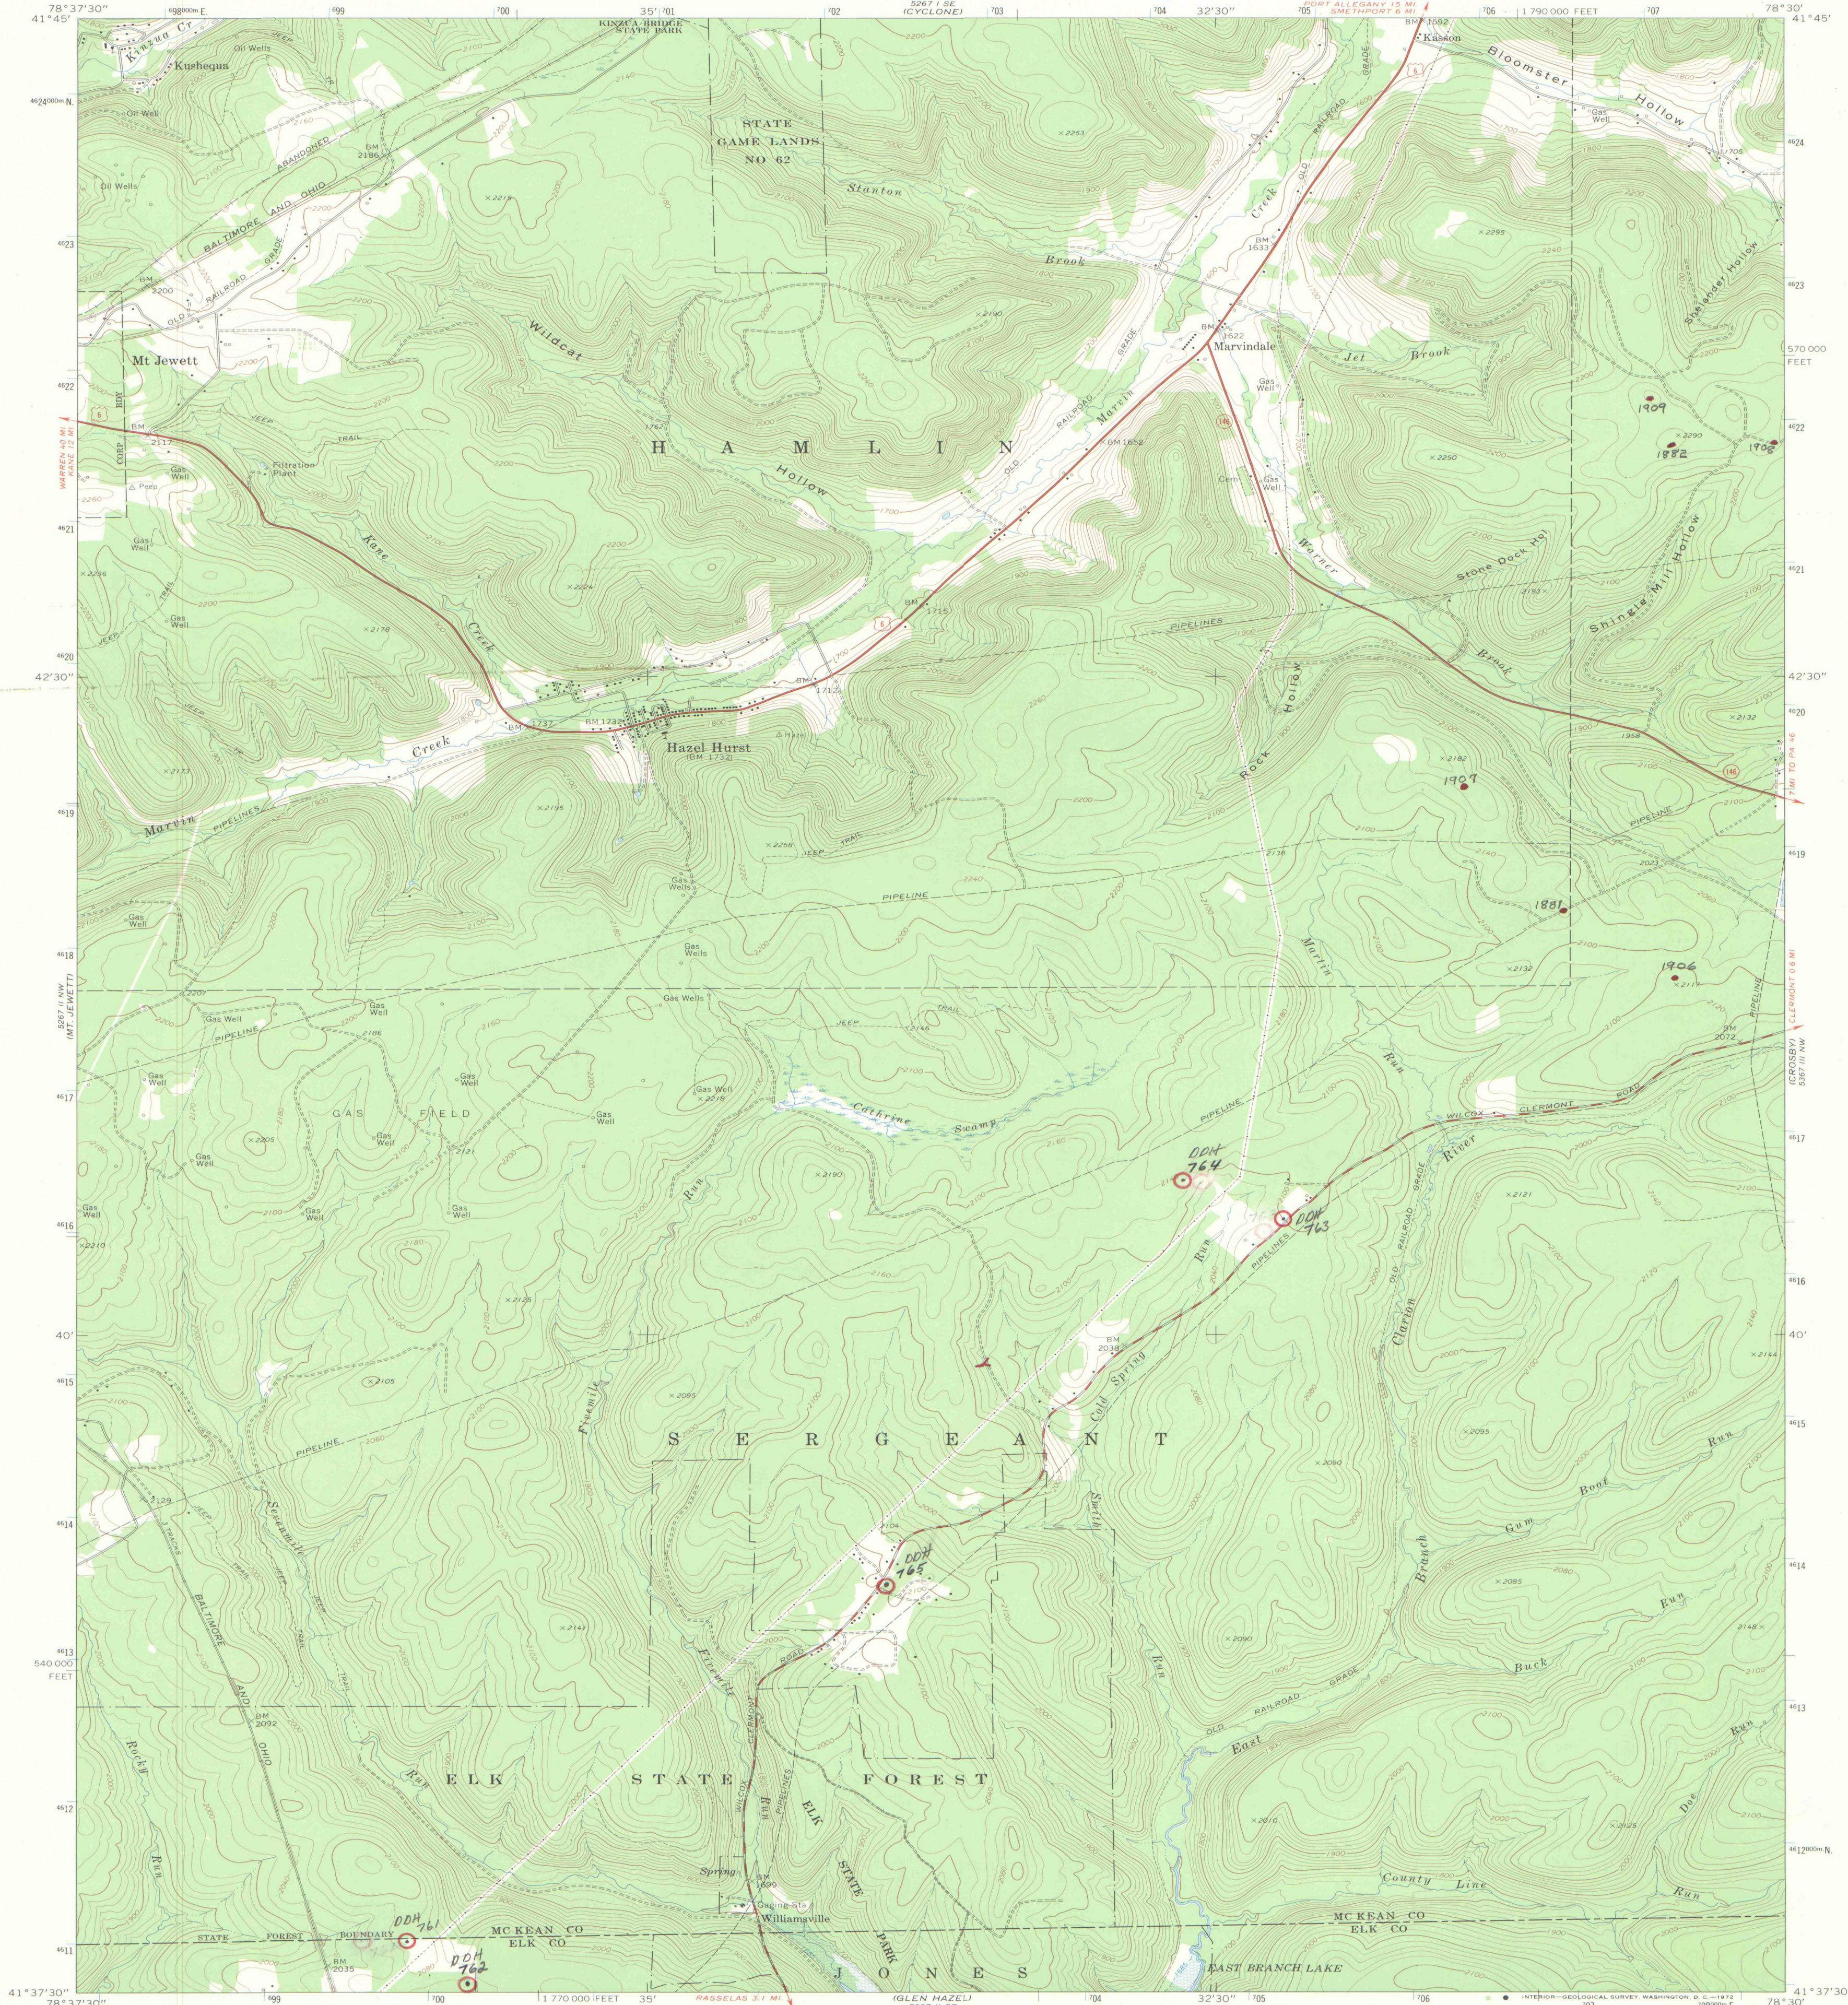

DIAMOND DRILL HOLE
Location Maps
A-02
7-2-B
NOT TO BE REMOVED FROM THE OFFICE

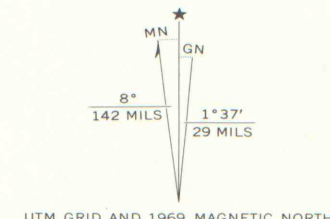

ROAD CLASSIFICATION
Primary highway, hard surface
Secondary highway, hard surface
Interstate Route
U. S. Route
State Route
Light-duty road, hard or improved surface
Unimproved road
HAZEL HURST, PA.
NE/4 MT. JEWETT 15' QUADRANGLE
N4137.5-W7830/7.5
1969
AMS 5267 II NE-SERIES W831

IMAPS # 09342