


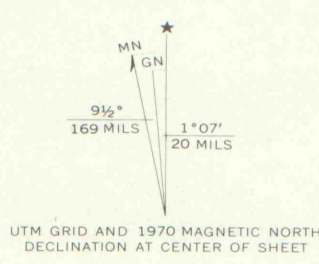


Mapped, edited, and published by the Geological Survey
Control by USGS and USC&GS
Topography by photogrammetric methods from aerial photographs
taken 1969. Field checked 1970
Polyconic projection. 1927 North American datum
10,000-foot grid based on Pennsylvania coordinate system, north zone
1000-meter Universal Transverse Mercator grid ticks,
zone 18, shown in blue



DIAMOND DRILL HOLE
Location Maps
A-02

15-3-A

NOT TO BE REMOVED FROM THE OFFICE

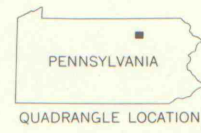

ROAD CLASSIFICATION
Primary highway, hard surface ——— Light-duty road, hard or improved surface ———
Secondary highway, hard surface ——— Unimproved road ———
Interstate Route ——— U. S. Route ——— State Route ———

HILLSGROVE, PA.
NW/4 EAGLES MERE 15' QUADRANGLE
N4122.5—W7637.5/7.5

1970

AMS 5666 1 NW-SERIES V831

IMAPS#09344