


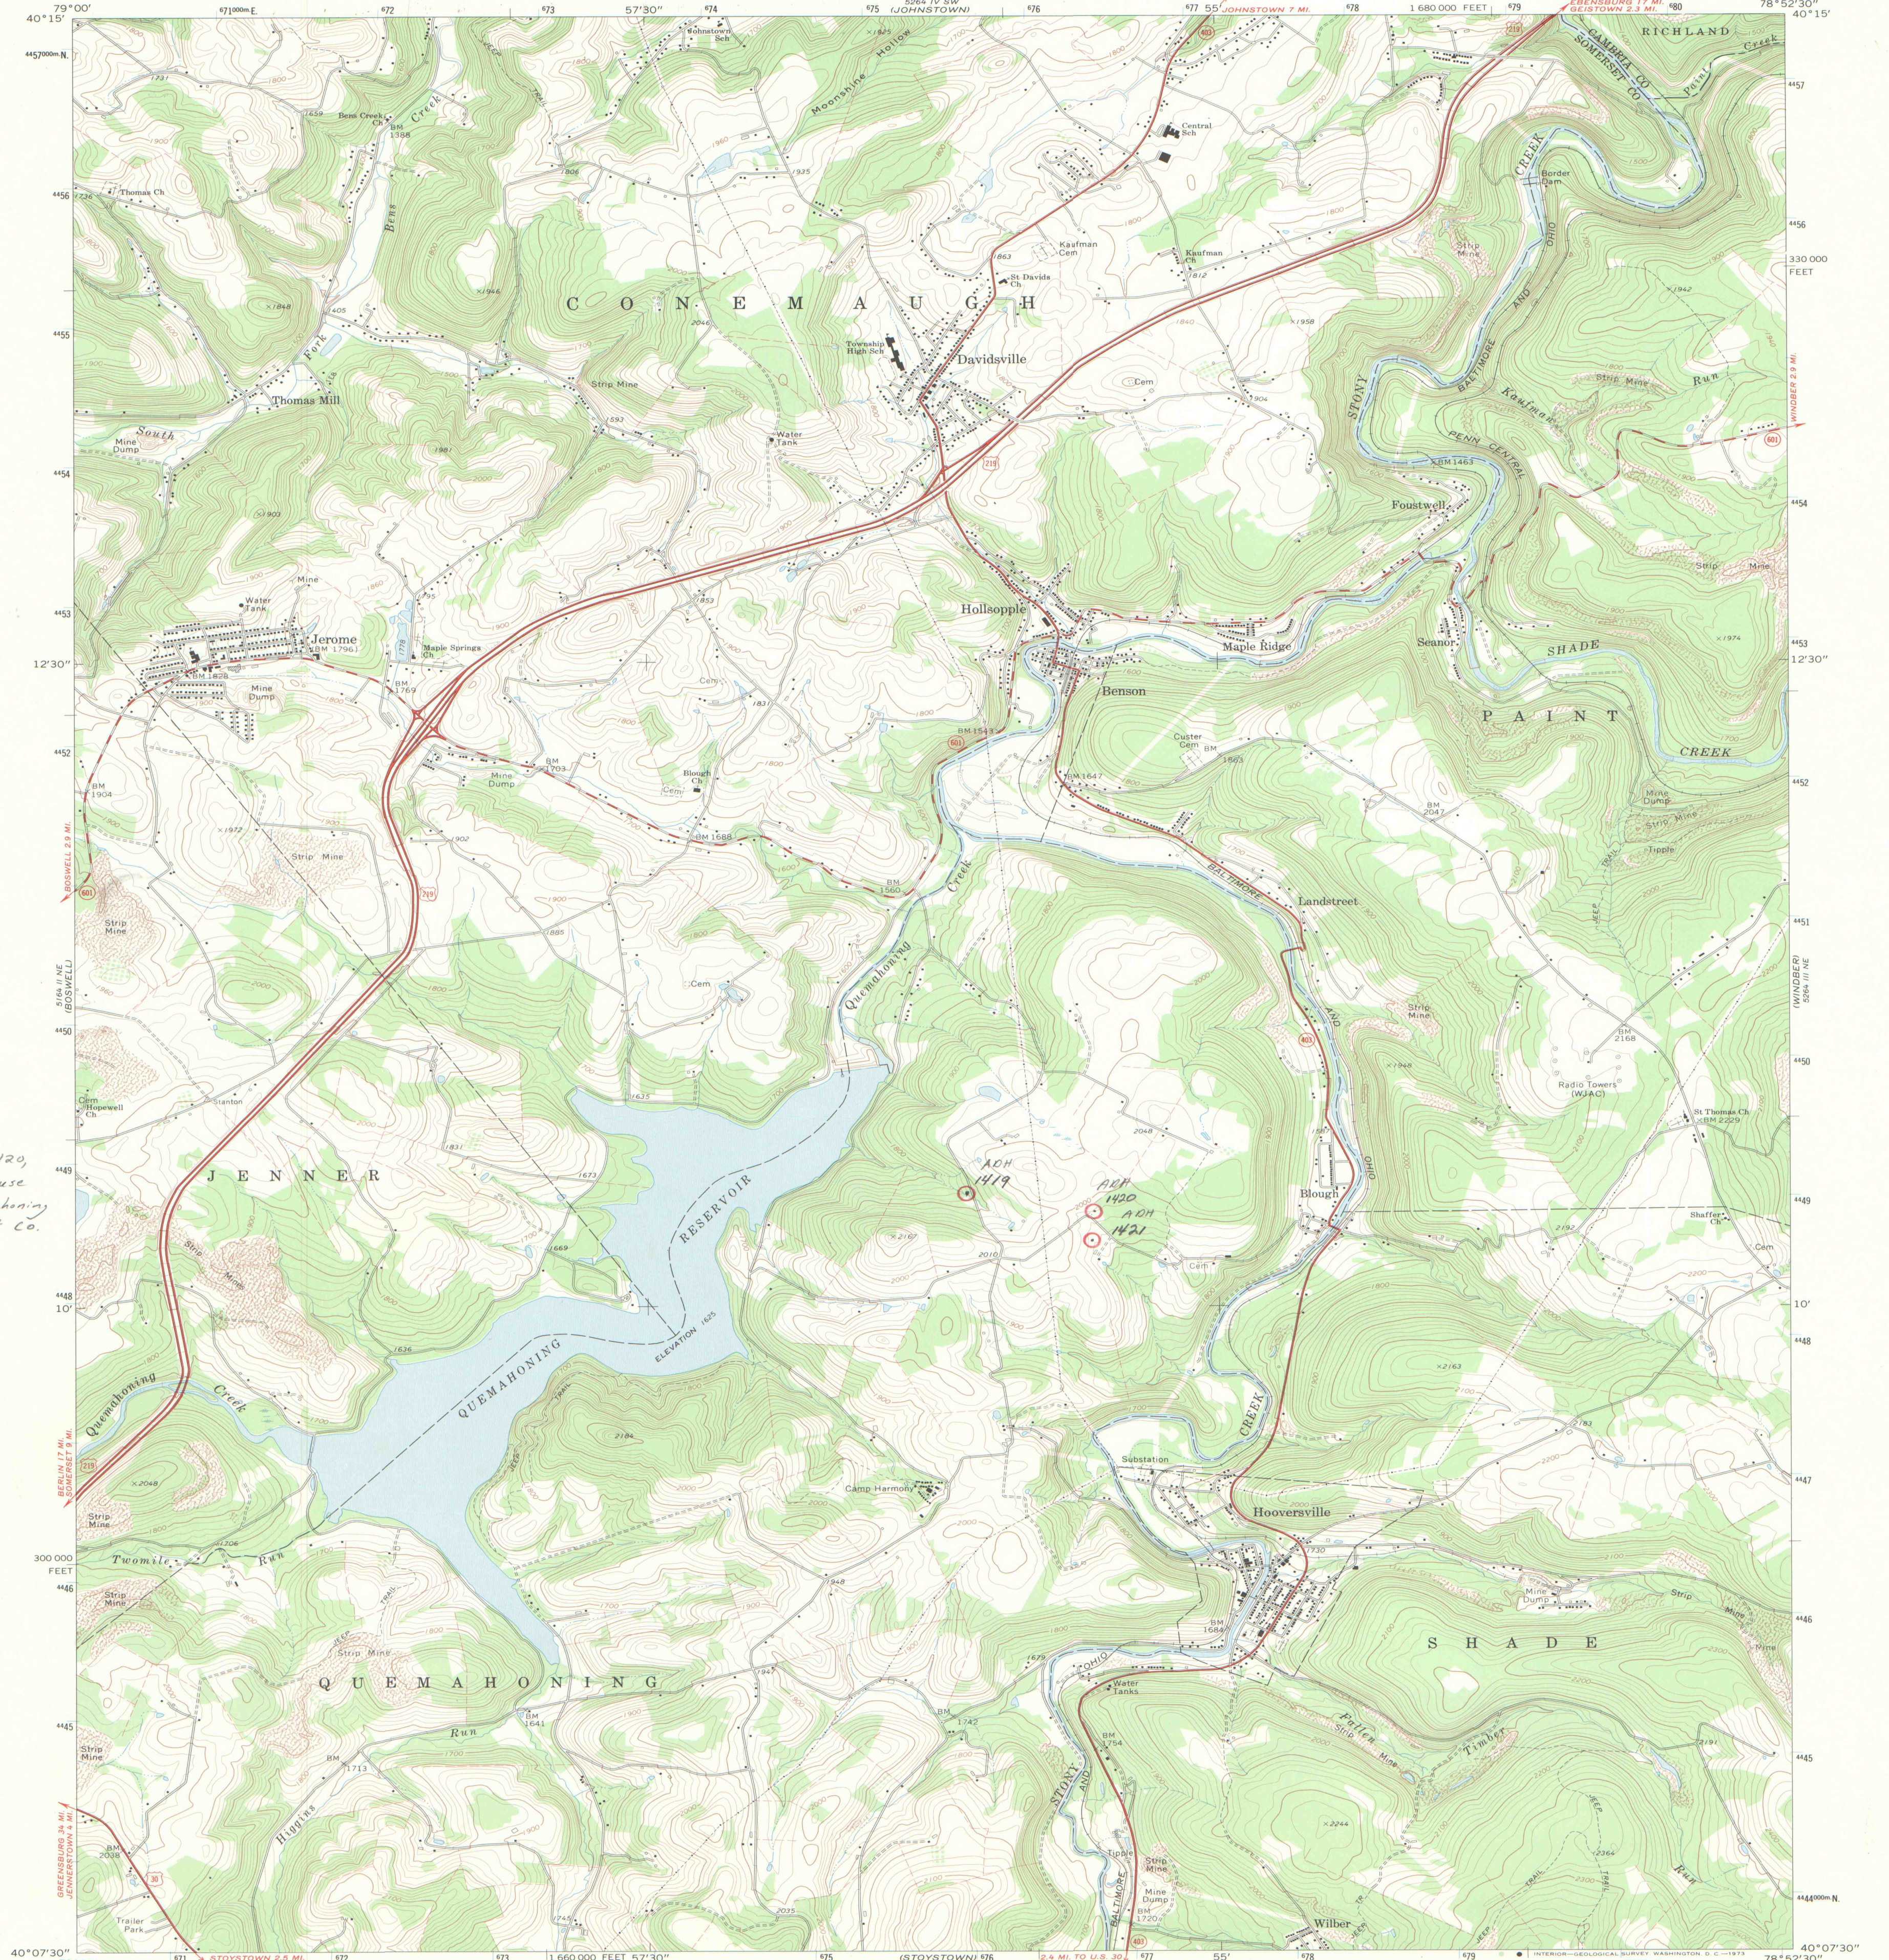


A.D.H. 1419, 1420,
1421 - Uphouse
Property, Quemaoning
Twp., Somerset Co.

A.D.H.
1419
A.D.H.
1420
A.D.H.
1421

IMAPS # 09345

A19


Mapped, edited, and published by the Geological Survey
Control by USGS and USC&GS
Topography by photogrammetric methods from aerial
photographs taken 1966 and 1967. Field checked 1971
Polyconic projection. 1927 North American datum
10,000-foot grid based on Pennsylvania coordinate system, south zone
1000-meter Universal Transverse Mercator grid ticks,
zone 17, shown in blue
Fine red dashed lines indicate selected fence and field lines where
generally visible on aerial photographs. This information is unchecked

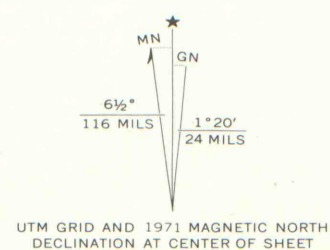

DIAMOND DRILL HOLE
Location Maps
A-02

6-8-A

NOT TO BE REMOVED FROM THE OFFICE

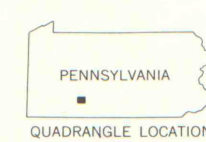

ROAD CLASSIFICATION
Primary highway, hard surface
Secondary highway, hard surface
Unimproved road
Interstate Route
U. S. Route
State Route

HOOVERSVILLE, PA.
NW 1/4 WINDBER 15' QUADRANGLE
N4007.5—W7852.5/7.5

1971
AMS 5264 III NW—SERIES W851