



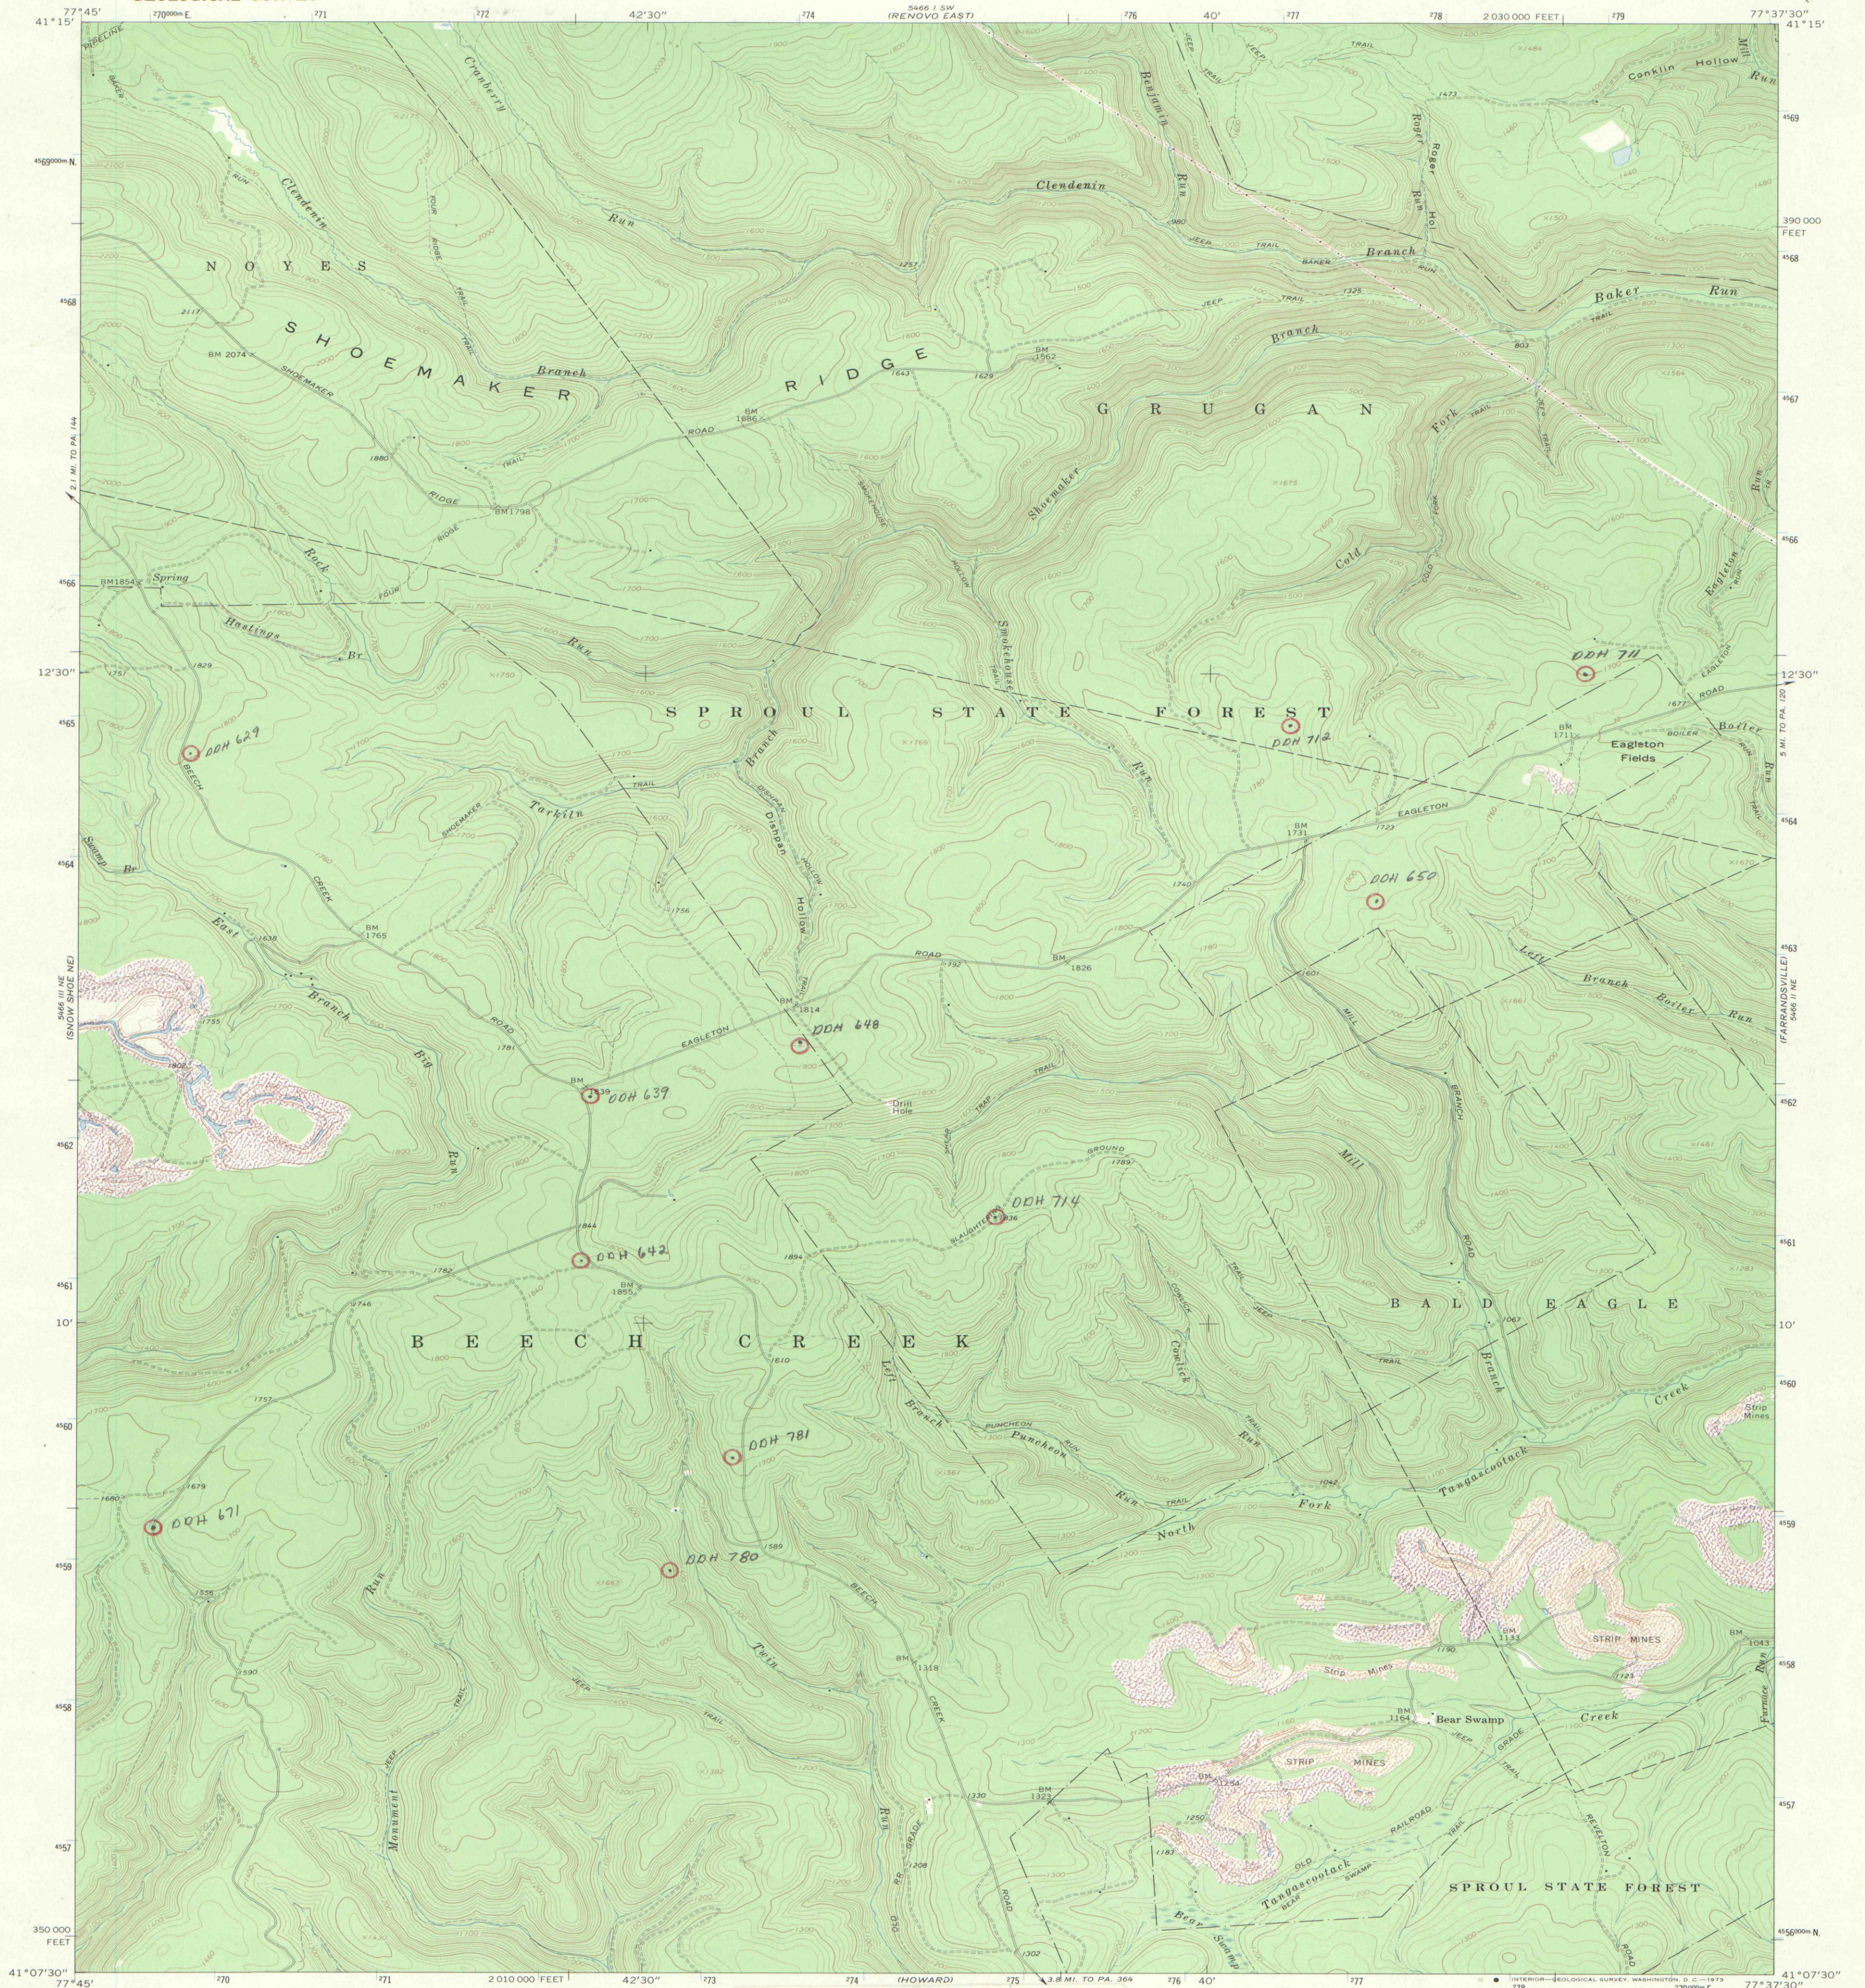

Mapped, edited, and published by the Geological Survey
Control by USGS and USC&GS
Topography by photogrammetric methods from aerial
photographs taken 1966. Field checked 1967
Polyconic projection. 1927 North American datum
10,000-foot grid based on Pennsylvania coordinate system,
north zone
1000-meter Universal Transverse Mercator grid ticks,
zone 18, shown in blue
Revisions shown in purple compiled in cooperation with
State of Pennsylvania agencies from aerial photographs
taken 1973. This information not field checked

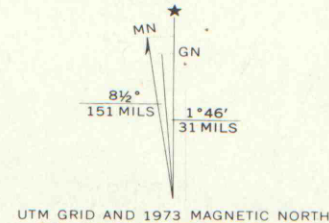


DIAMOND DRILL HOLE
Location Maps
A-02

11-4-A

NOT TO BE TAKEN FROM THE OFFICE

A FOLDER DESCRIBING TOPOGRAPHIC MAPS AND SYMBOLS IS AVAILABLE ON REQUEST

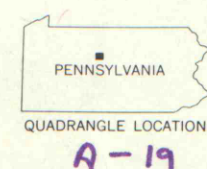

ROAD CLASSIFICATION
Light-duty ————— Unimproved dirt - - - - -

HOWARD NW, PA.
N4107.5—W7737.5/7.5

1967
PHOTO REVISOR 1973
AMS 5466 II NW—SERIES V831

IMAPS#09346