

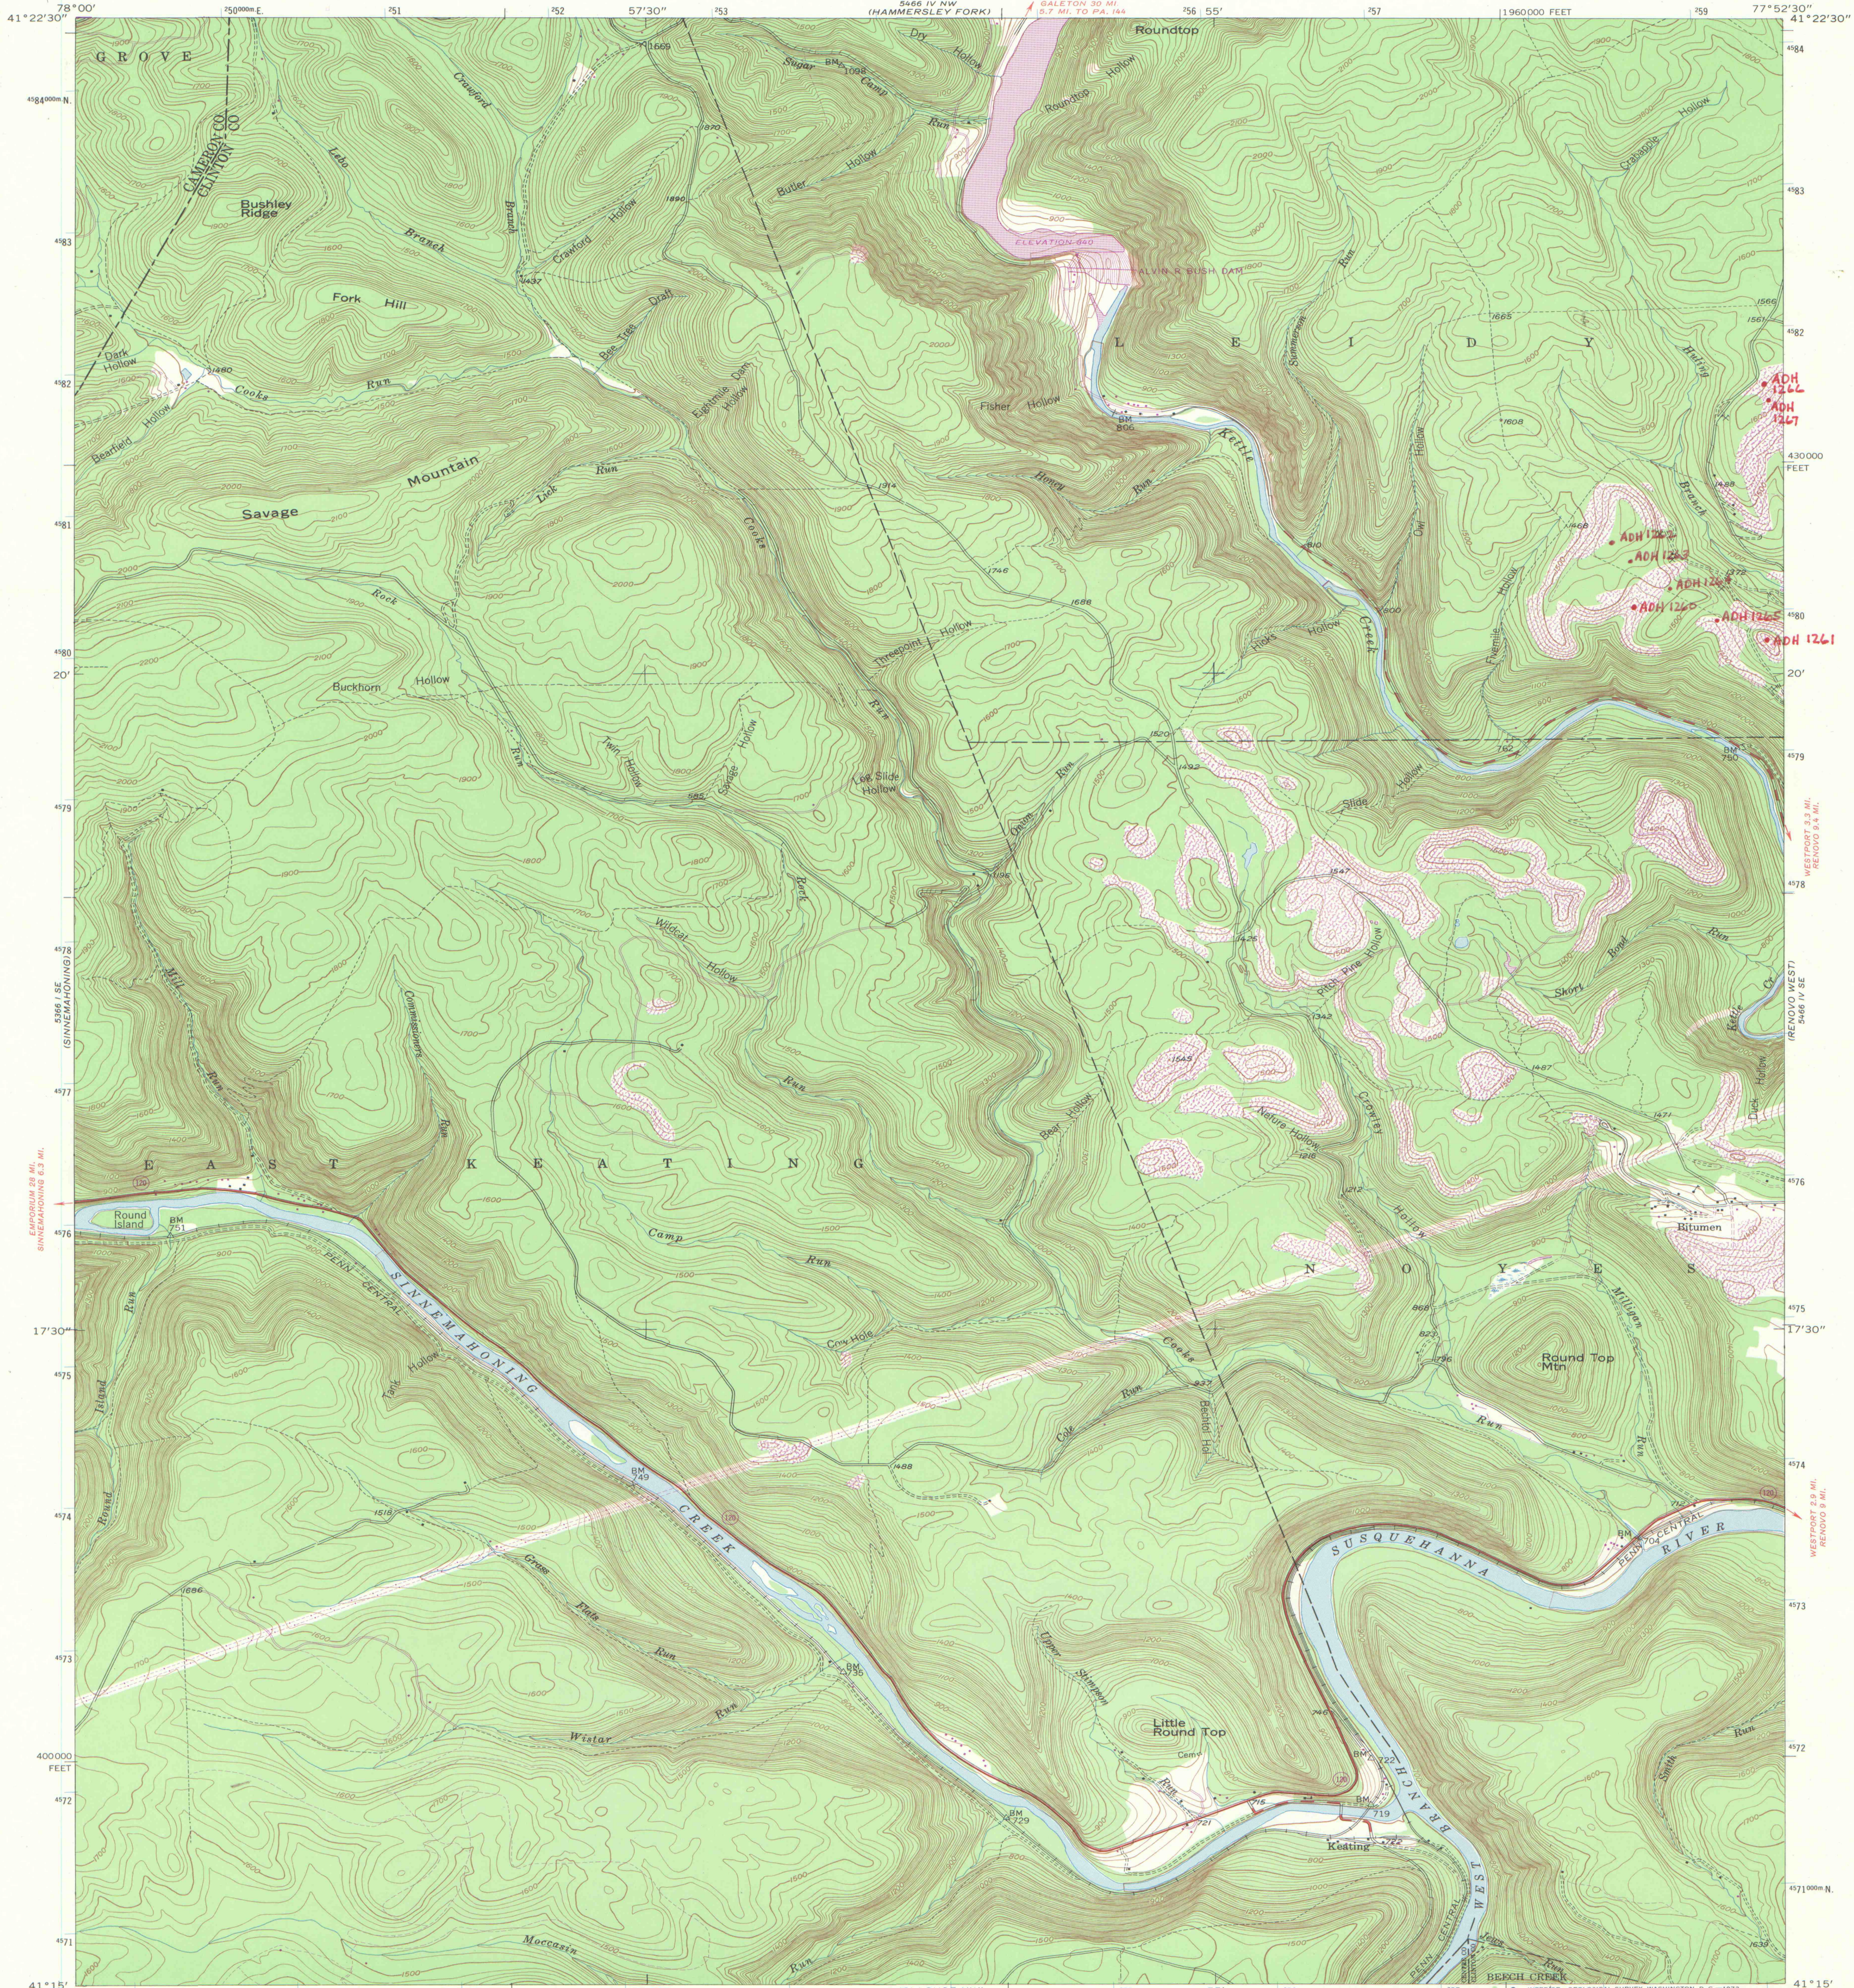


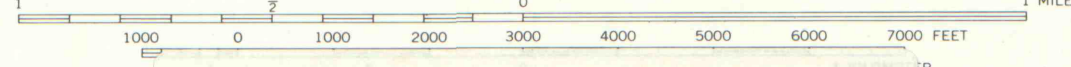

Mapped, edited, and published by the Geological Survey  
Control by USGS and USC&GS  
Topography from aerial photographs by multiplex methods  
Aerial photographs taken 1944. Field check, 1946  
Polyconic projection. 1927 North American datum  
10 000-foot grid based on Pennsylvania coordinate system,  
north zone  
1000-meter Universal Transverse Mercator grid ticks,  
zone 18, shown in blue  
Area below elevation 937 is subject to controlled  
inundation by Alvin R. Bush Dam  
Revisions shown in purple compiled in cooperation with State of  
Pennsylvania agencies from aerial photographs taken 1971. This  
information not field checked

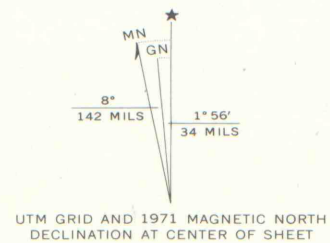


DIAMOND DRILL HOLE  
Location Maps  
A-02

10-3-C

FOR SALE BY U.S. GEOLOGICAL SURVEY, WASHINGTON, D.C. 20542  
A FOLDER DESCRIBING TOPOGRAPHIC MAPS AND SYMBOLS IS AVAILABLE ON REQUEST

NOT TO BE REMOVED FROM THIS DEPARTMENT

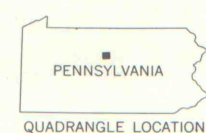

ROAD CLASSIFICATION  
HARD-SURFACE ALL WEATHER ROADS  
Heavy-duty...  
Medium-duty...  
Loose-surface, graded, or narrow hard-surface  
DRY WEATHER ROADS  
Improved dirt...  
Unimproved dirt...  
State Route

KEATING, PA.  
SW 1/4 RENOV WEST 15 QUADRANGLE  
N4115-W7752.5/7.5

1946  
PHOTOREVISED 1971  
AMS 5466 IV SW-SERIES V831

IMAPS #09347