




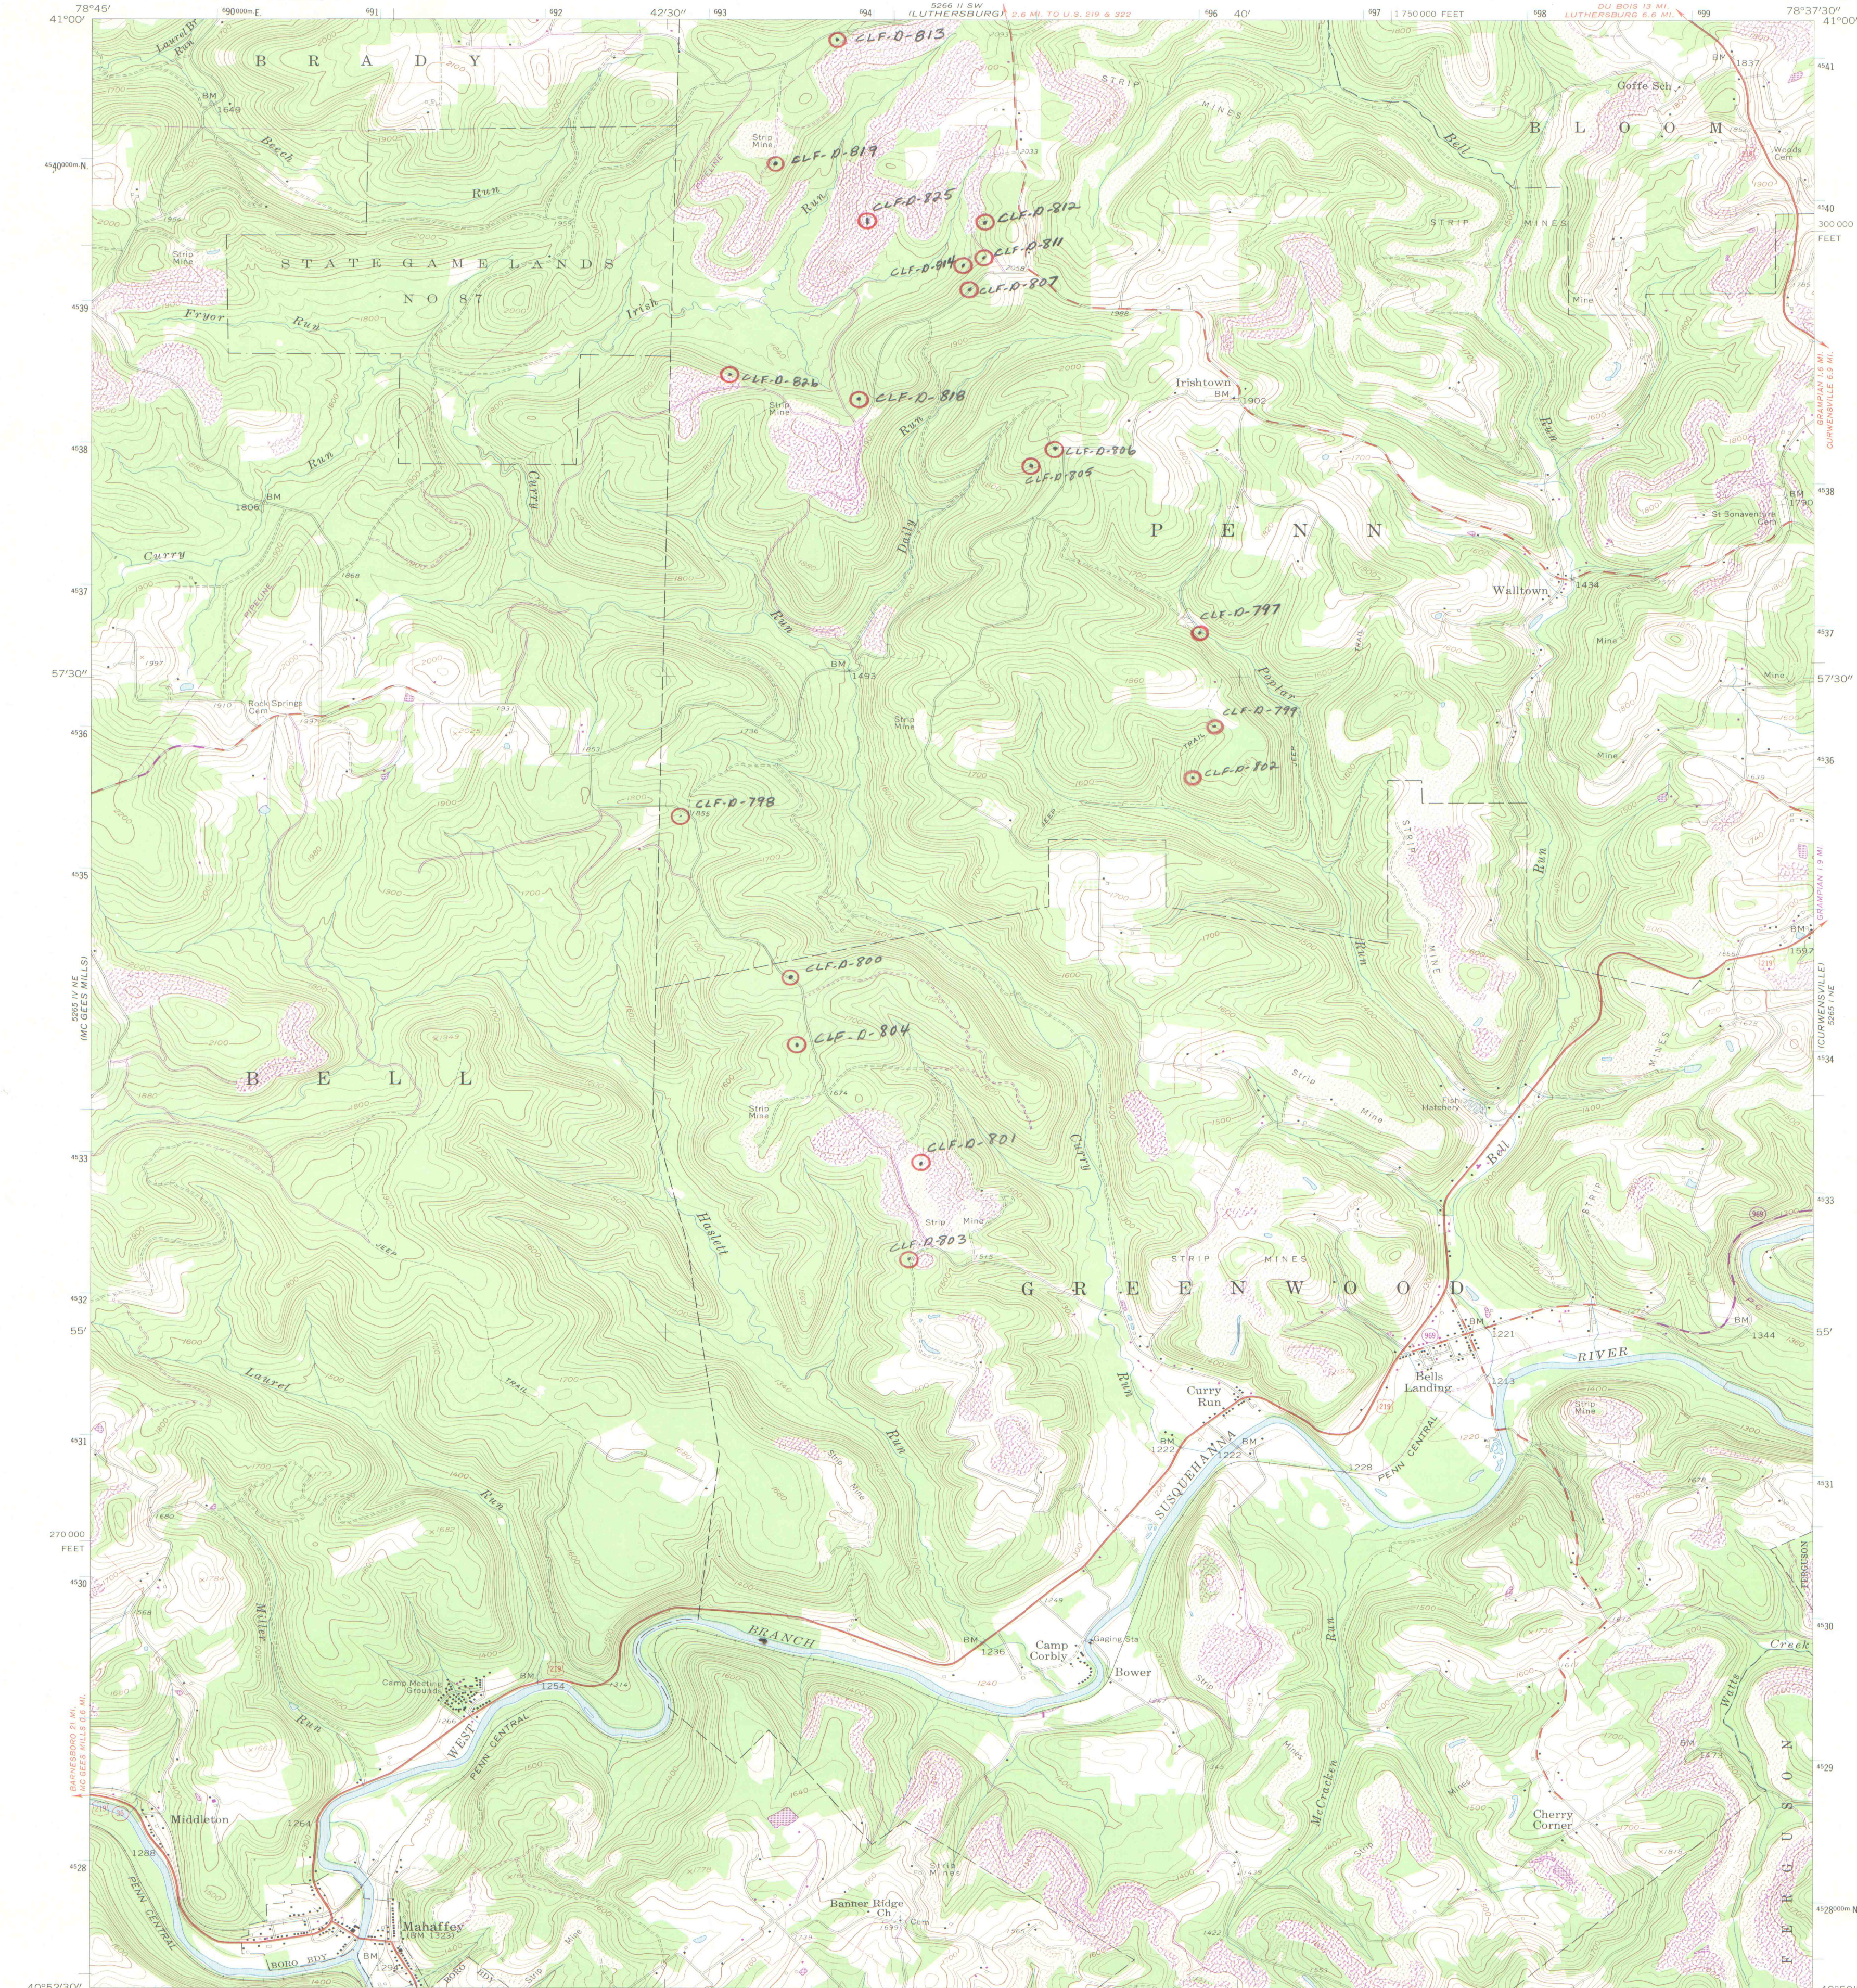

Mapped, edited, and published by the Geological Survey
Control by USGS and USC&GS
Topography from aerial photographs by photogrammetric methods
Aerial photographs taken 1957. Field check 1959
Polyconic projection. 1927 North American datum
10,000-foot grid based on Pennsylvania coordinate system,
north zone
1000-meter Universal Transverse Mercator grid ticks,
zone 17, shown in blue
Fine red dashed lines indicate selected fence and field lines
visible on aerial photographs. This information is unchecked
Revisions shown in purple compiled in cooperation with
State of Pennsylvania agencies from aerial photographs
taken 1971. This information not field checked

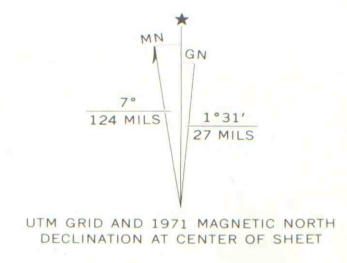

DIAMOND DRILL HOLE
Location Map
A-02 (7-5-A)
NOT TO BE TAKEN FROM OFFICE
NOT TO BE REMOVED FROM THE OFFICE

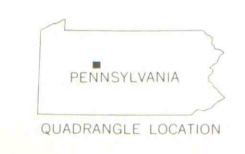

ROAD CLASSIFICATION
Heavy-duty ——— Light-duty ———
Medium-duty ——— Unimproved dirt ———
U.S. Route ——— State Route ———
MAHAFFEY, PA.
N4052.5-W7837.5/7.5
1959
PHOTOREVISED 1971
AMS 5265 1 NW-SERIES V831

IMAPS#09355