


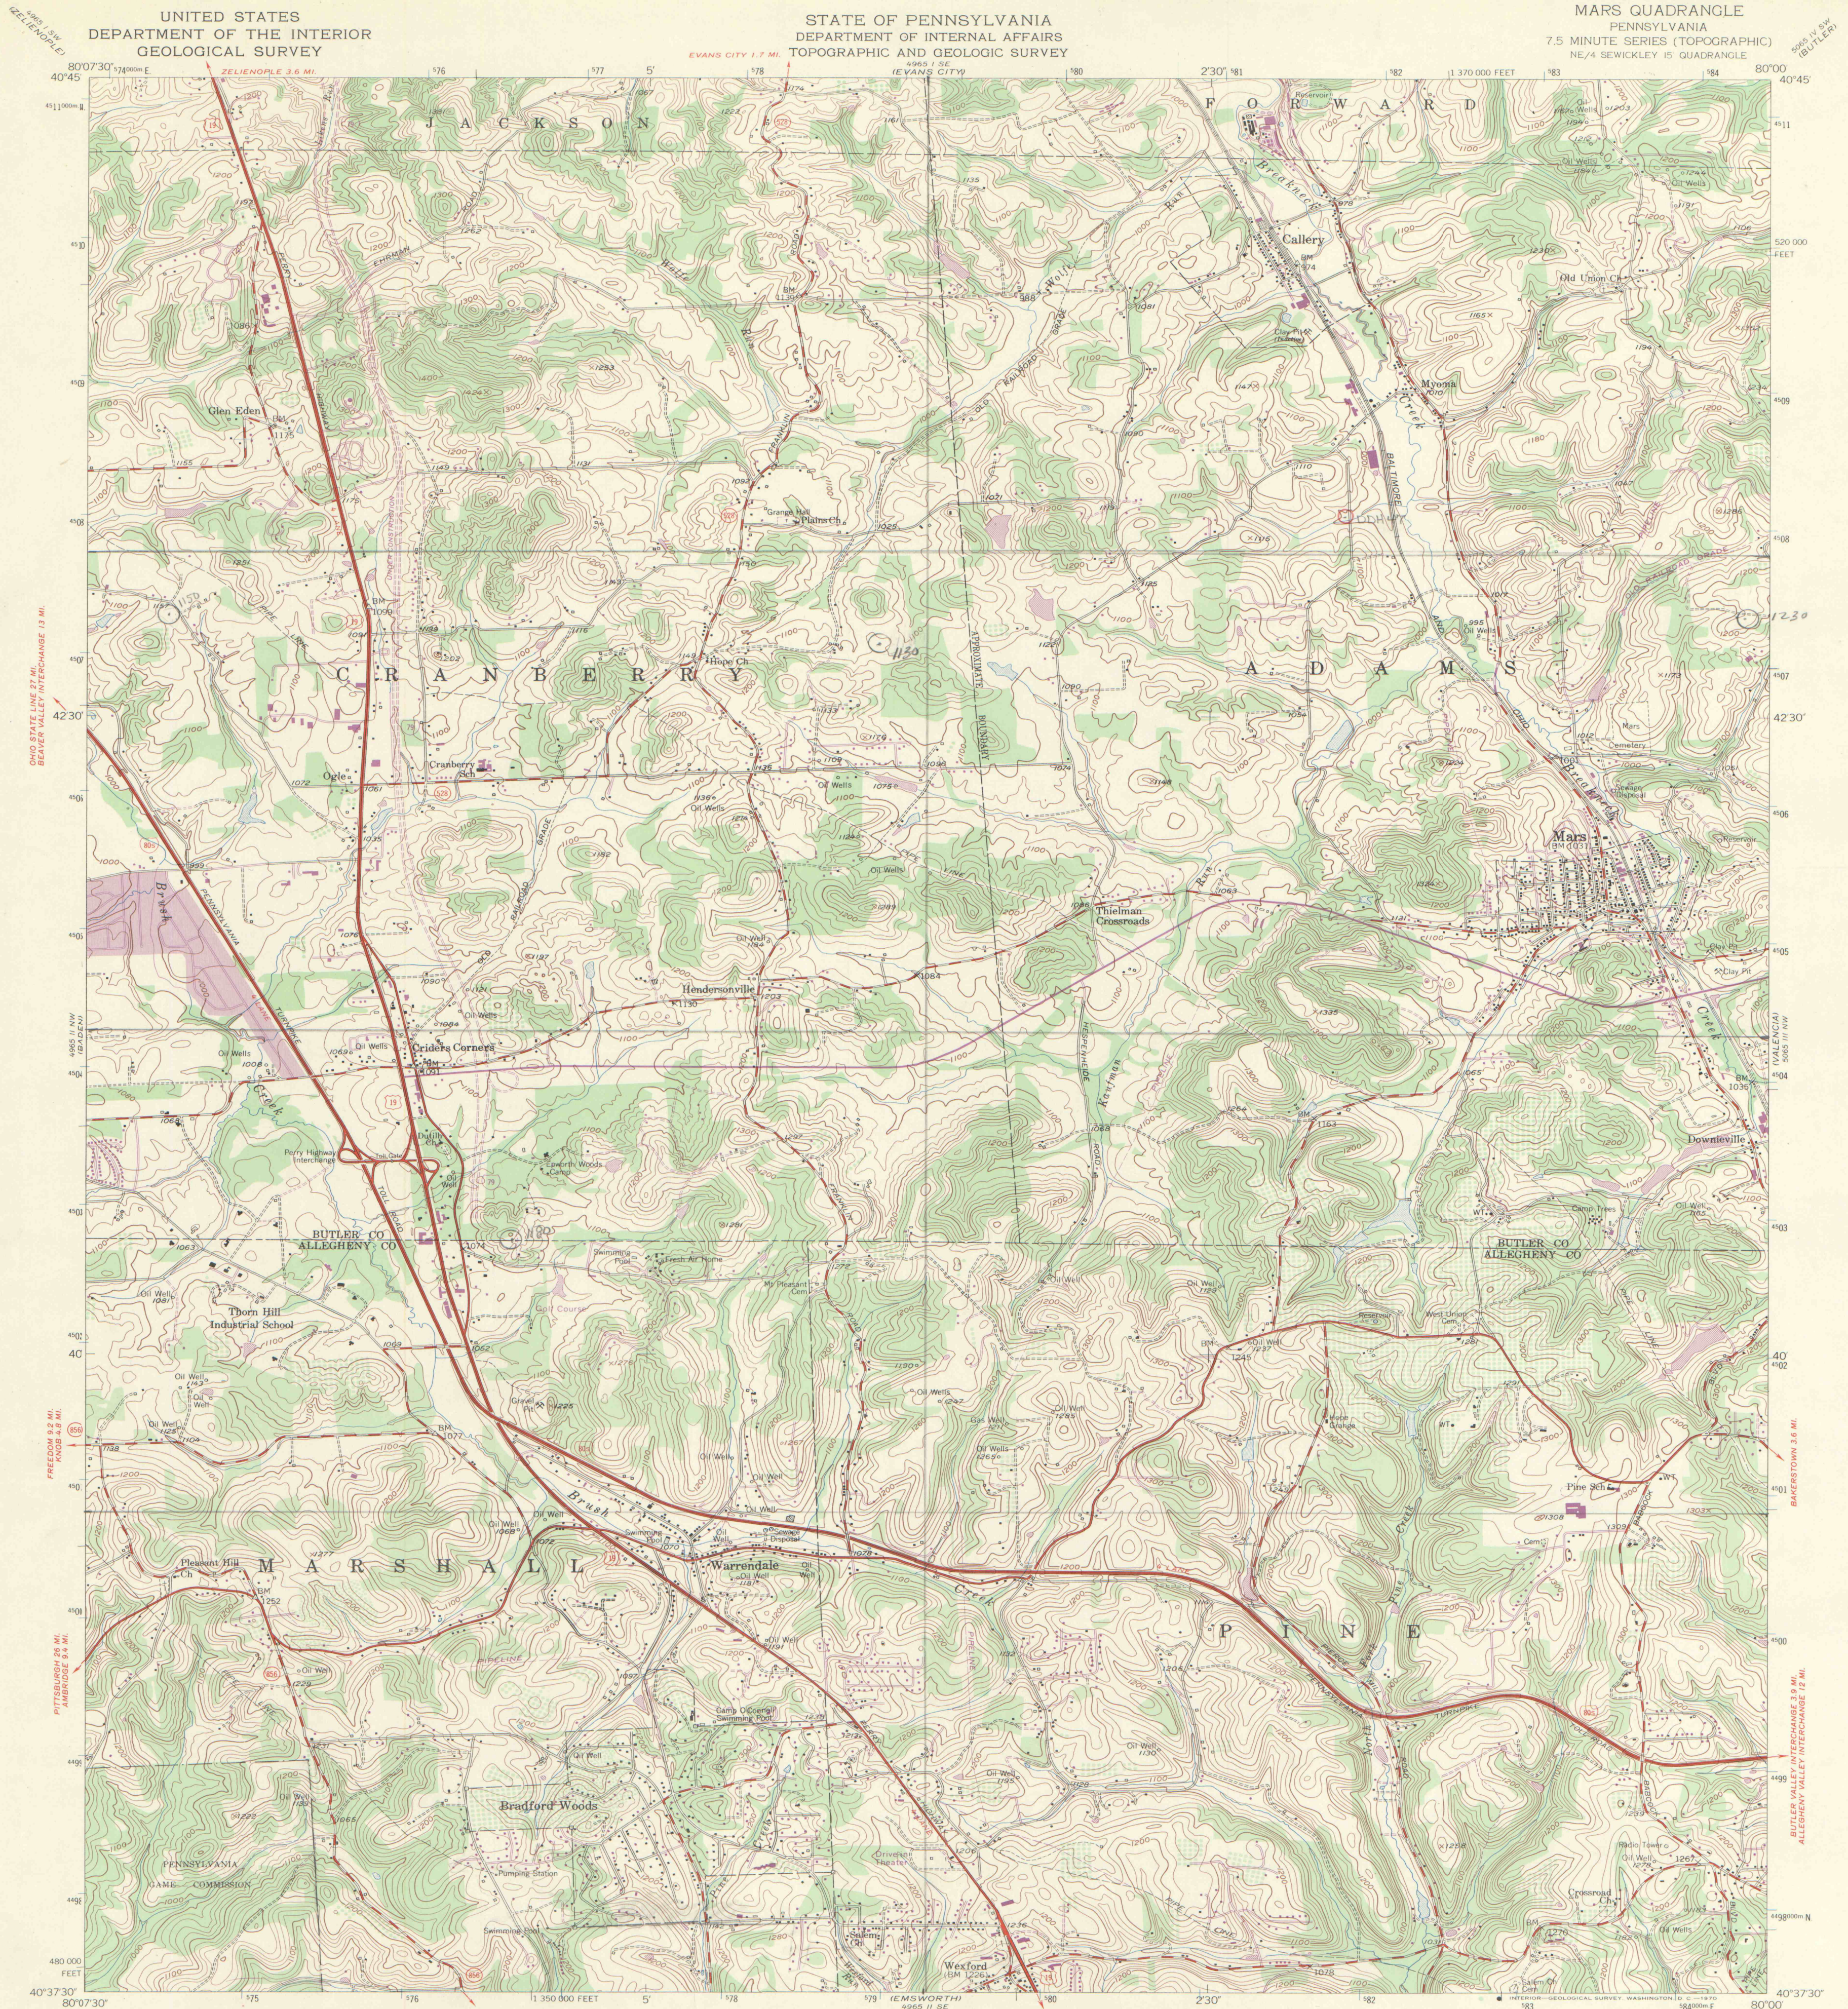

Mapped, edited, and published by the Geological Survey
Control by USGS and USC&GS

Topography from aerial photographs by multiplex methods
Aerial photographs taken 1952. Field check 1953

Polyconic projection. 1927 North American datum
10,000 foot grid based on Pennsylvania coordinate system,
south zone
1000-meter Universal Transverse Mercator grid ticks, zone 17,
shown in blue

Revisions shown in purple compiled in cooperation with
State of Pennsylvania agencies, from aerial photographs taken 1969
This information not field checked

Purple tint indicates extension of urban areas

Scale 1:24,000

DIAMOND DRILL HOLE
Location Maps
A-02
1-6-B

NOT TO BE TAKEN FROM OFFICE

ROAD CLASSIFICATION

Heavy-duty	Light-duty
Medium-duty	Unimproved dirt
U.S. Route	State Route
	Interstate Route

MARS, PA.
NE/4 SEWICKLEY 15' QUADRANGLE
N4037.5—W8000.7.5

1953
PHOTOREVISED 1969
AMS 4965 II NE—SERIES V831

IMAPS #09360