


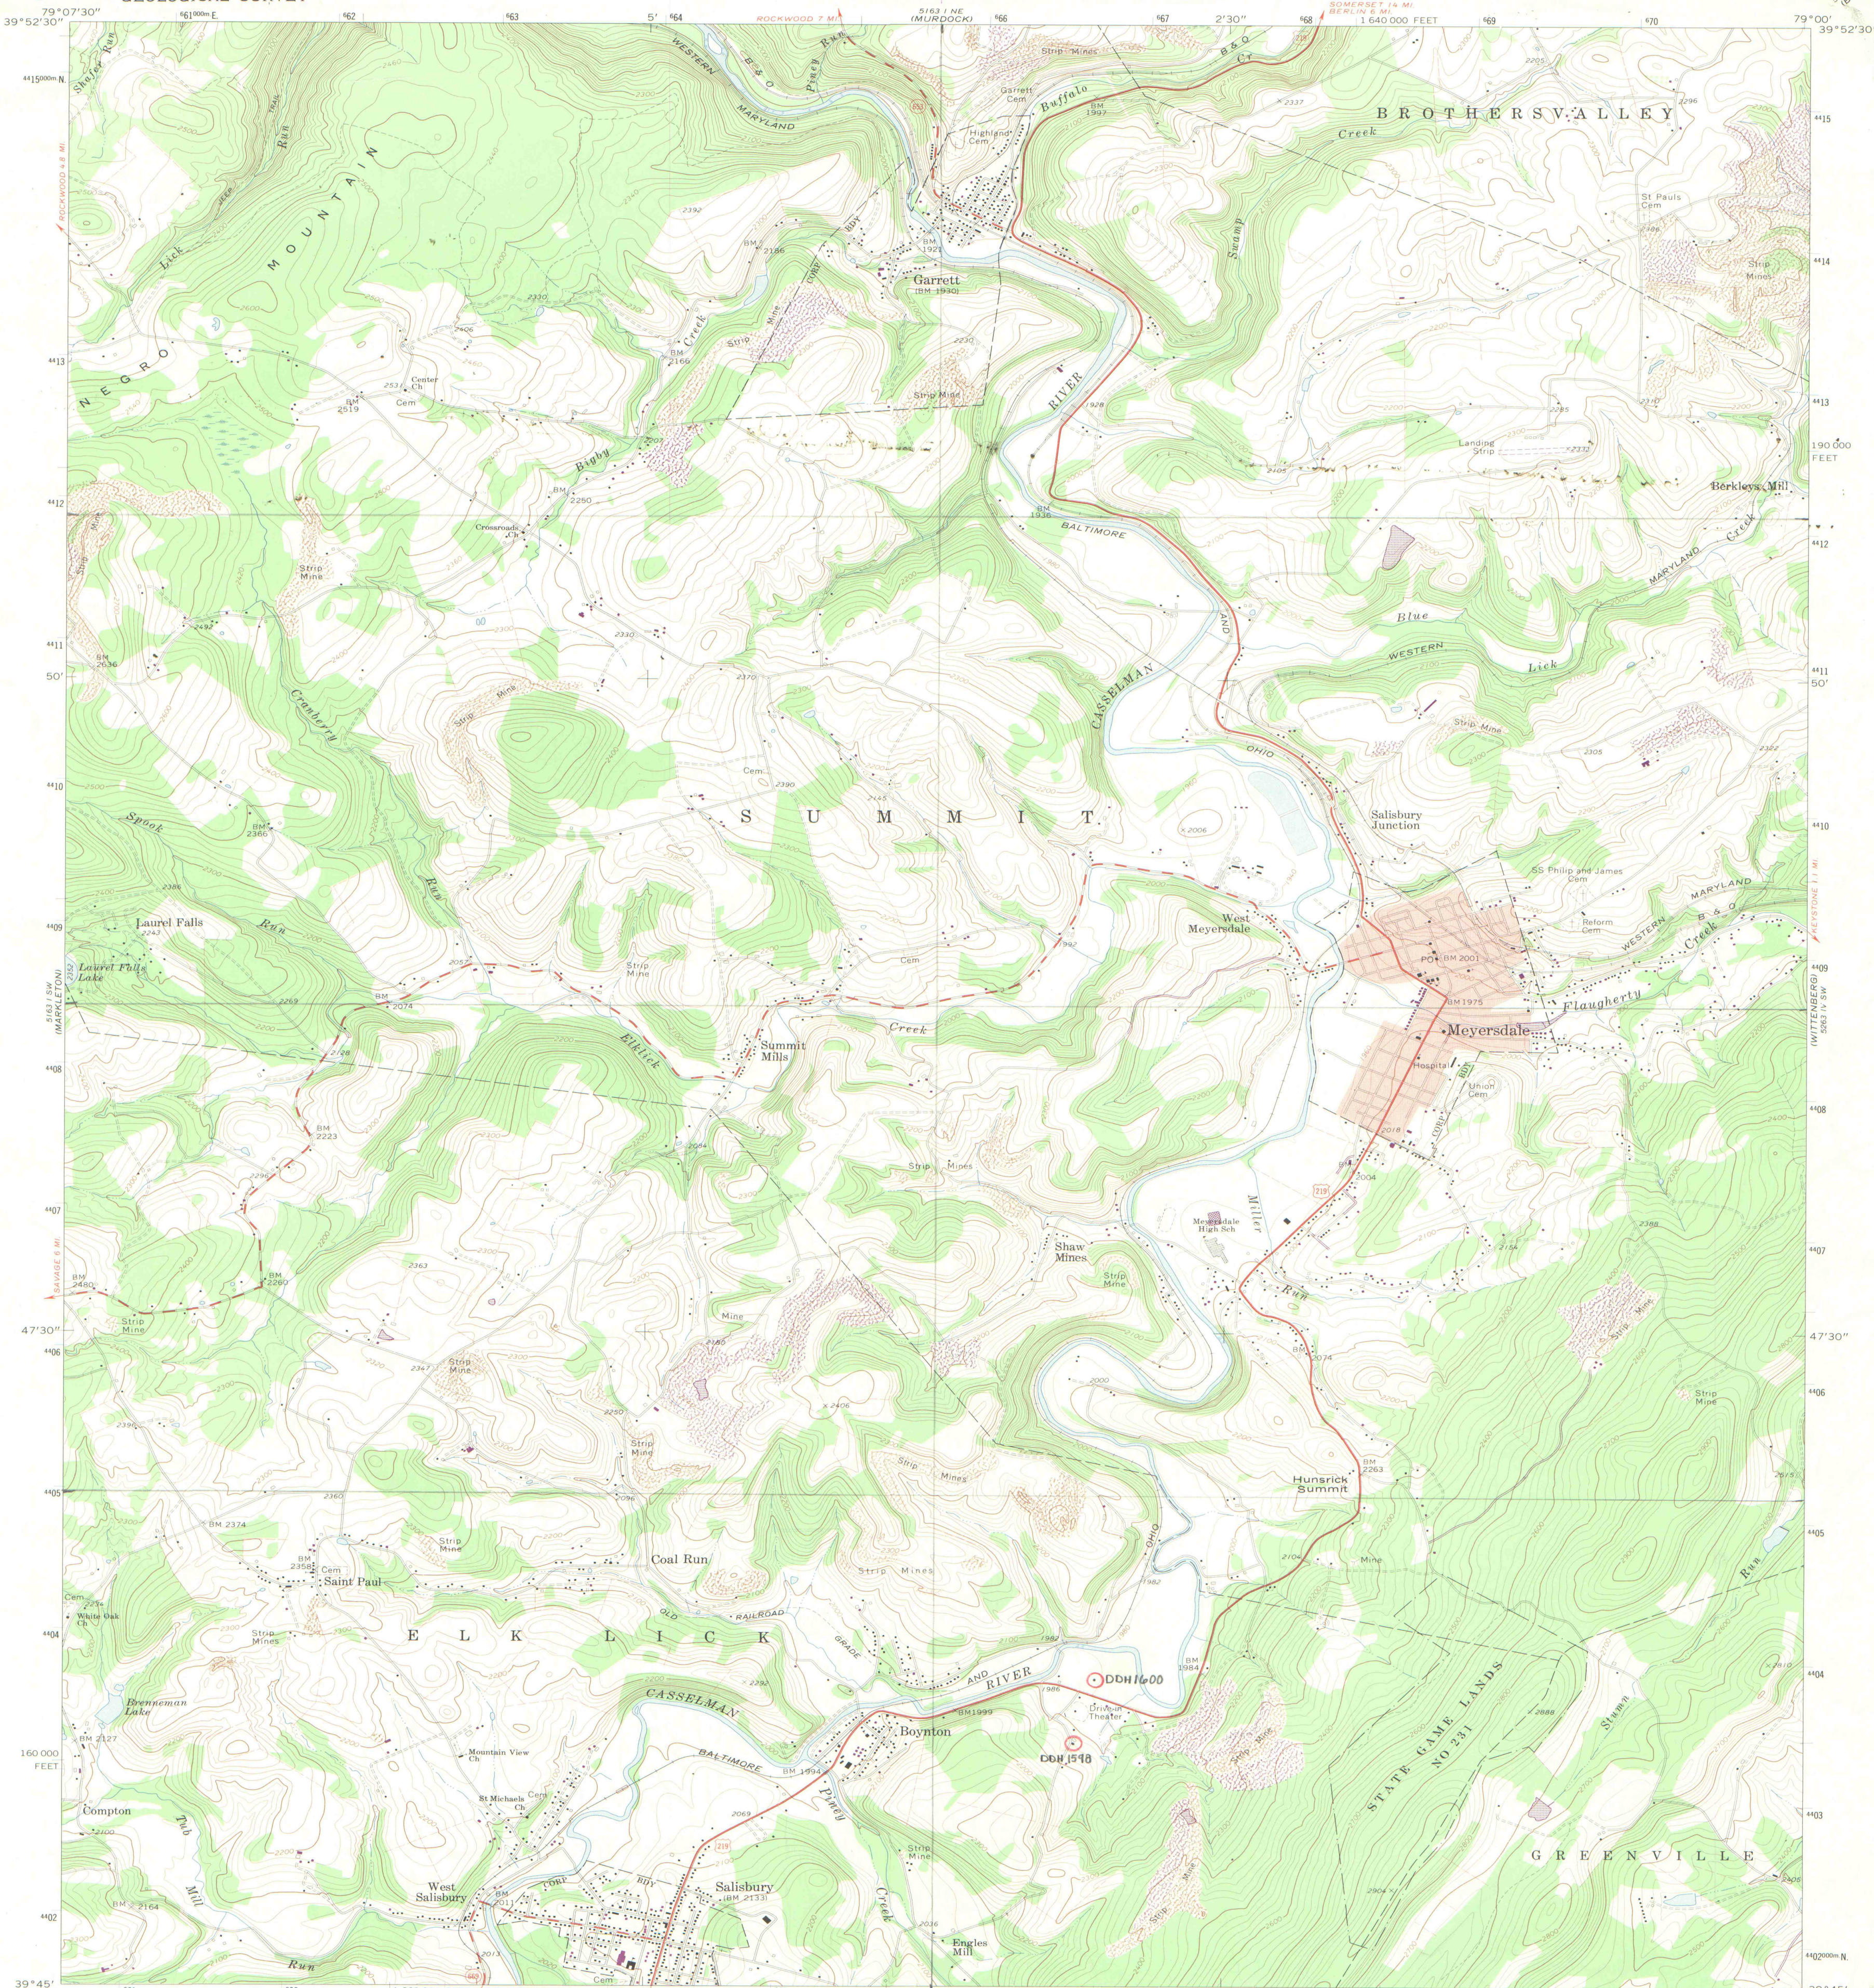

Mapped, edited, and published by the Geological Survey

Control by USGS and USC&GS


Topography by photogrammetric methods from aerial

photographs taken 1966. Field checked 1968

Polycyclic projection. 1927 North American datum  
10,000-foot grid based on Pennsylvania coordinate system, south zone  
1000-meter Universal Transverse Mercator grid ticks,  
zone 17, shown in blue

Fine red dashed lines indicate selected fence and field lines where  
generally visible on aerial photographs. This information is unchecked  
Red tint indicates area in which only landmark buildings are shown

Revisions, shown in purple, compiled in cooperation with  
State of Pennsylvania agencies from aerial photographs  
taken 1973. This information not field checked

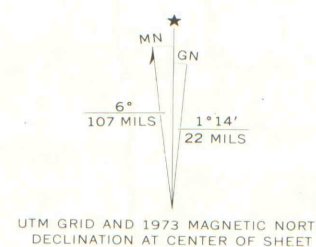

DIAMOND DRILL HOLE  
Location Maps  
A-02

5-9-D

NOT TO BE TAKEN FROM OFFICE

| ROAD CLASSIFICATION                |                                              |
|------------------------------------|----------------------------------------------|
| Primary highway,<br>hard surface   | Light-duty road, hard or<br>improved surface |
| Secondary highway,<br>hard surface | Unimproved road                              |
| Interstate Route                   | U. S. Route                                  |
|                                    | State Route                                  |

MEYERSDALE, PA.

N3945—W7900/7.5

1968

PHOTOREVISED 1973  
AMS 5163 1 SE—SERIES V831

PEN-ON-WES-MAP CO.  
336 FOURTH AVE. ROOM 511  
PITTSBURGH, PA. 15222

MAP # 09363