


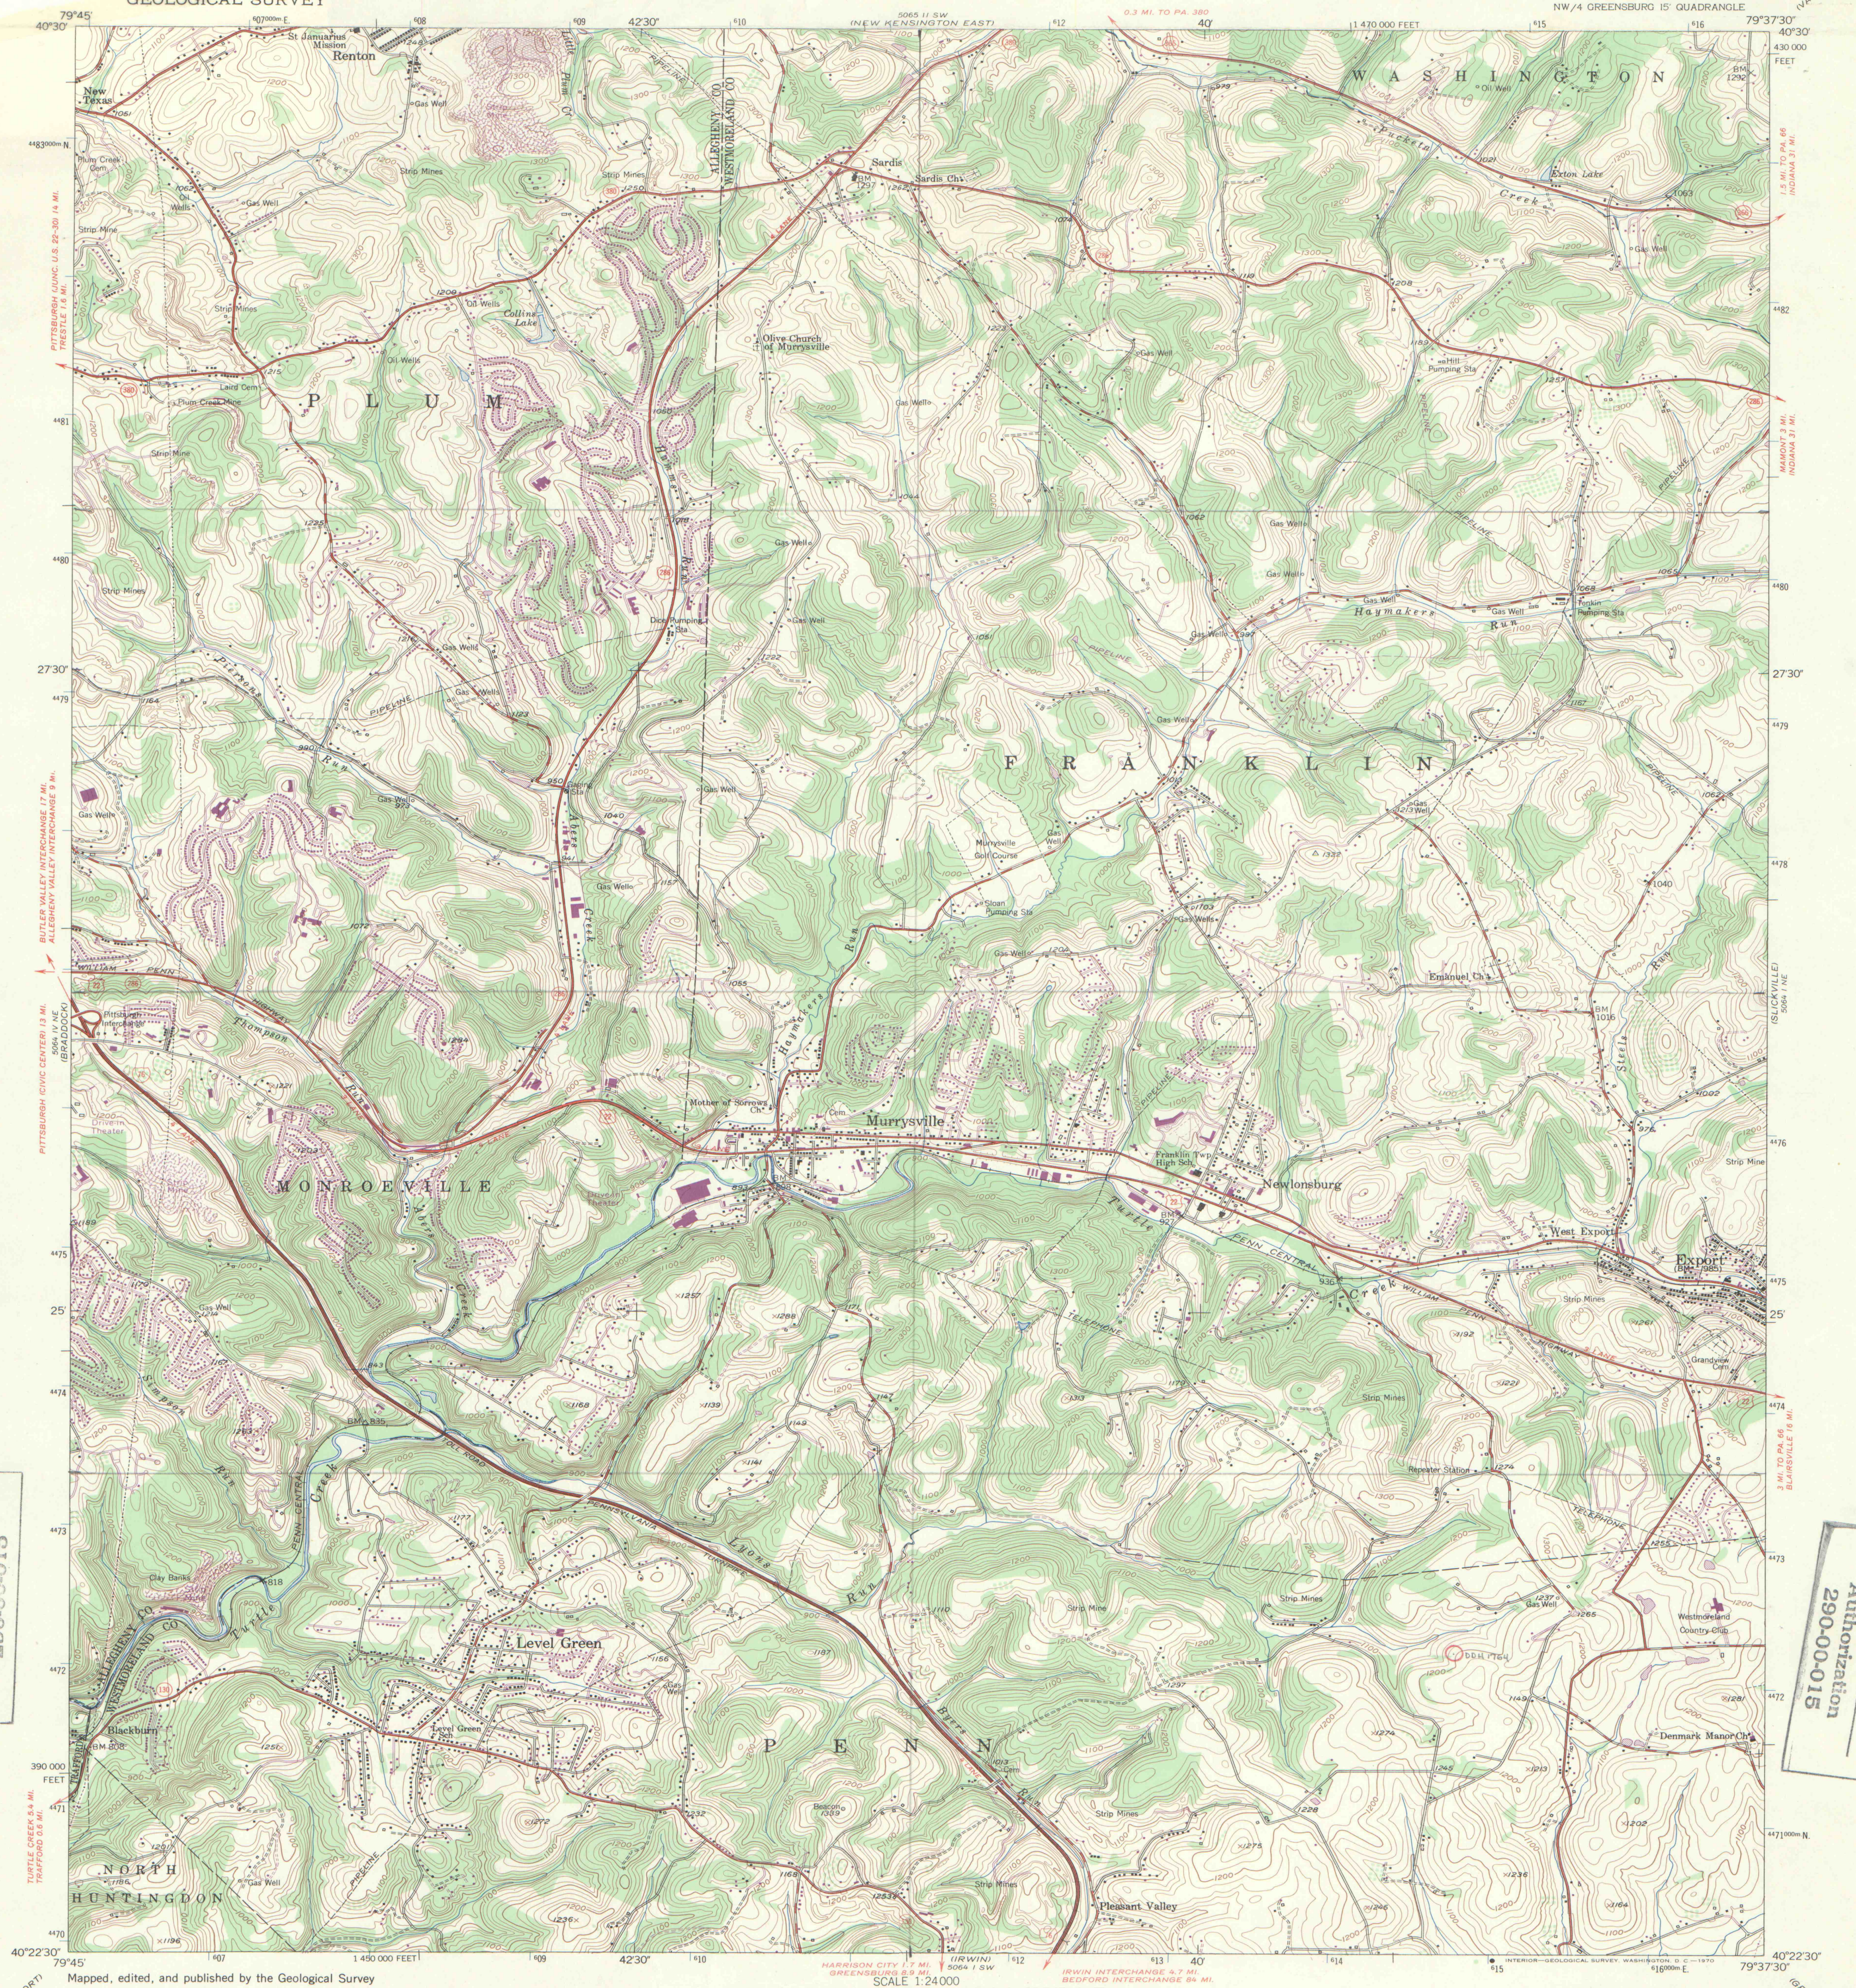

Exploration Services
Division
Authorization
290-00-015

Exploration Services
Division
Authorization
290-00-015

Mapped, edited, and published by the Geological Survey
Control by USGS and USC&GS
Topography from aerial photographs by multiplex methods
Aerial photographs taken 1952. Field check 1953
Polyconic projection. 1927 North American datum
10,000-foot grid based on Pennsylvania coordinate system, south zone
1000-meter Universal Transverse Mercator grid ticks, zone 17,
shown in blue
Revisions shown in purple compiled in cooperation with
State of Pennsylvania agencies, from aerial photographs taken 1969
This information not field checked

UTM GRID AND 1969 MAGNETIC NORTH
DECLINATION AT CENTER OF SHEET

DIAMOND DRILL HOLE
Location Maps
A-02

3-7-A

NOT TO BE TAKEN FROM THE OFFICE

ROAD CLASSIFICATION
Heavy-duty ——— Light-duty ———
Medium-duty ——— Unimproved dirt ———
U.S. Route ——— State Route ———
Interstate Route ———
MURRYSVILLE, PA.
NW/4 GREENSBURG 15' QUADRANGLE
N4022.5—W7937.5/7.5

PENNSYLVANIA
QUADRANGLE LOCATION

1953
PHOTOREVISED 1969
AMS 5064 1 NW—SERIES V831

IMAPS # 09366