


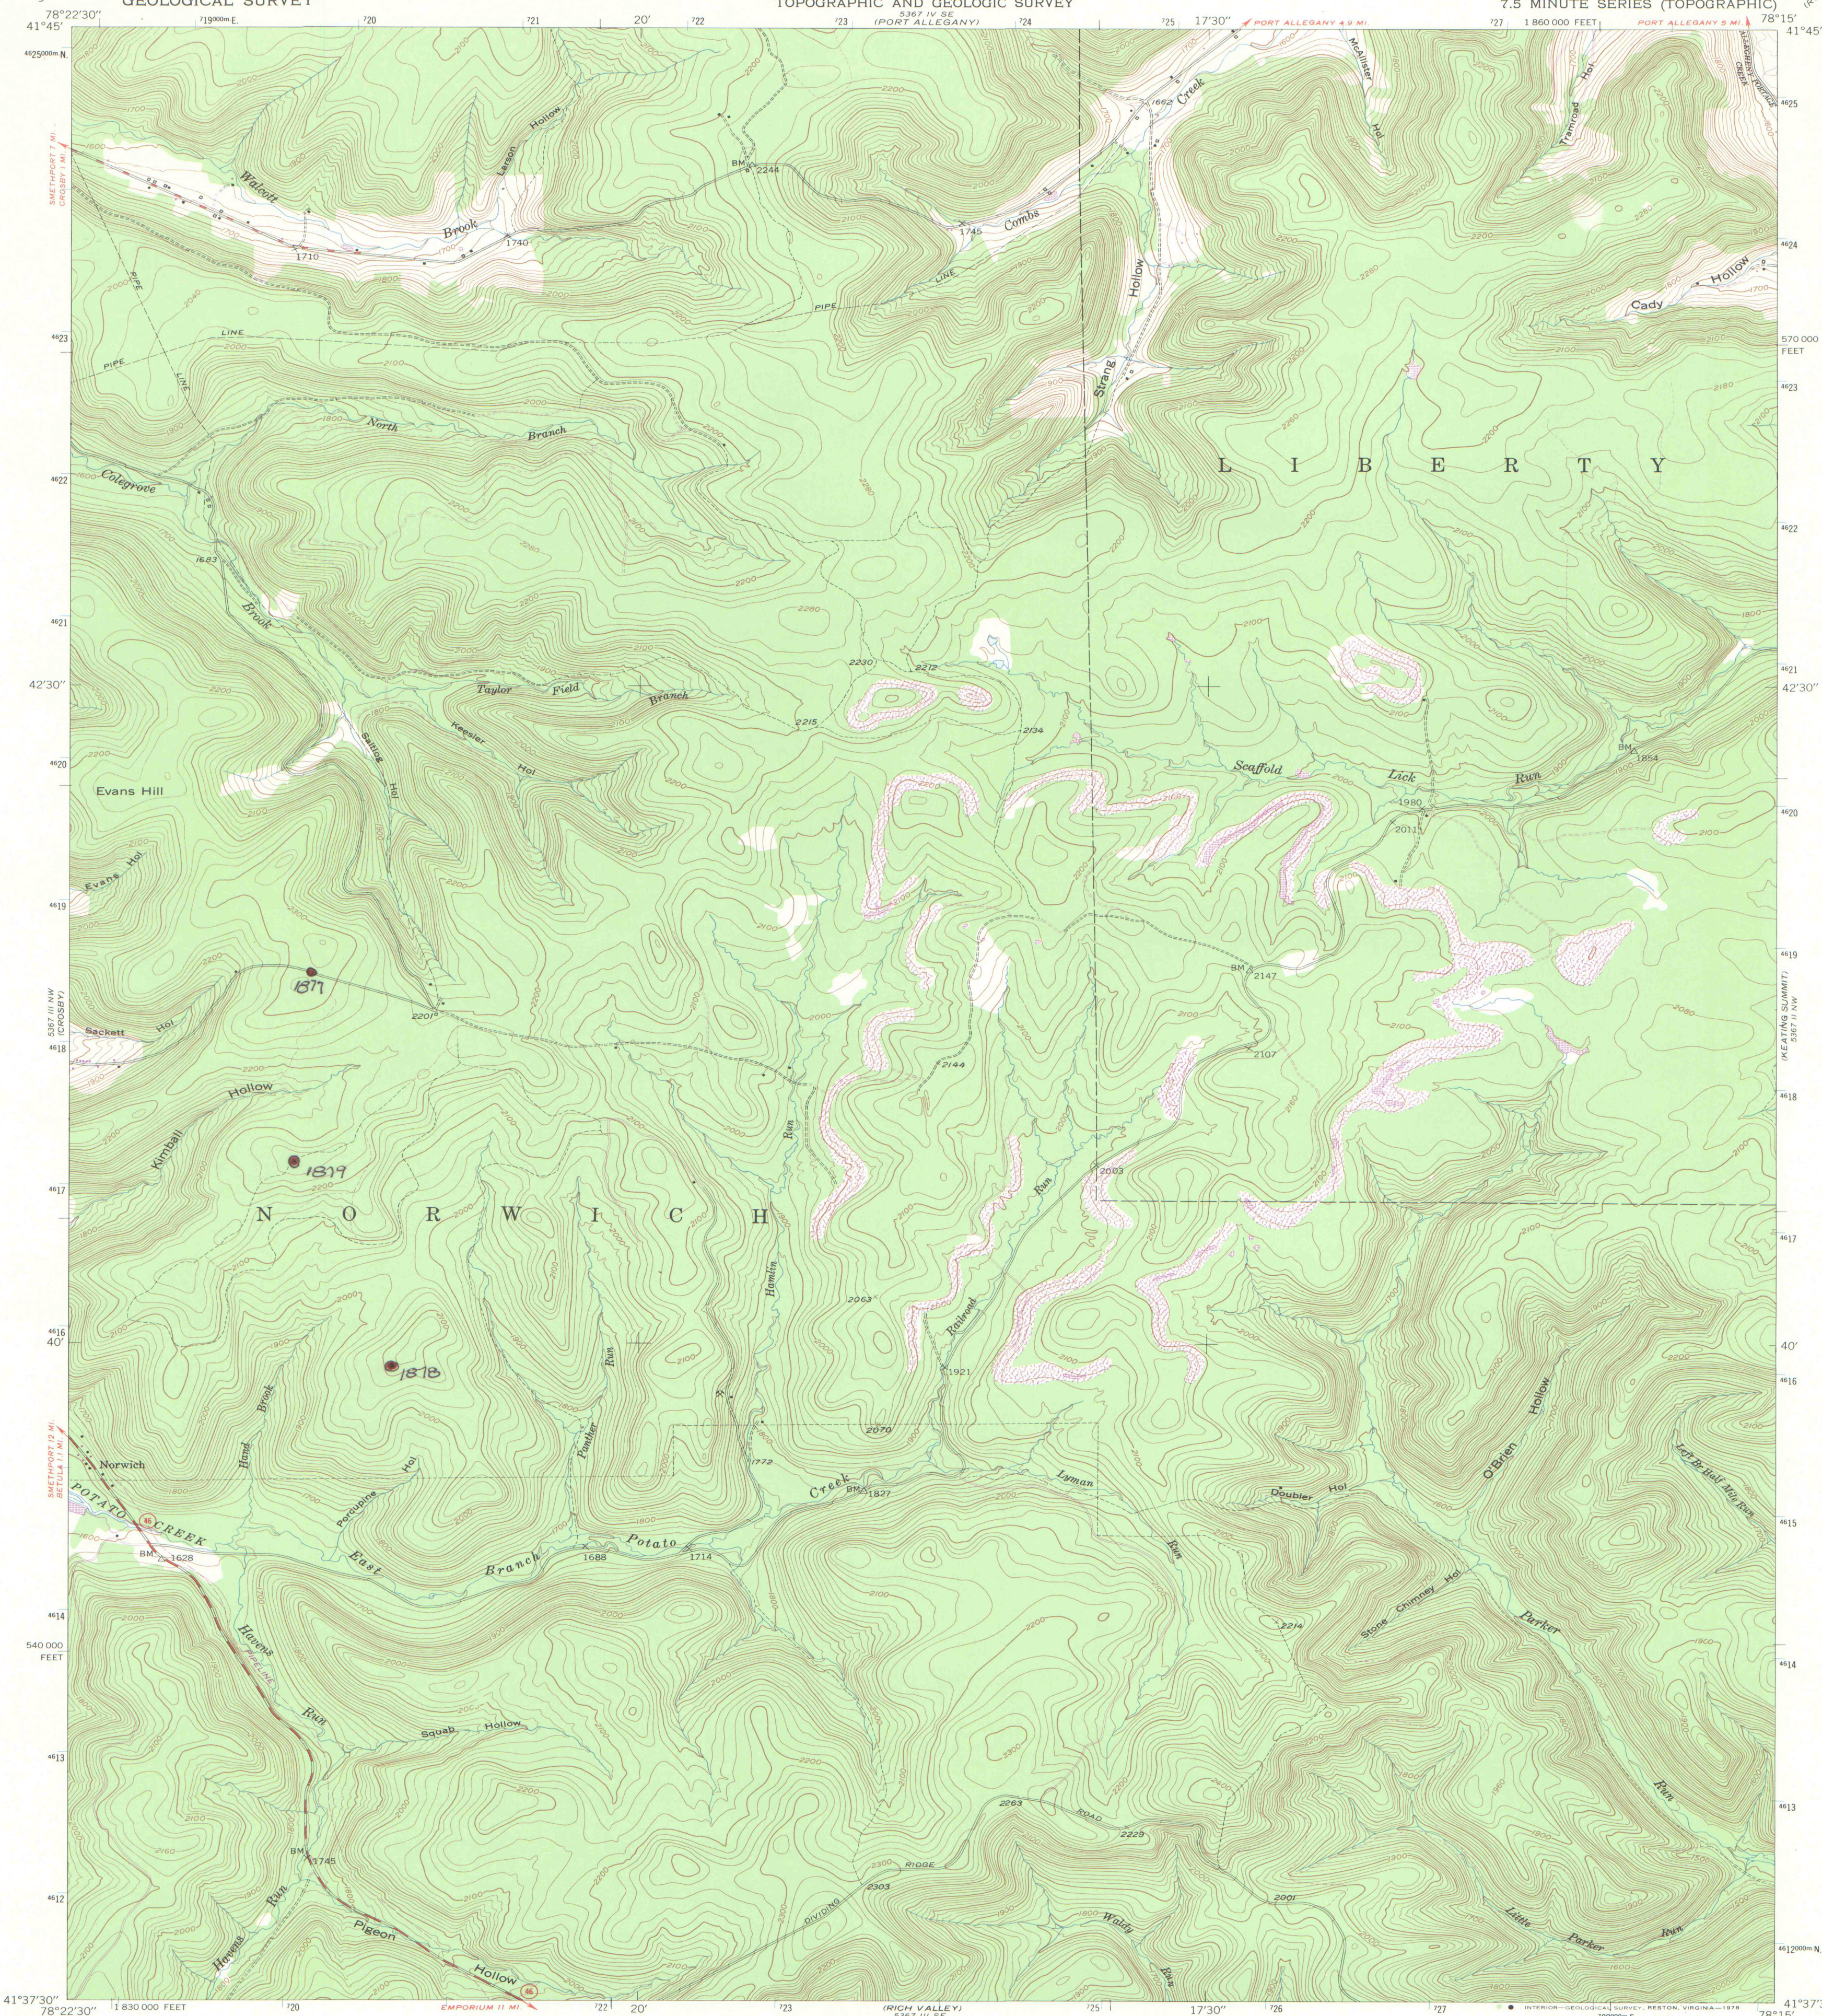

Maped, edited, and published by the Geological Survey

Control by USGS, USC&GS, and Pa. Dept. of Highways

Topography from aerial photographs by multiplex methods

Aerial photographs taken 1945. Field check 1948

Polyconic projection. 1927 North American datum

10,000-foot grid based on Pennsylvania coordinate system,

north zone


1000-meter Universal Transverse Mercator grid ticks,

zone 17, shown in blue

Revisions shown in purple compiled in cooperation with State of


Pennsylvania agencies from aerial photographs taken 1971. This

information not field checked

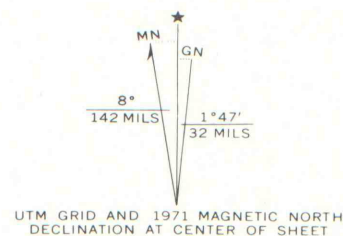

UTM GRID AND 1971 MAGNETIC NORTH

DECLINATION AT CENTER OF SHEET

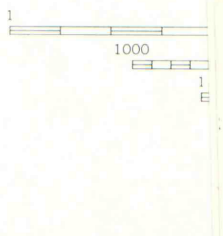


THIS
FOR
A FOLDER D

DDH LOCATIONS
Office Copy
A-02

IMAPS # 09368

NOT TO BE REMOVED FROM THE OFFICE

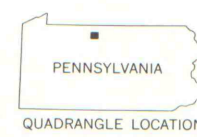

QUADRANGLE LOCATION

ROAD CLASSIFICATION
HARD-SURFACE ALL WEATHER ROADS
Heavy-duty ————— 4 LANE ROAD Improved dirt —————
Medium-duty ————— 4 LANE ROAD Unimproved dirt —————
Loose-surface, graded, or narrow hard-surface - - - - -
U. S. Route State Route

NORWICH, PA.
N4137.5—W7815/7.5

1948
PHOTOREVISED 1971
AMS 5367 III NE—SERIES V831