


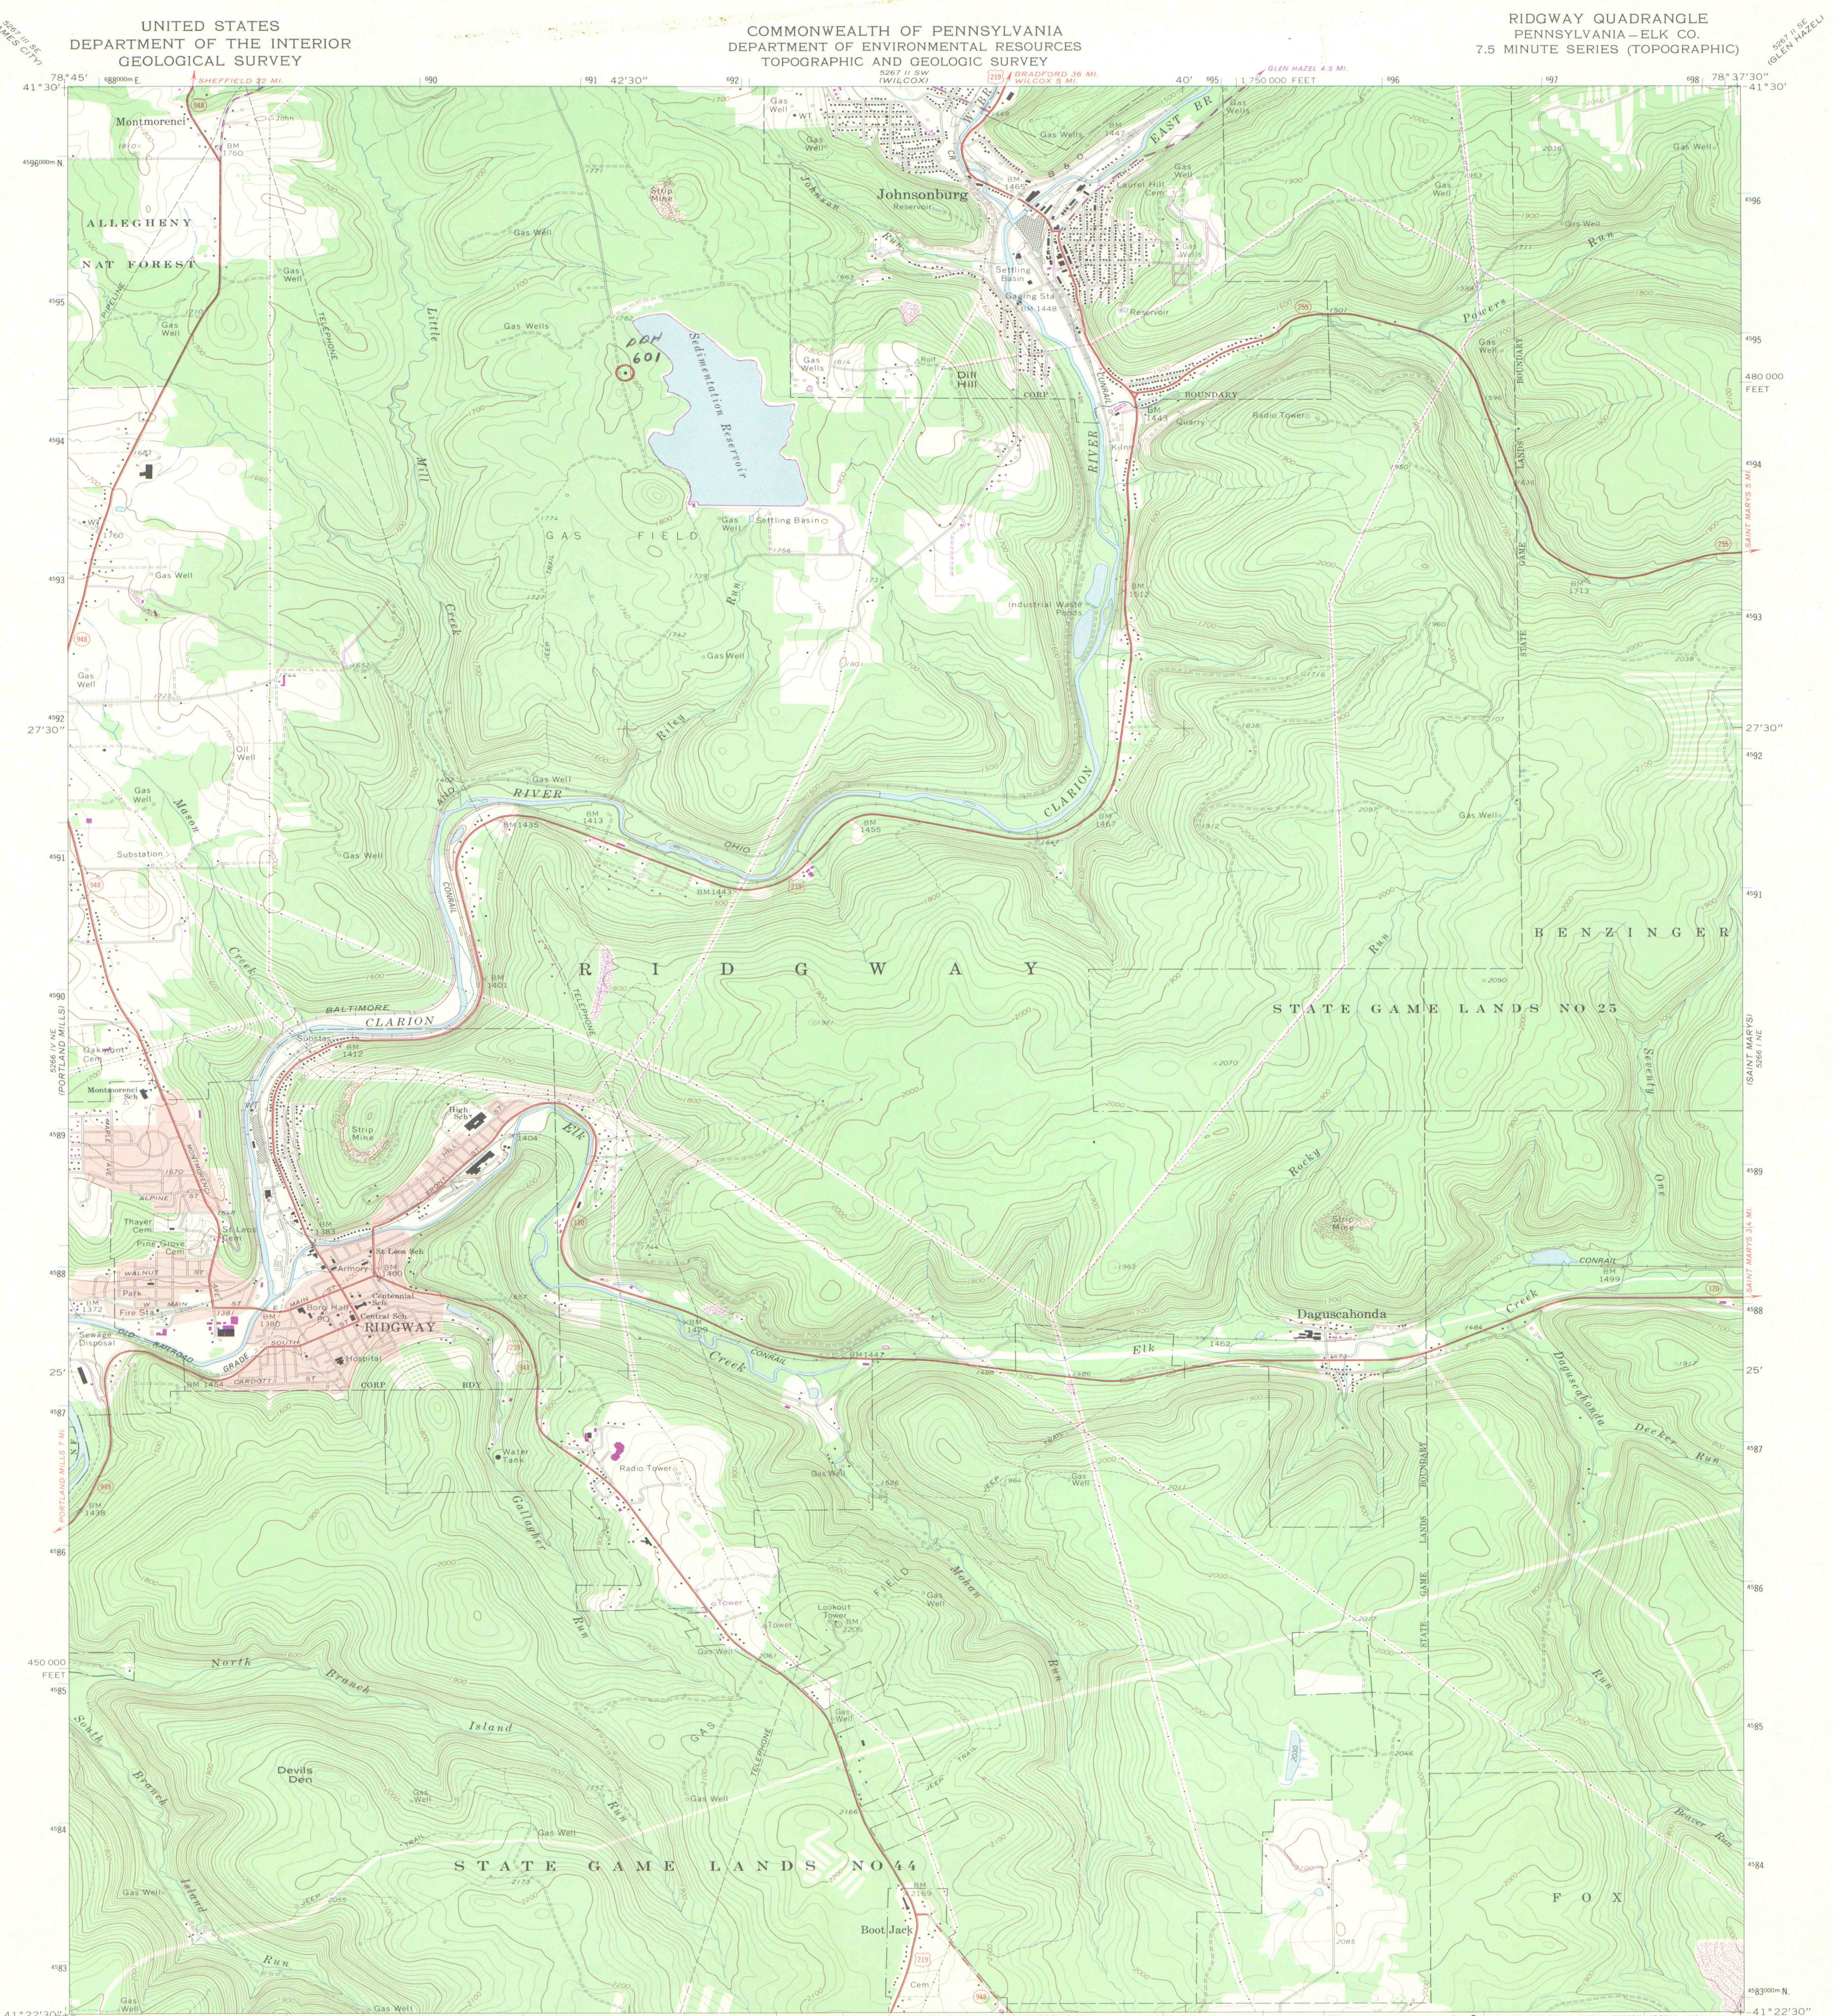

UNITED STATES
DEPARTMENT OF THE INTERIOR
GEOLOGICAL SURVEY

Mapped, edited, and published by the Geological Survey
Control by USGS and NOS/NOAA


Topography by photogrammetric methods from aerial
photographs taken 1968. Field checked 1969

Polyconic projection. 10,000-foot grid ticks based on
Pennsylvania coordinate system, north zone
1000-meter Universal Transverse Mercator grid ticks,
zone 17, shown in blue. 1927 North American Datum
To place on the predicted North American Datum 1983
move the projection lines 3 meters south and
21 meters west as shown by dashed corner ticks

Fine red dashed lines indicate selected fence and field lines where
generally visible on aerial photographs. This information is unchecked

Red tint indicates areas in which only landmark buildings are shown

There may be private inholdings within the boundaries of

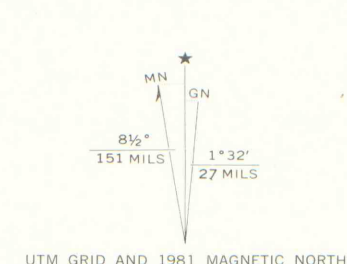

DIAMOND DRILL HOLE
Location Maps
A-02

7-3-A

NOT TO BE REMOVED FROM THE OFFICE

IMAPS# 09369

MAPS AND SYMBOLS IS AVAILABLE ON REQUEST

ROAD CLASSIFICATION

Primary highway,
hard surface

Secondary highway,
hard surface

Unimproved road

Interstate Route

U. S. Route

State Route

RIDGWAY, PA.

N4122.5—W7837.5/7.5

1969
PHOTOREVISED 1981
DMA 5266 1 NW-SERIES V831

Revisions shown in purple compiled in cooperation with
Commonwealth of Pennsylvania agencies from aerial
photographs taken 1977 and other sources. This
information not field checked. Map edited 1981