


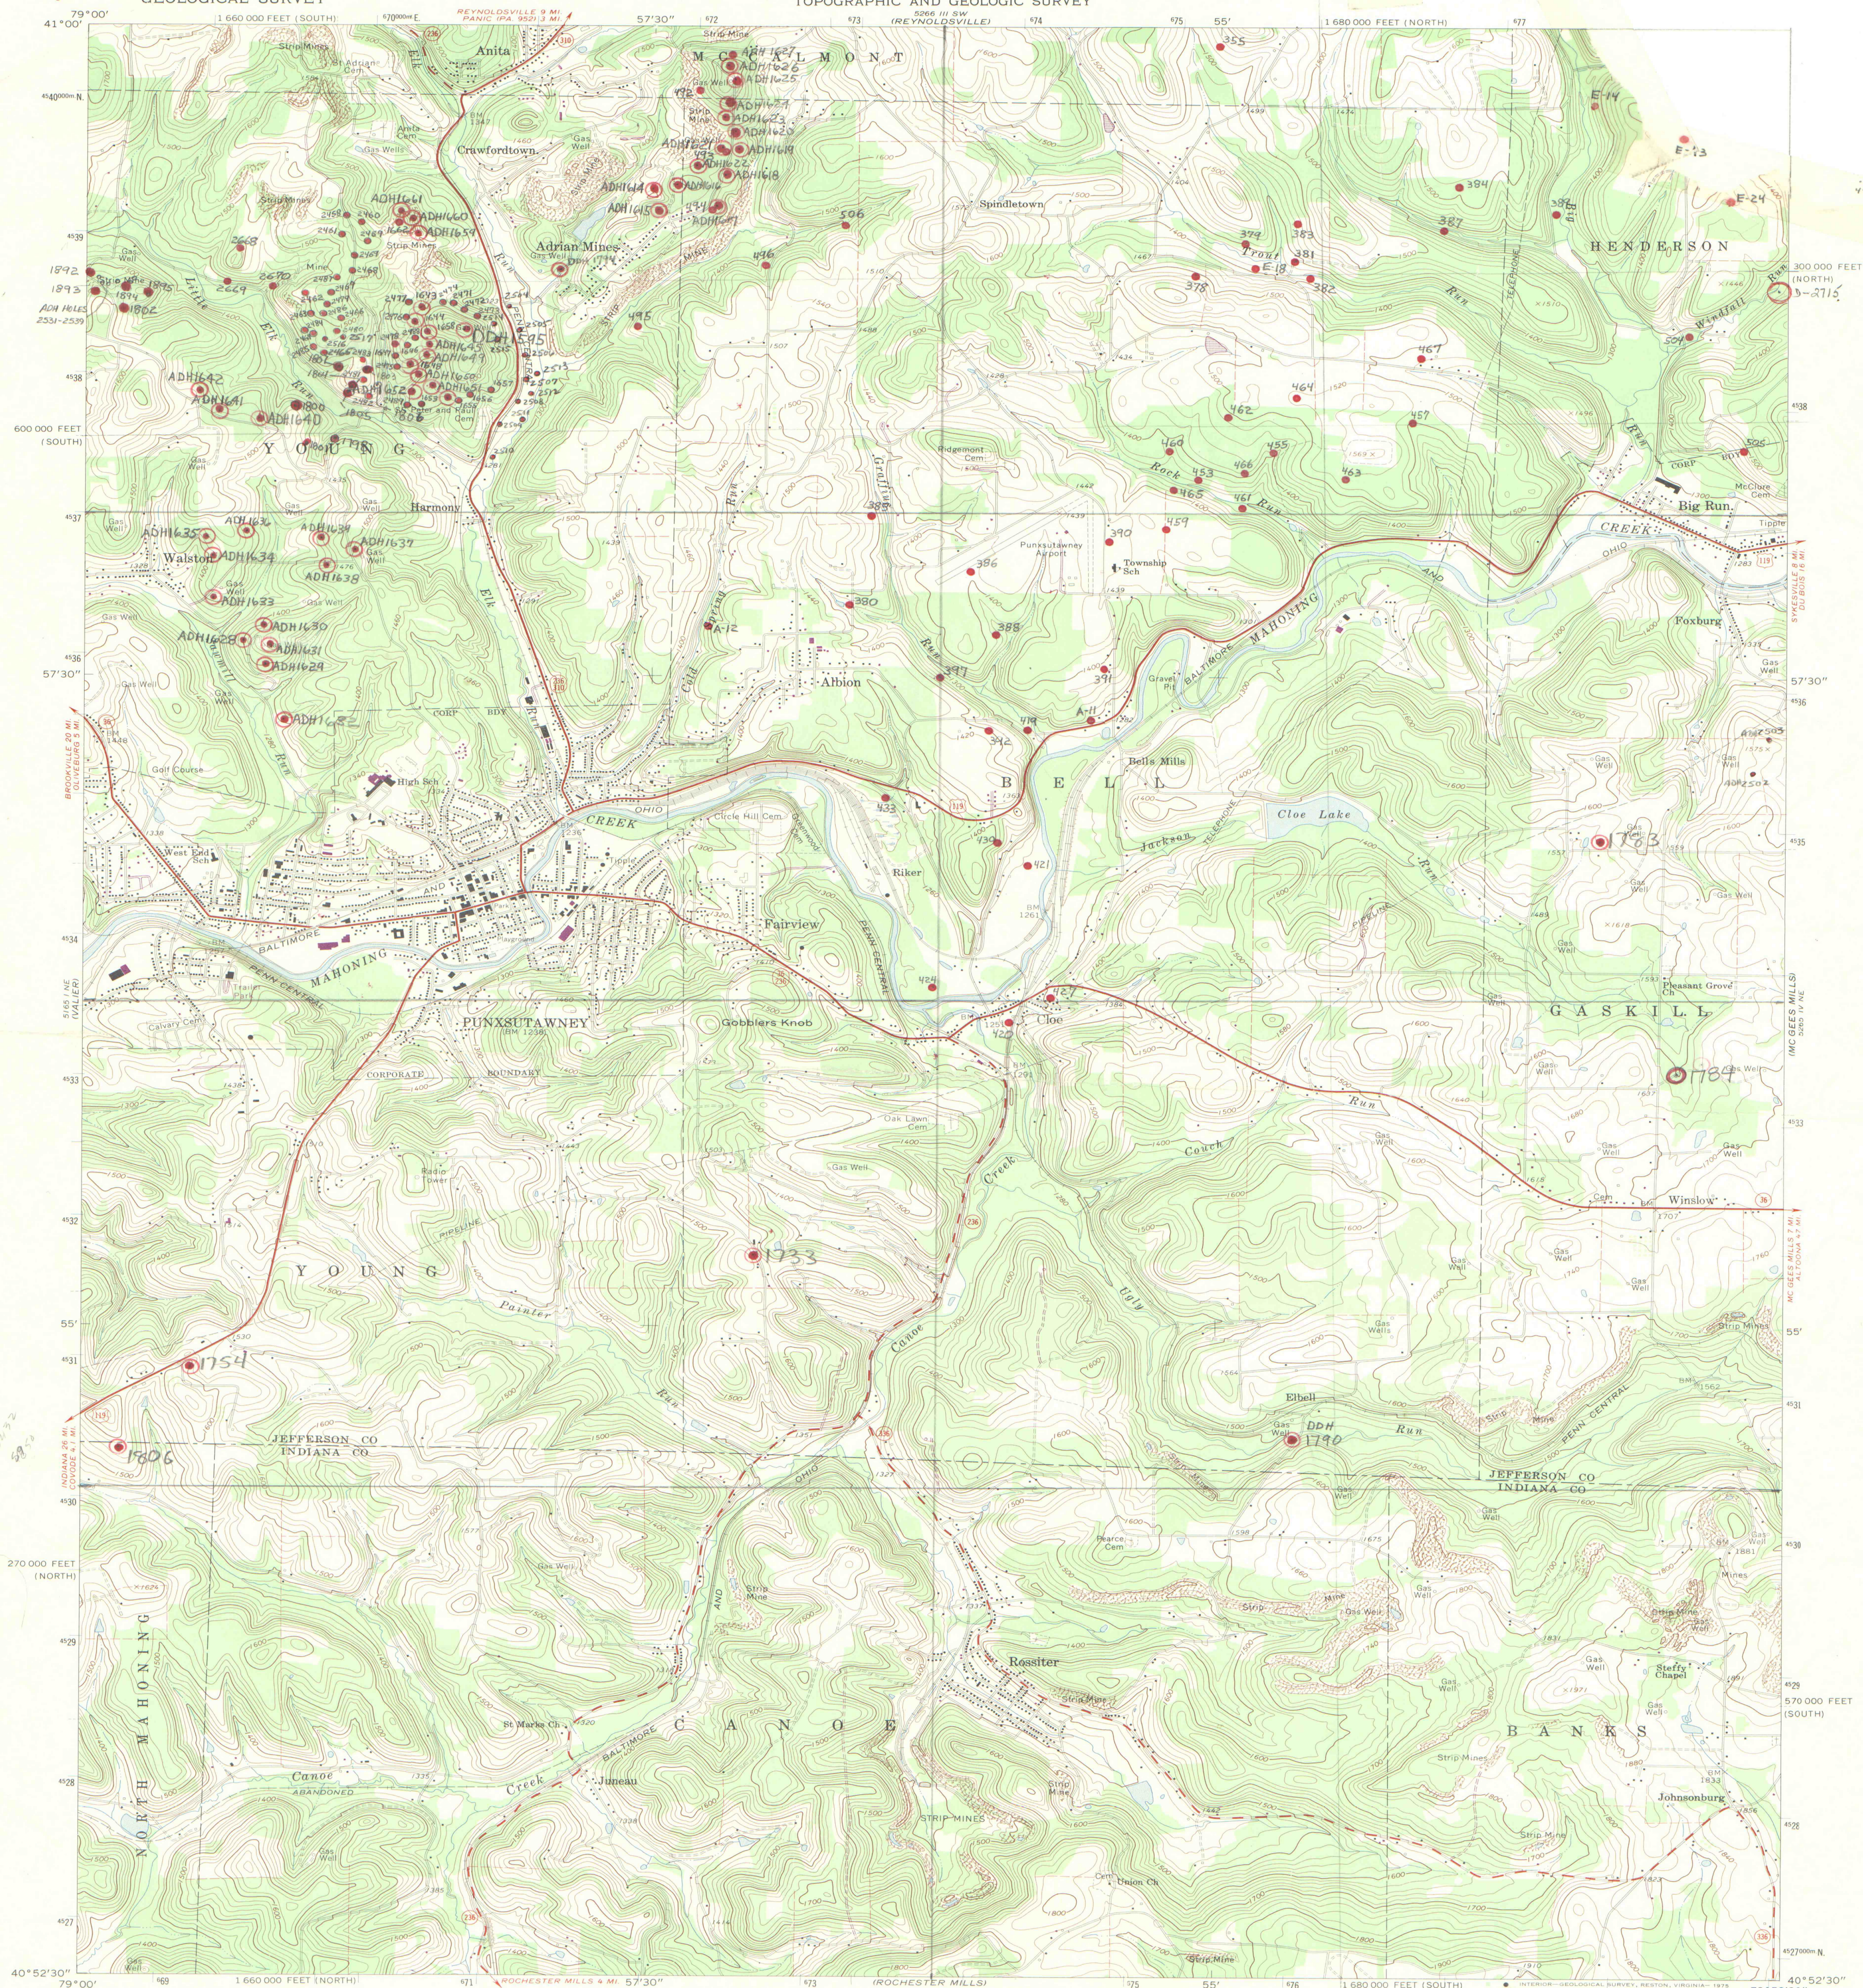

Mapped, edited, and published by the Geological Survey

Control by USGS and USC&GS

Topography by photogrammetric methods from aerial photographs taken 1967. Field checked 1968


Polyconic projection. 1927 North American datum

10,000-foot grids based on Pennsylvania coordinate system, north and south zones

1000-meter Universal Transverse Mercator grid ticks, zone 17, shown in blue

Fine red dashed lines indicate selected fence and field lines where generally visible on aerial photographs. This information is unchecked

Revisions shown in purple compiled in cooperation with State of Pennsylvania agencies from aerial photographs taken 1973. This information not field checked

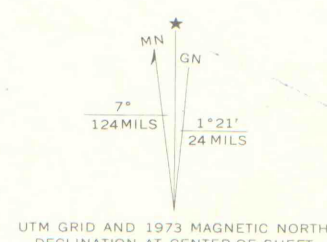


DIAMOND DRILL HOLE
Location Maps
A-02

NOT TO BE TAKEN FROM OFFICE

ROAD CLASSIFICATION
Primary highway, all weather, hard surface
Secondary highway, all weather, hard surface
Light-duty road, all weather, improved surface
Unimproved road, fair or dry weather

U. S. Route
State Route

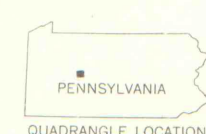

PUNXSUTAWNEY, PA.

N4052.5-W7852.5/7.5

1968
PHOTOREVISED 1973
AMS 5265 IV NW-SERIES V831

IMAPS # 09374