


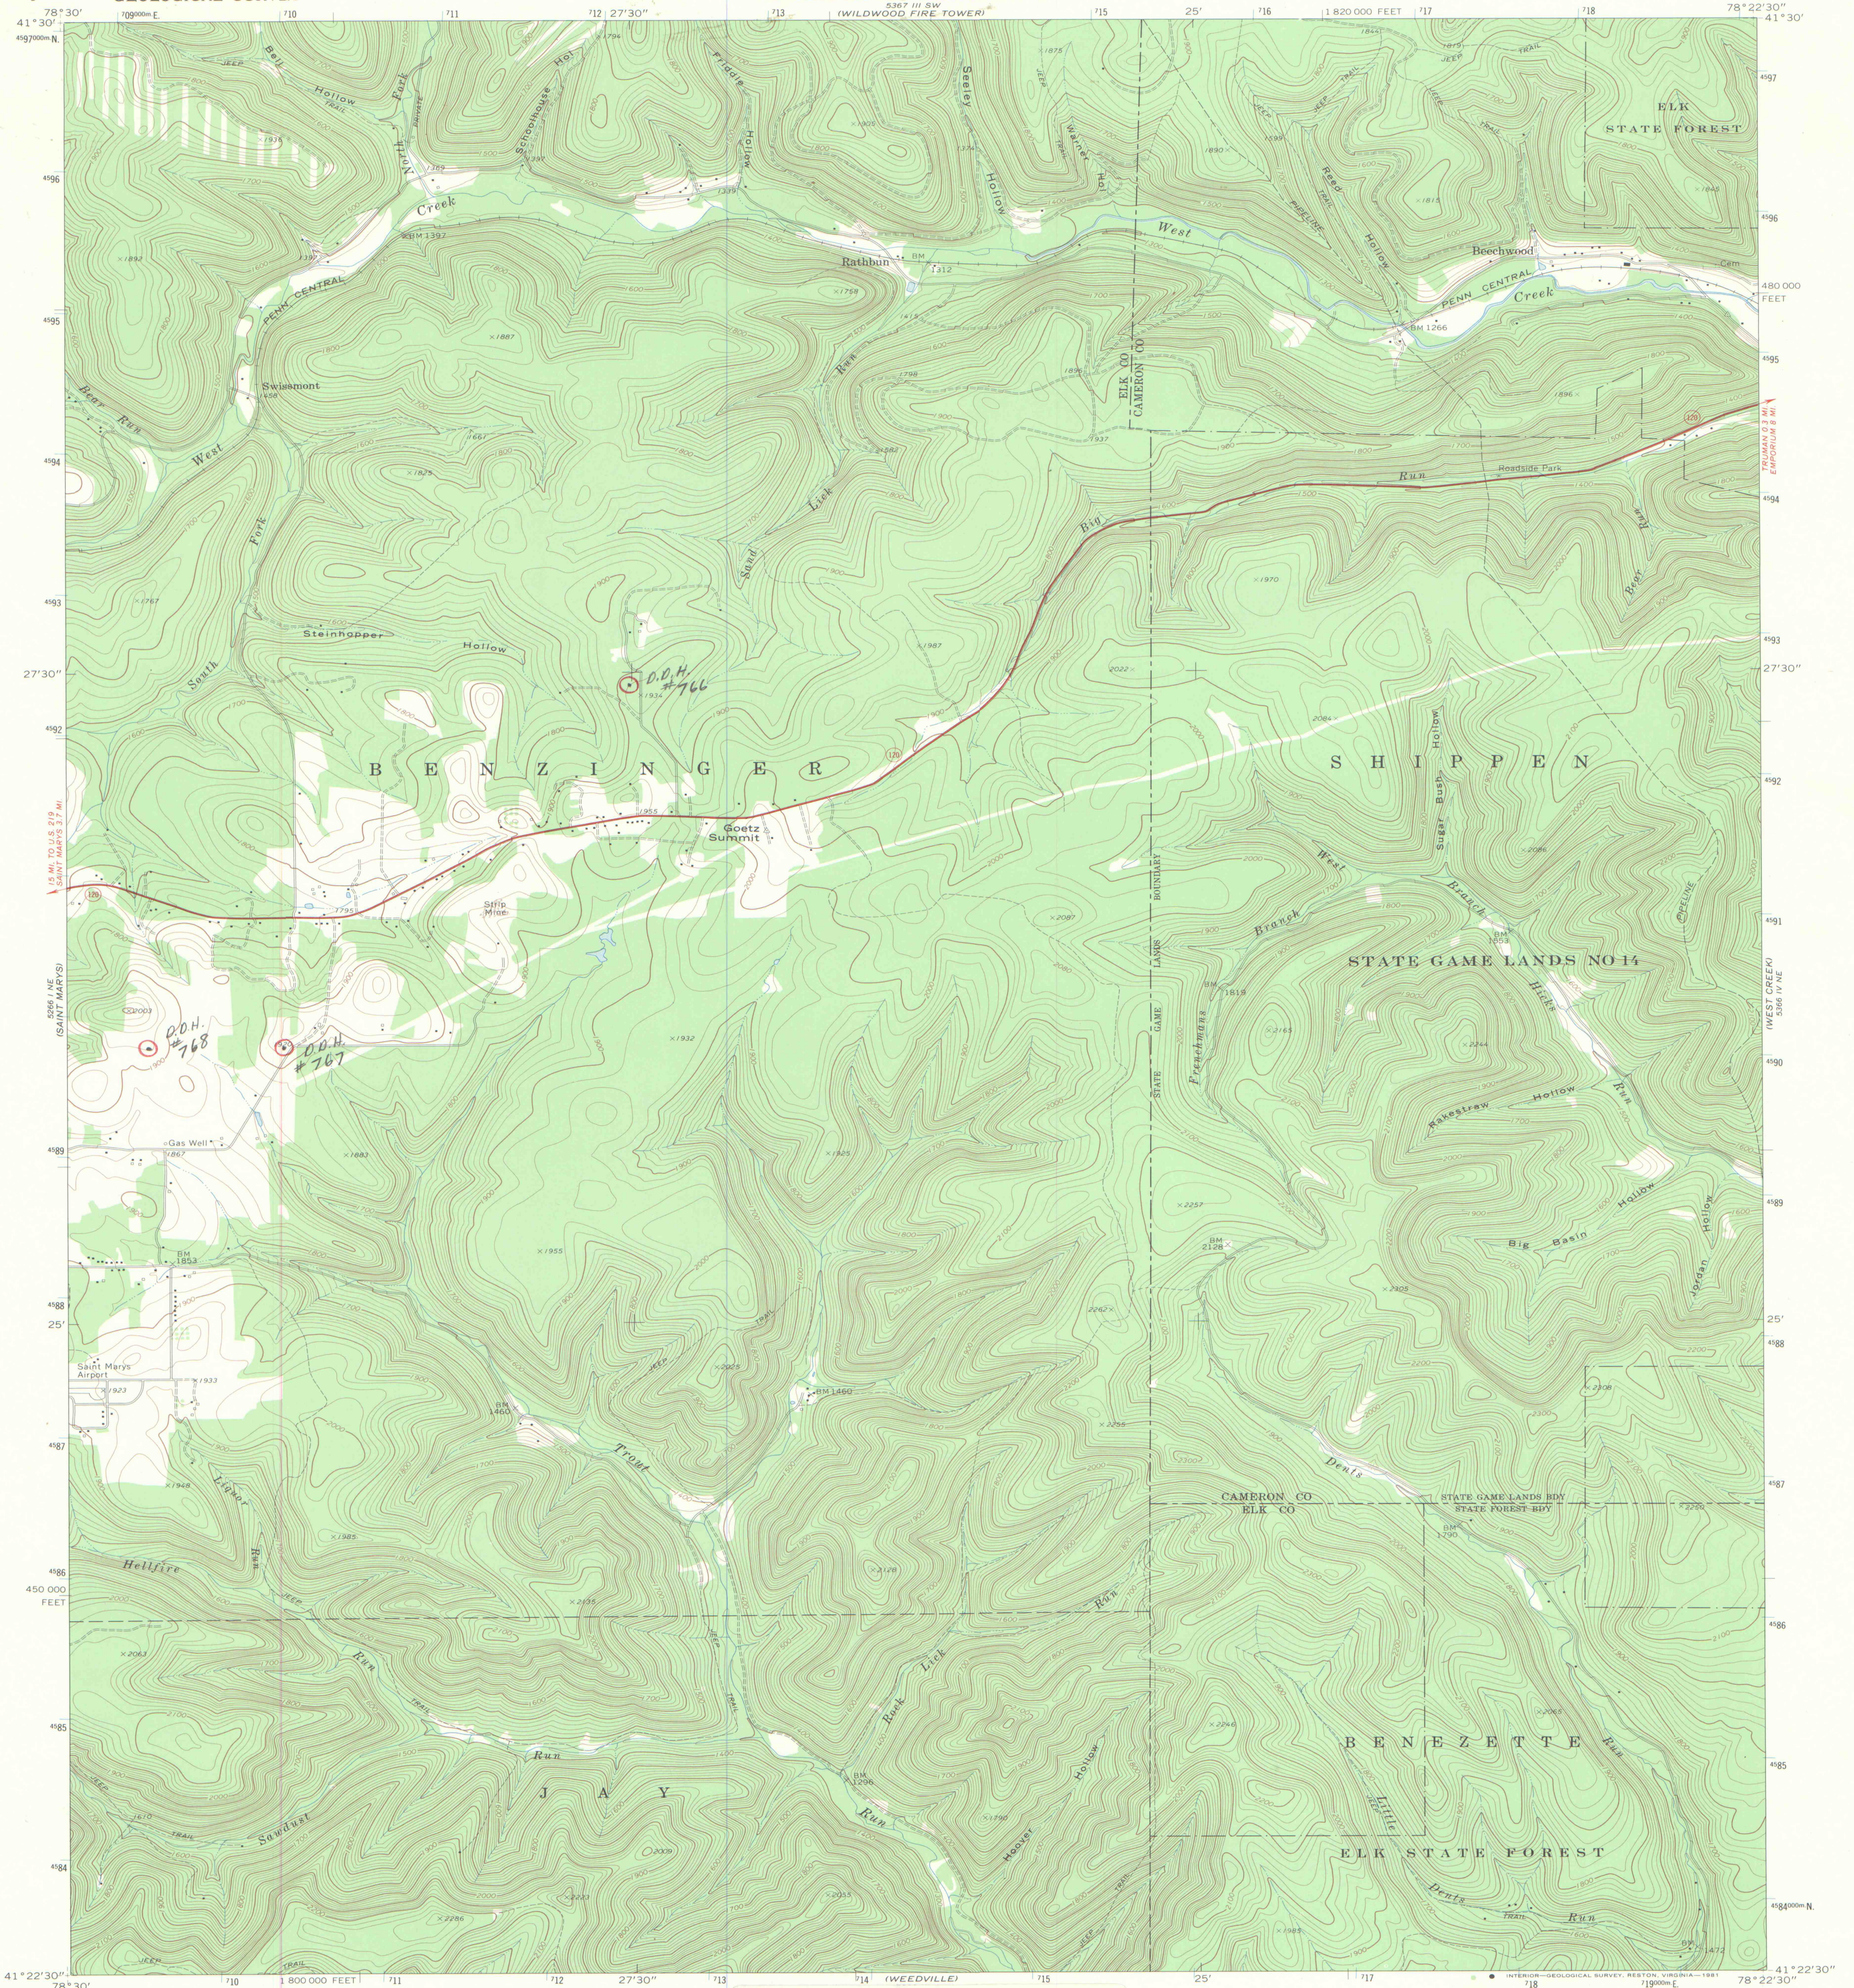

Mapped, edited, and published by the Geological Survey

Control by USGS and US&GS


Topography by photogrammetric methods from aerial photographs

taken 1968. Field checked 1969

Polyconic projection. 10,000-foot grid ticks based on Pennsylvania coordinate system, north zone. 1000-meter Universal Transverse Mercator grid ticks, zone 17, shown in blue. 1927 North American Datum. To place on the predicted North American Datum 1983 move the projection lines 3 meters south and 22 meters west as shown by dashed corner ticks

There may be private inholdings within the boundaries of the National or State reservations shown on this map

Map photoinspected 1977. No major culture or drainage changes observed

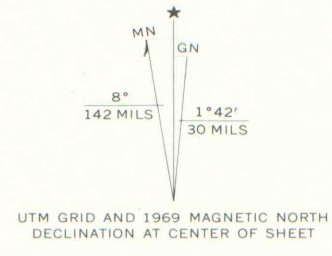

DIAMOND DRILL HOLE
Location Maps
A-02


8-3-A

NOT TO BE REMOVED FROM THE OFFICE

A FOLDER DESCRIBING TOPOGRAPHIC MAPS AND SYMBOLS IS AVAILABLE ON REQUEST

ROAD CLASSIFICATION

Primary highway, hard surface
Secondary highway, hard surface
Interstate Route
Light-duty road, hard or improved surface
Unimproved road
U.S. Route
State Route

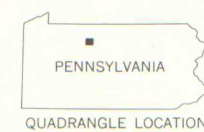

RATHBUN, PA.

N4122.5-W7822.5/7.5
PHOTOINSPECTED 1977
1969

AMS 5366 IV NW-SERIES V831

1 MAPS
09376