


Mapped, edited, and published by the Geological Survey
Control by USGS and USC & GS

Topography from aerial photographs by multiplex methods
Aerial photographs taken 1944. Field checked 1946

Polyconic projection
10 000-foot grid based on Pennsylvania coordinate system,
North zone
1000-meter Universal Transverse Mercator grid ticks,
zone 18, shown in blue. 1927 North American Datum
To place on the predicted North American Datum 1983
move the projection lines 4 meters south and
24 meters west as shown by dashed corner ticks

Revisions shown in purple compiled in cooperation with
State of Pennsylvania agencies from aerial photographs
taken 1971. This information not field checked

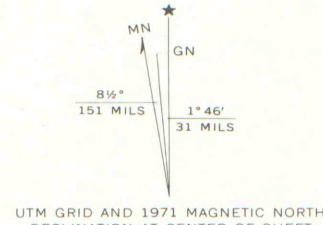

SCALE 1:24 000
1 MILE
0 1000 2000 3000 4000 5000 6000 7000 FEET

DIAMOND DRILL HOLE
Location Maps
A-02
(11-3-C)


NOT TO BE REMOVED FROM THIS DEPARTMENT

ROAD CLASSIFICATION
HARD-SURFACE ALL WEATHER ROADS DRY WEATHER ROADS
Heavy-duty 4 LANE LANE Improved dirt
Medium-duty 4 LANE LANE Unimproved dirt
Loose-surface, graded, or narrow hard-surface
U. S. Route State Route

RENOVO EAST, PA.

N4115-W7737.5/7.5

1946
PHOTOREVISED 1971
DMA 5466 1 SW-SERIES V831

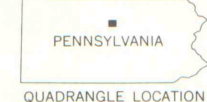

1 MAPS
09377