



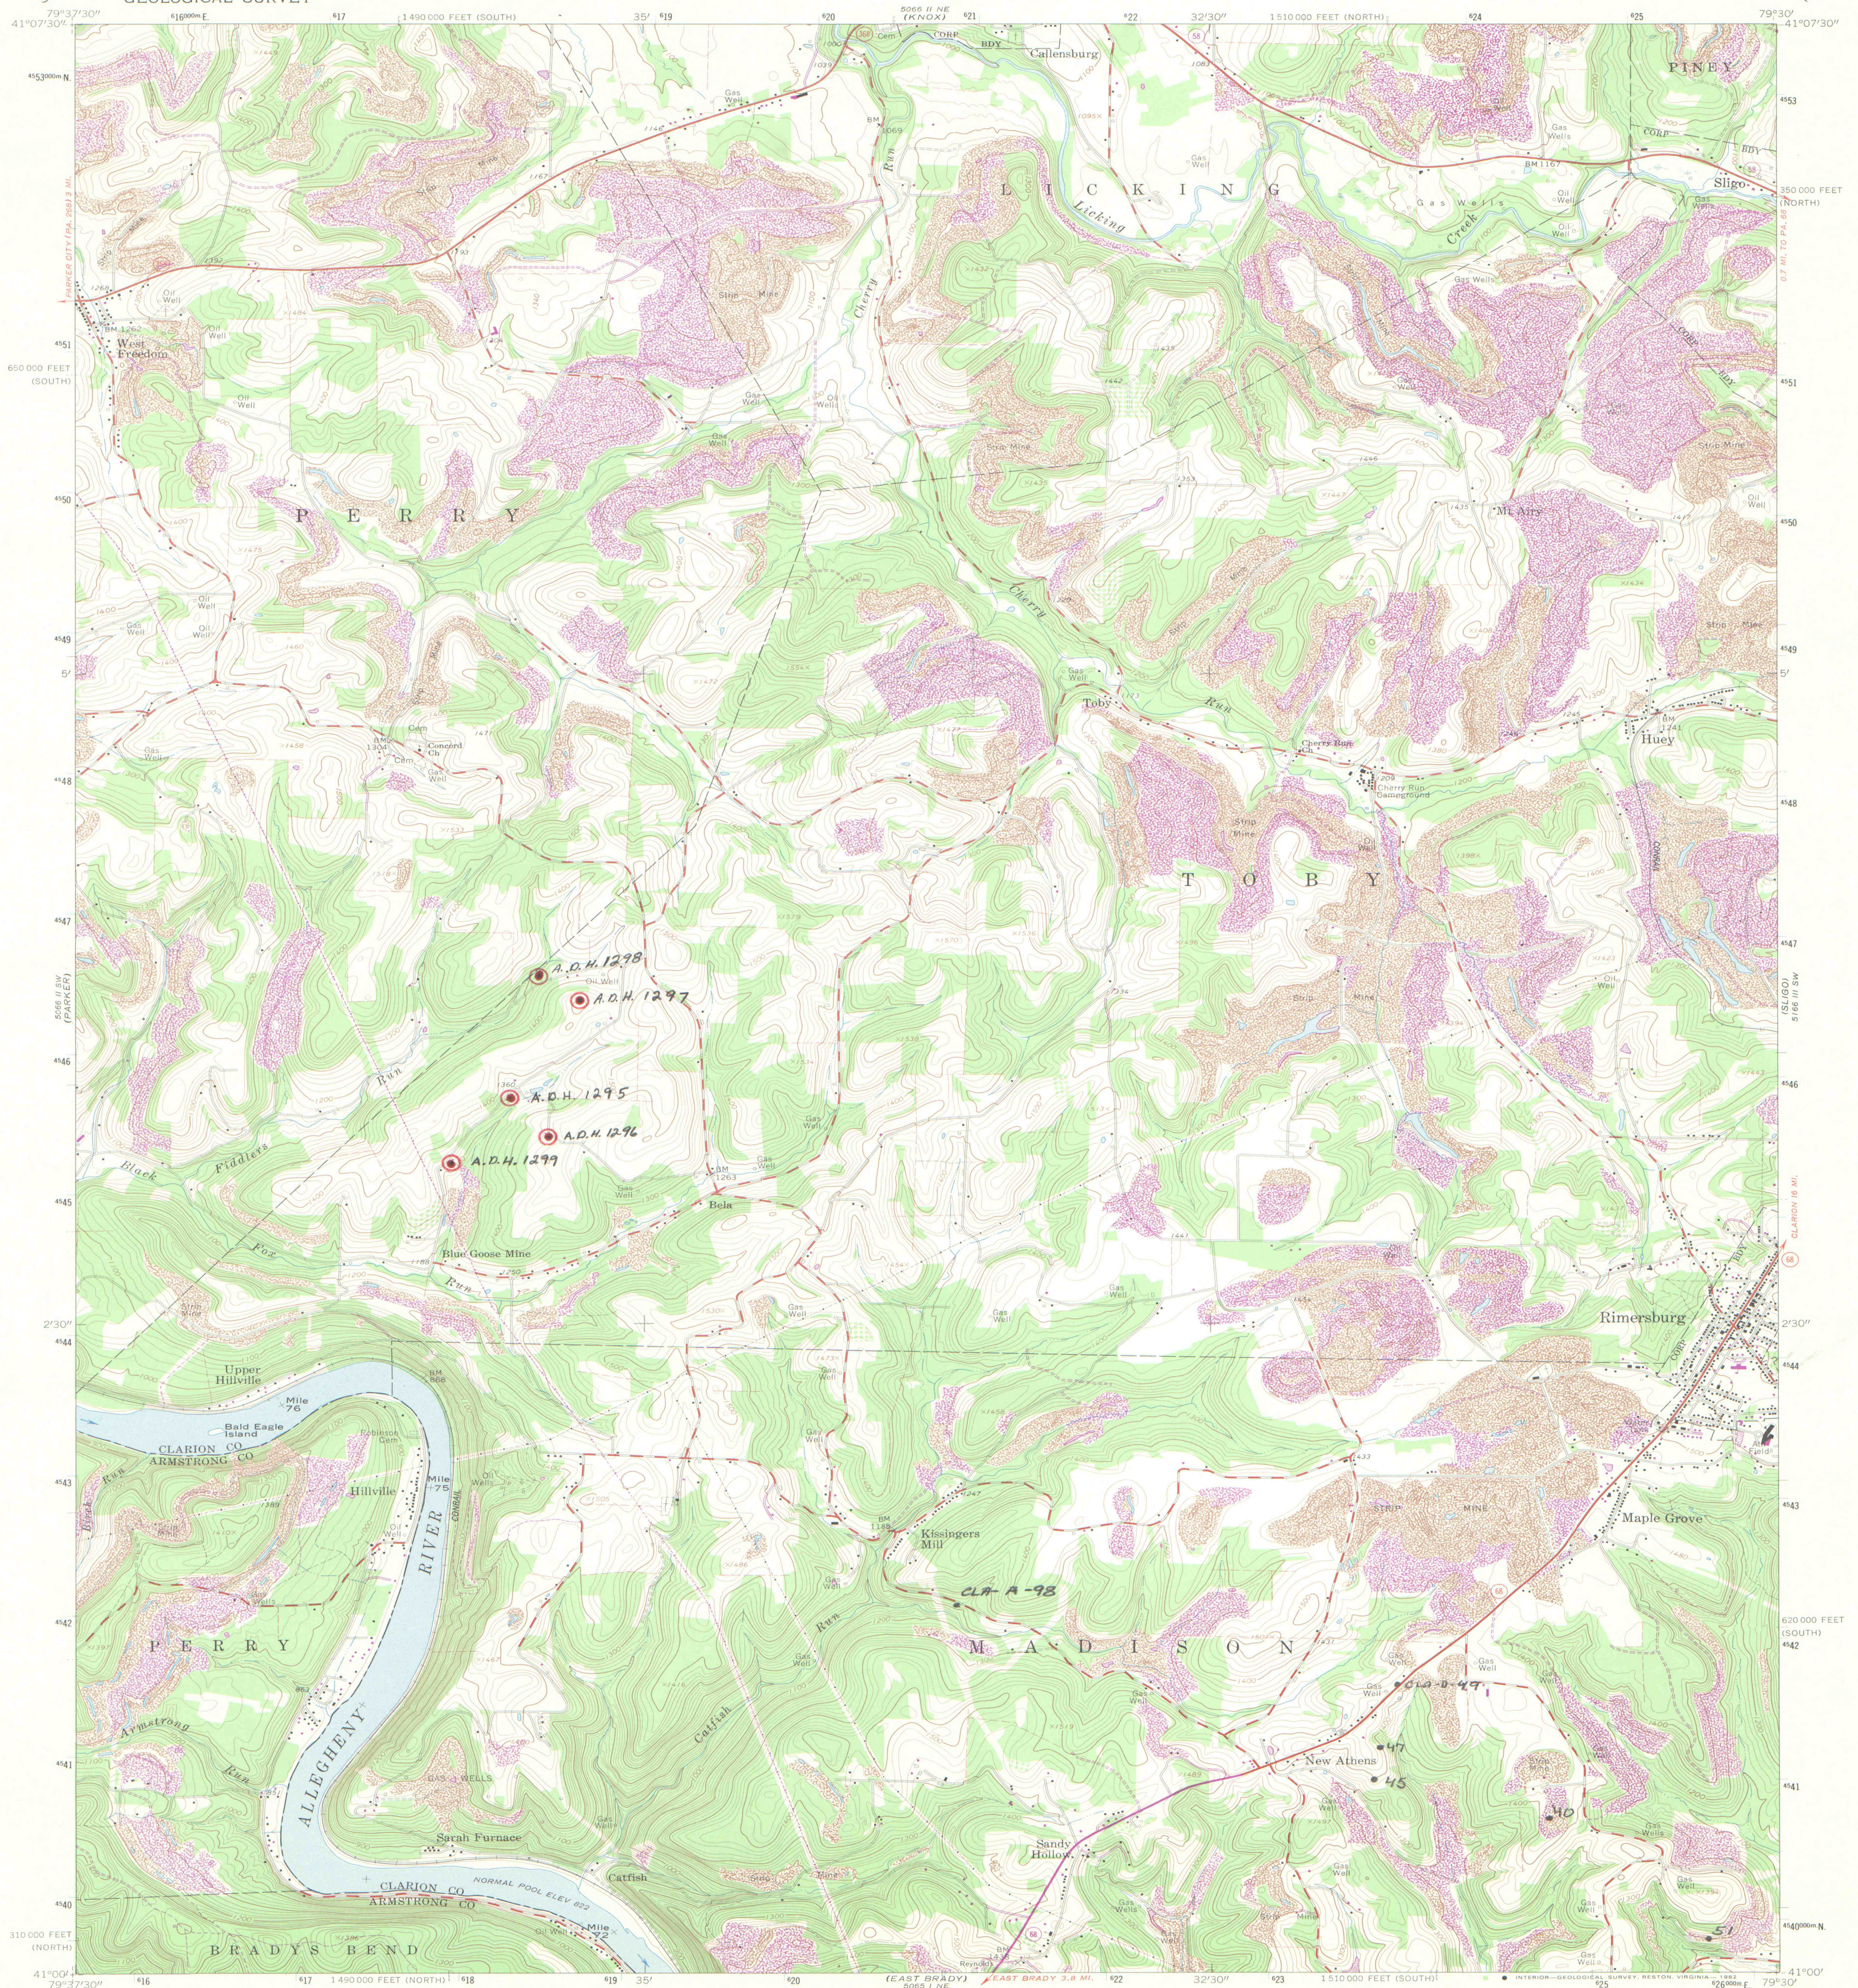

Mapped, edited, and published by the Geological Survey
Control by USGS, NOS/NOAA, and USCE
Topography by photogrammetric methods from aerial photographs
taken 1962. Field checked 1963


Polyconic projection. 10,000-foot grid ticks based on Pennsylvania
coordinate system, north and south zones. 1000-meter Universal
Transverse Mercator grid ticks, zone 17, shown in blue.
1927 North American Datum. To place on the predicted
North American Datum 1983 move the projection lines 3 meters
south and 19 meters west as shown by dashed corner ticks

Fine red dashed lines indicate selected fence and field lines where
generally visible on aerial photographs. This information is unchecked
Revisions shown in purple and woodland compiled in cooperation with
Commonwealth of Pennsylvania agencies from aerial photographs taken
1977 and other sources. This information not field checked. Map edited 1981

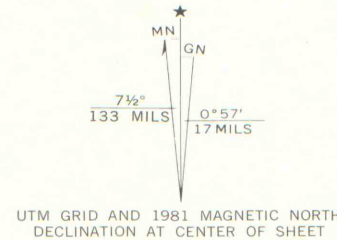

DIAMOND DRILL HOLE
Location Maps
A-02
3-4-D
NOT TO BE REMOVED FROM THE OFFICE

SCALE 1:24,000
1 MILE
7000 FEET
KILOMETER

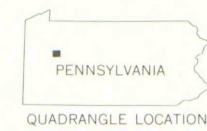

ROAD CLASSIFICATION
Heavy-duty ——— Light-duty ———
Medium-duty ——— Unimproved dirt ———
○ State Route

RIMERSBURG, PA.
N4100—W7930/7.5

1963
PHOTOREVISED 1981
DMA 5068 II SE—SERIES V831

IMAPS #09380