



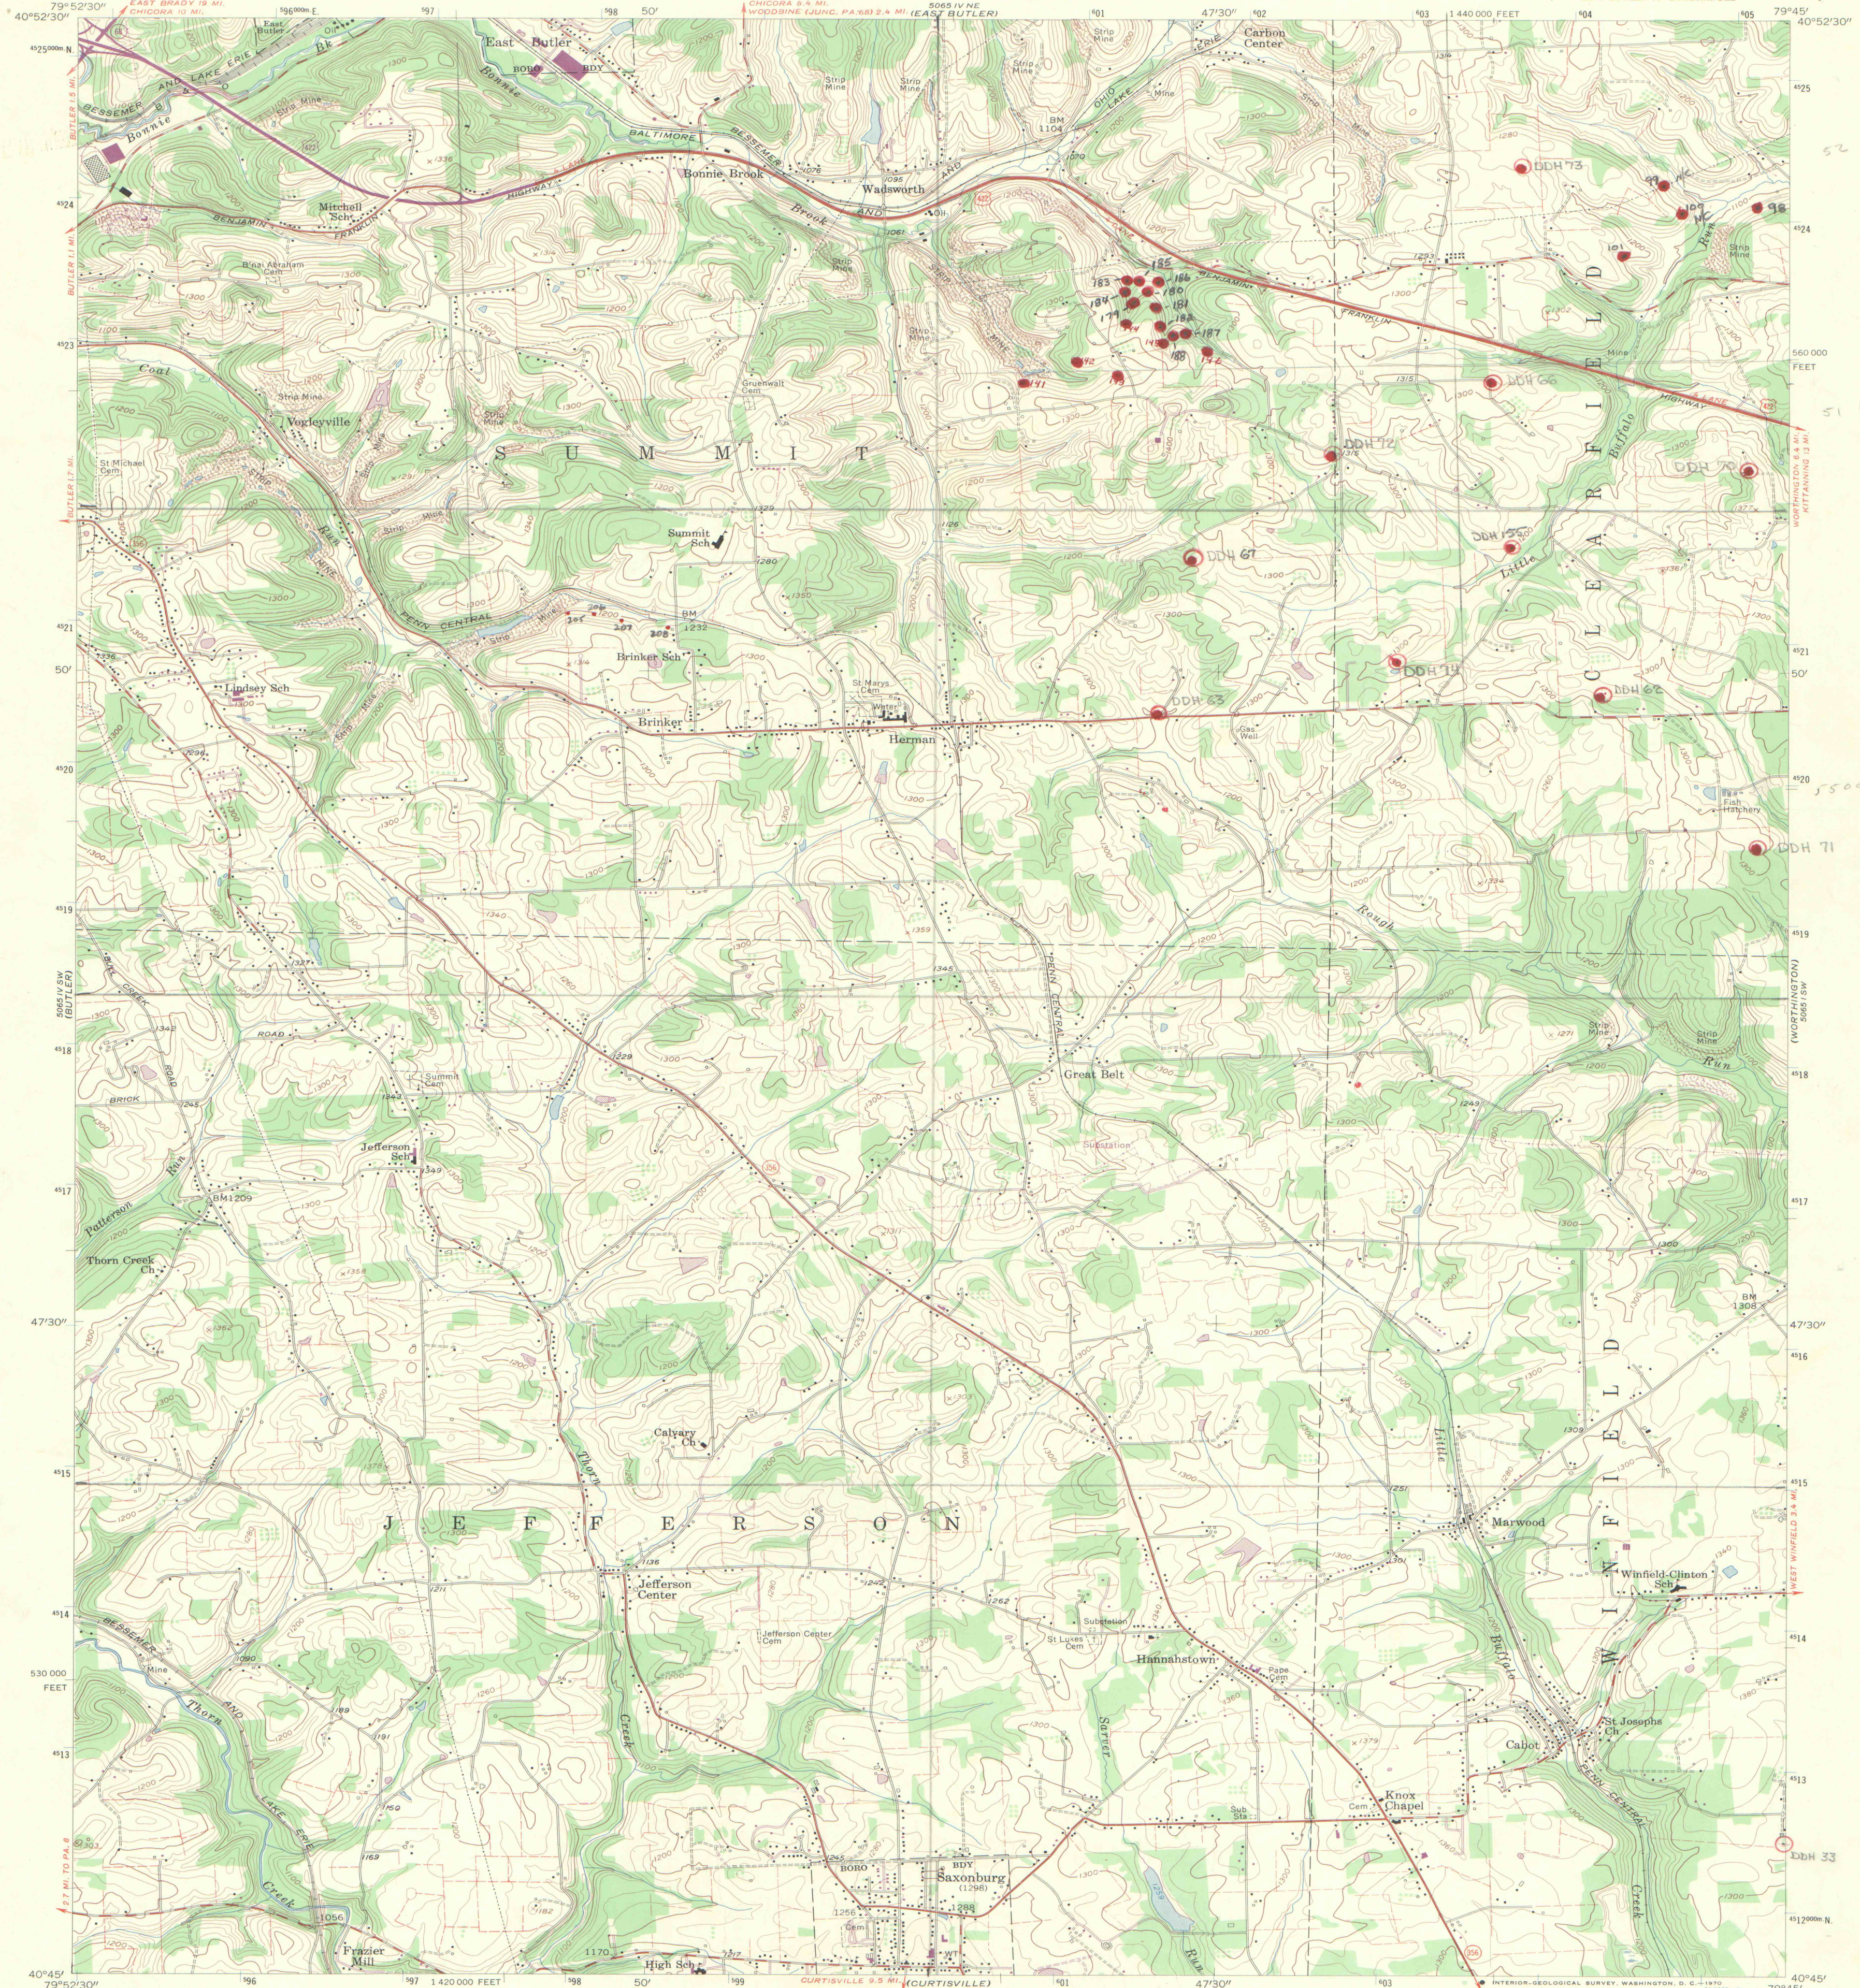


Mapped, edited, and published by the Geological Survey
Control by USGS and USC&GS
Topography from aerial photographs by photogrammetric methods
Aerial photographs taken 1952. Field check 1958.
Polyconic projection. 1927 North American datum
10,000-foot grid based on Pennsylvania coordinate system,
south zone
1000-meter Universal Transverse Mercator grid ticks,
zone 17, shown in blue
Fine red dashed lines indicate selected fence and field lines visible
on aerial photographs. This information is unchecked
Unlabelled wells are oil wells
Unchecked elevations are shown in brown

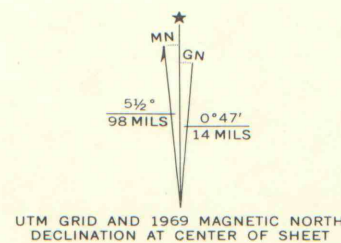

SCALE 1:24,000
1 1000 0 1000 2000 3000 4000 5000 6000 7000 FEET
1 KILOMETER

DIAMOND DRILL HOLE
Location Maps
A-02
NOT TO BE TAKEN FROM OFFICE

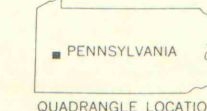

ROAD CLASSIFICATION
Heavy-duty ——— Light-duty ———
Medium-duty ——— Unimproved dirt ———
U. S. Route ——— State Route ———

SAXONBURG, PA.
SE 1/4 BUTLER 15' QUADRANGLE
N 4045—W 7945/7.5

1958
PHOTO-REVISED 1969
AMS 5065 IV SE—SERIES V831

Revisions shown in purple compiled in cooperation with
State of Pennsylvania agencies from aerial photographs
taken 1969. This information not field checked

IMAPS #09383