


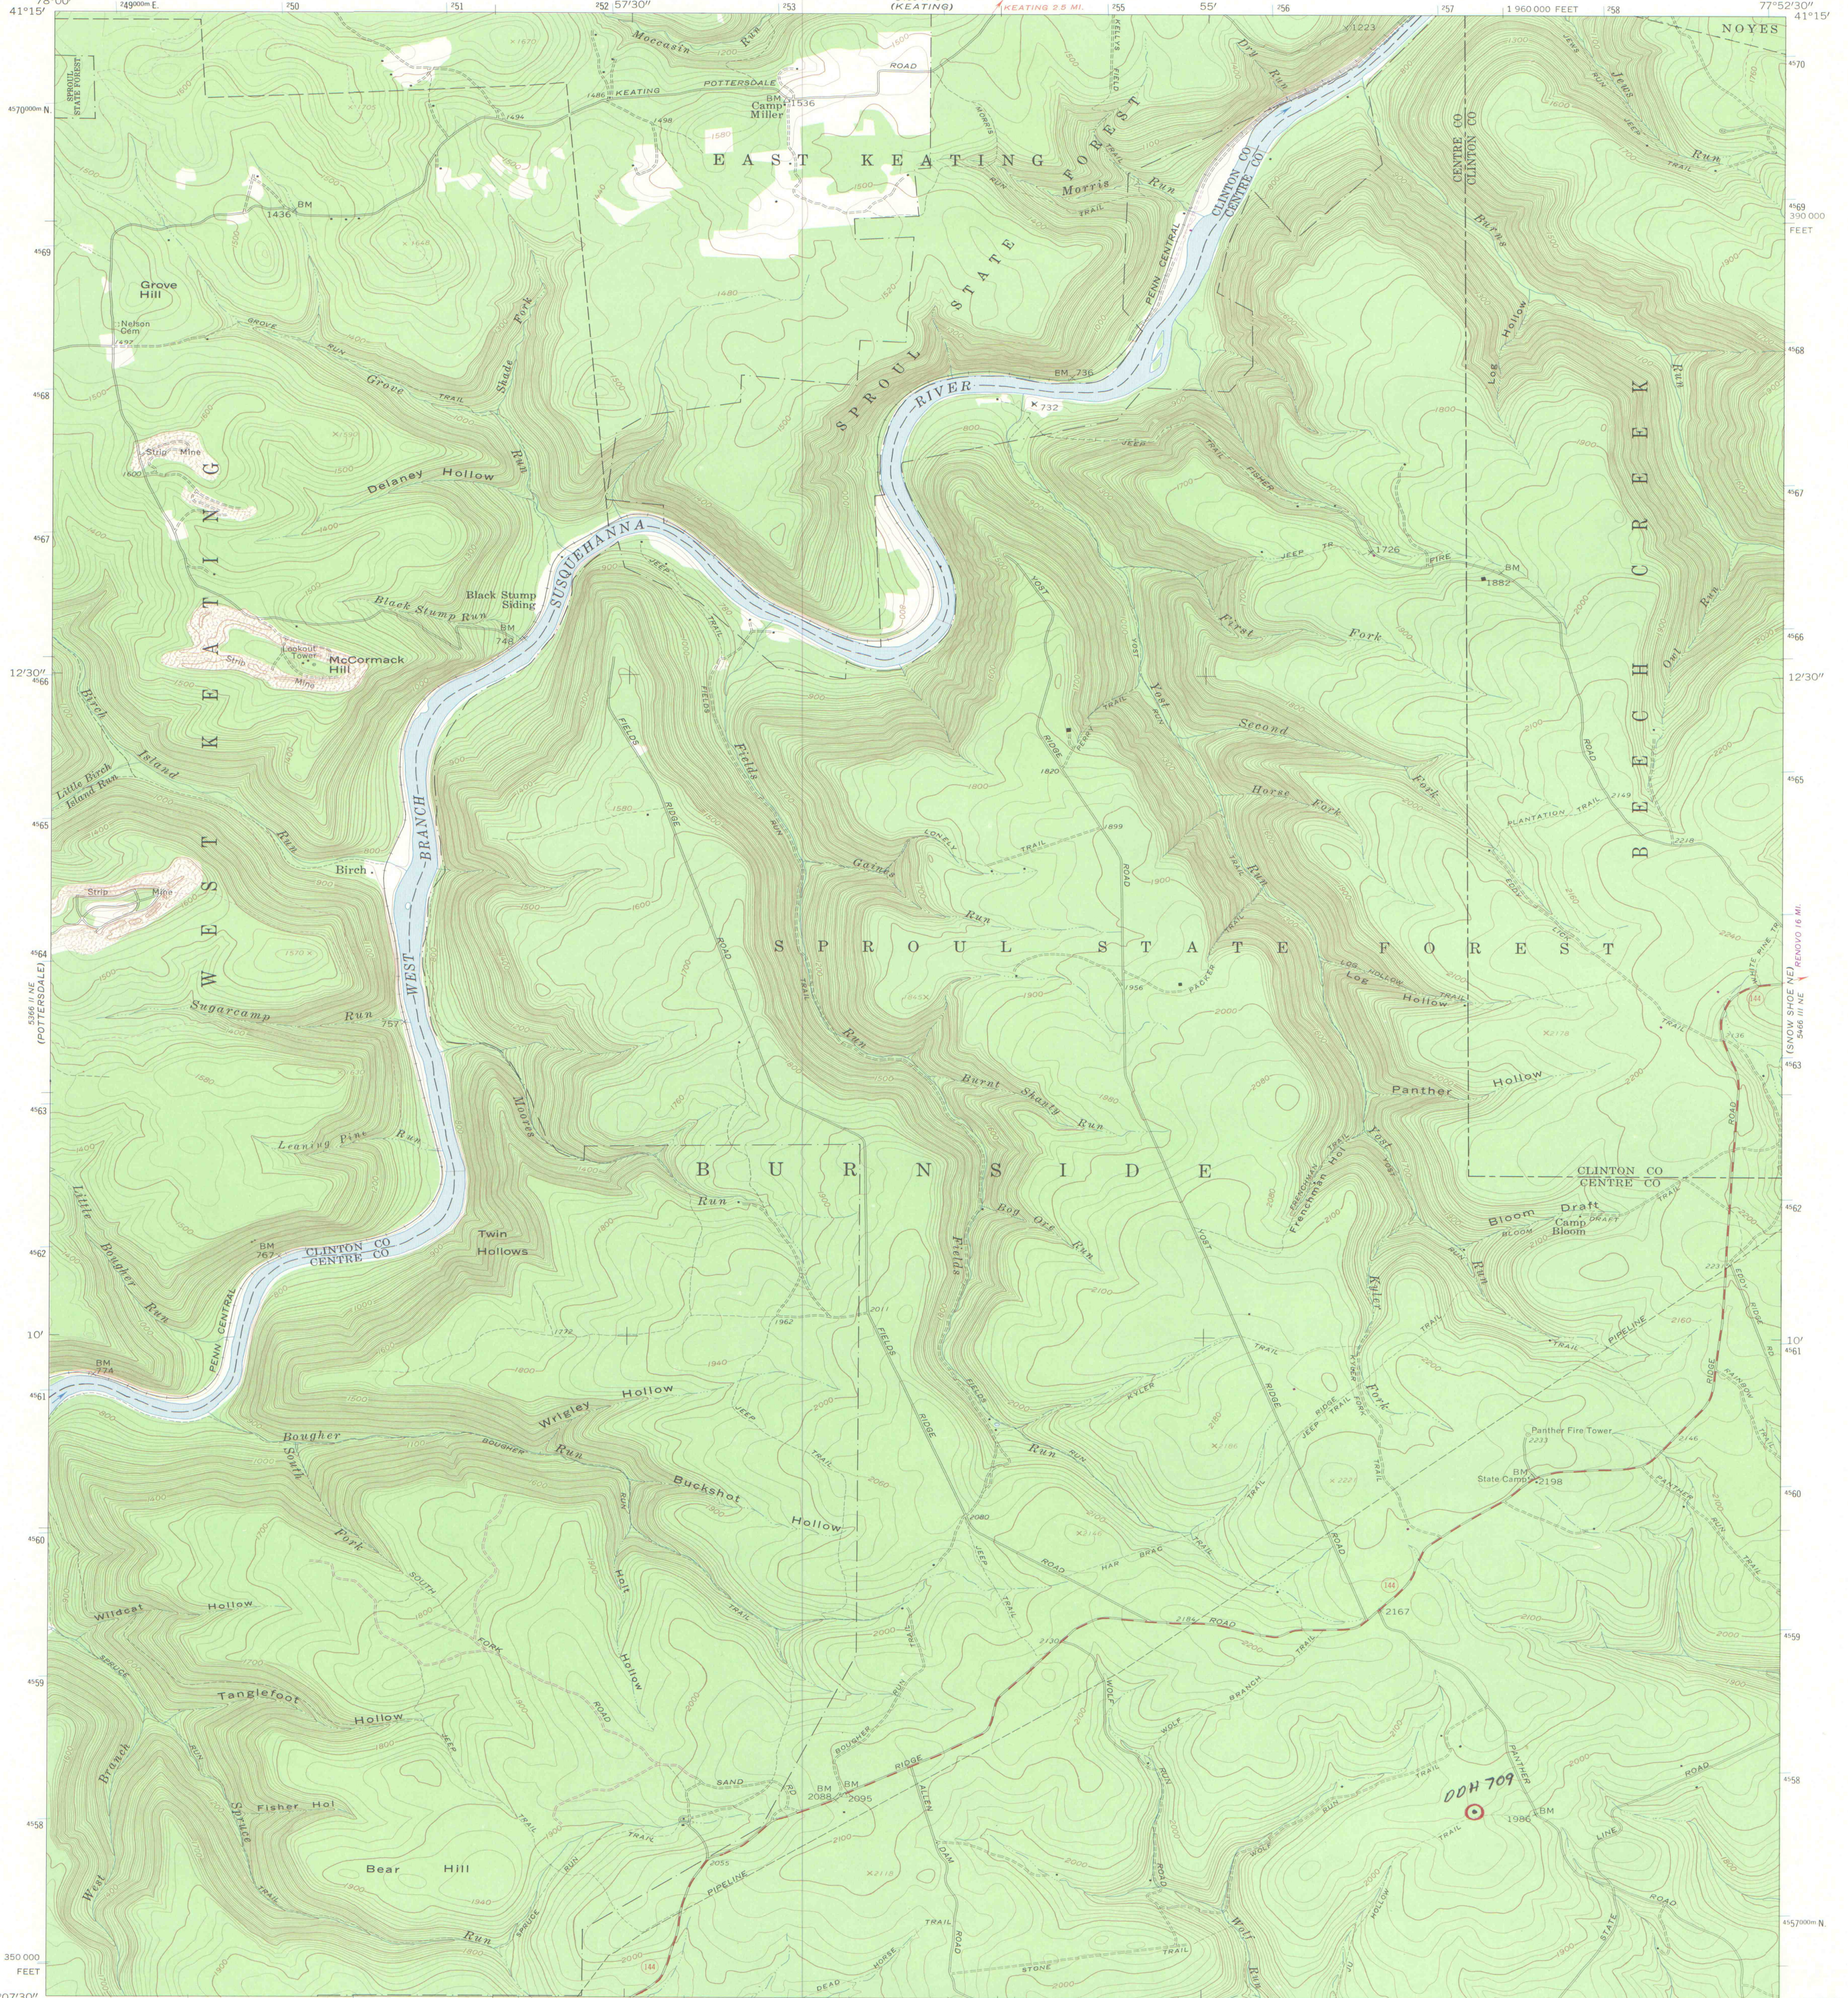

IMAPS # 0384