



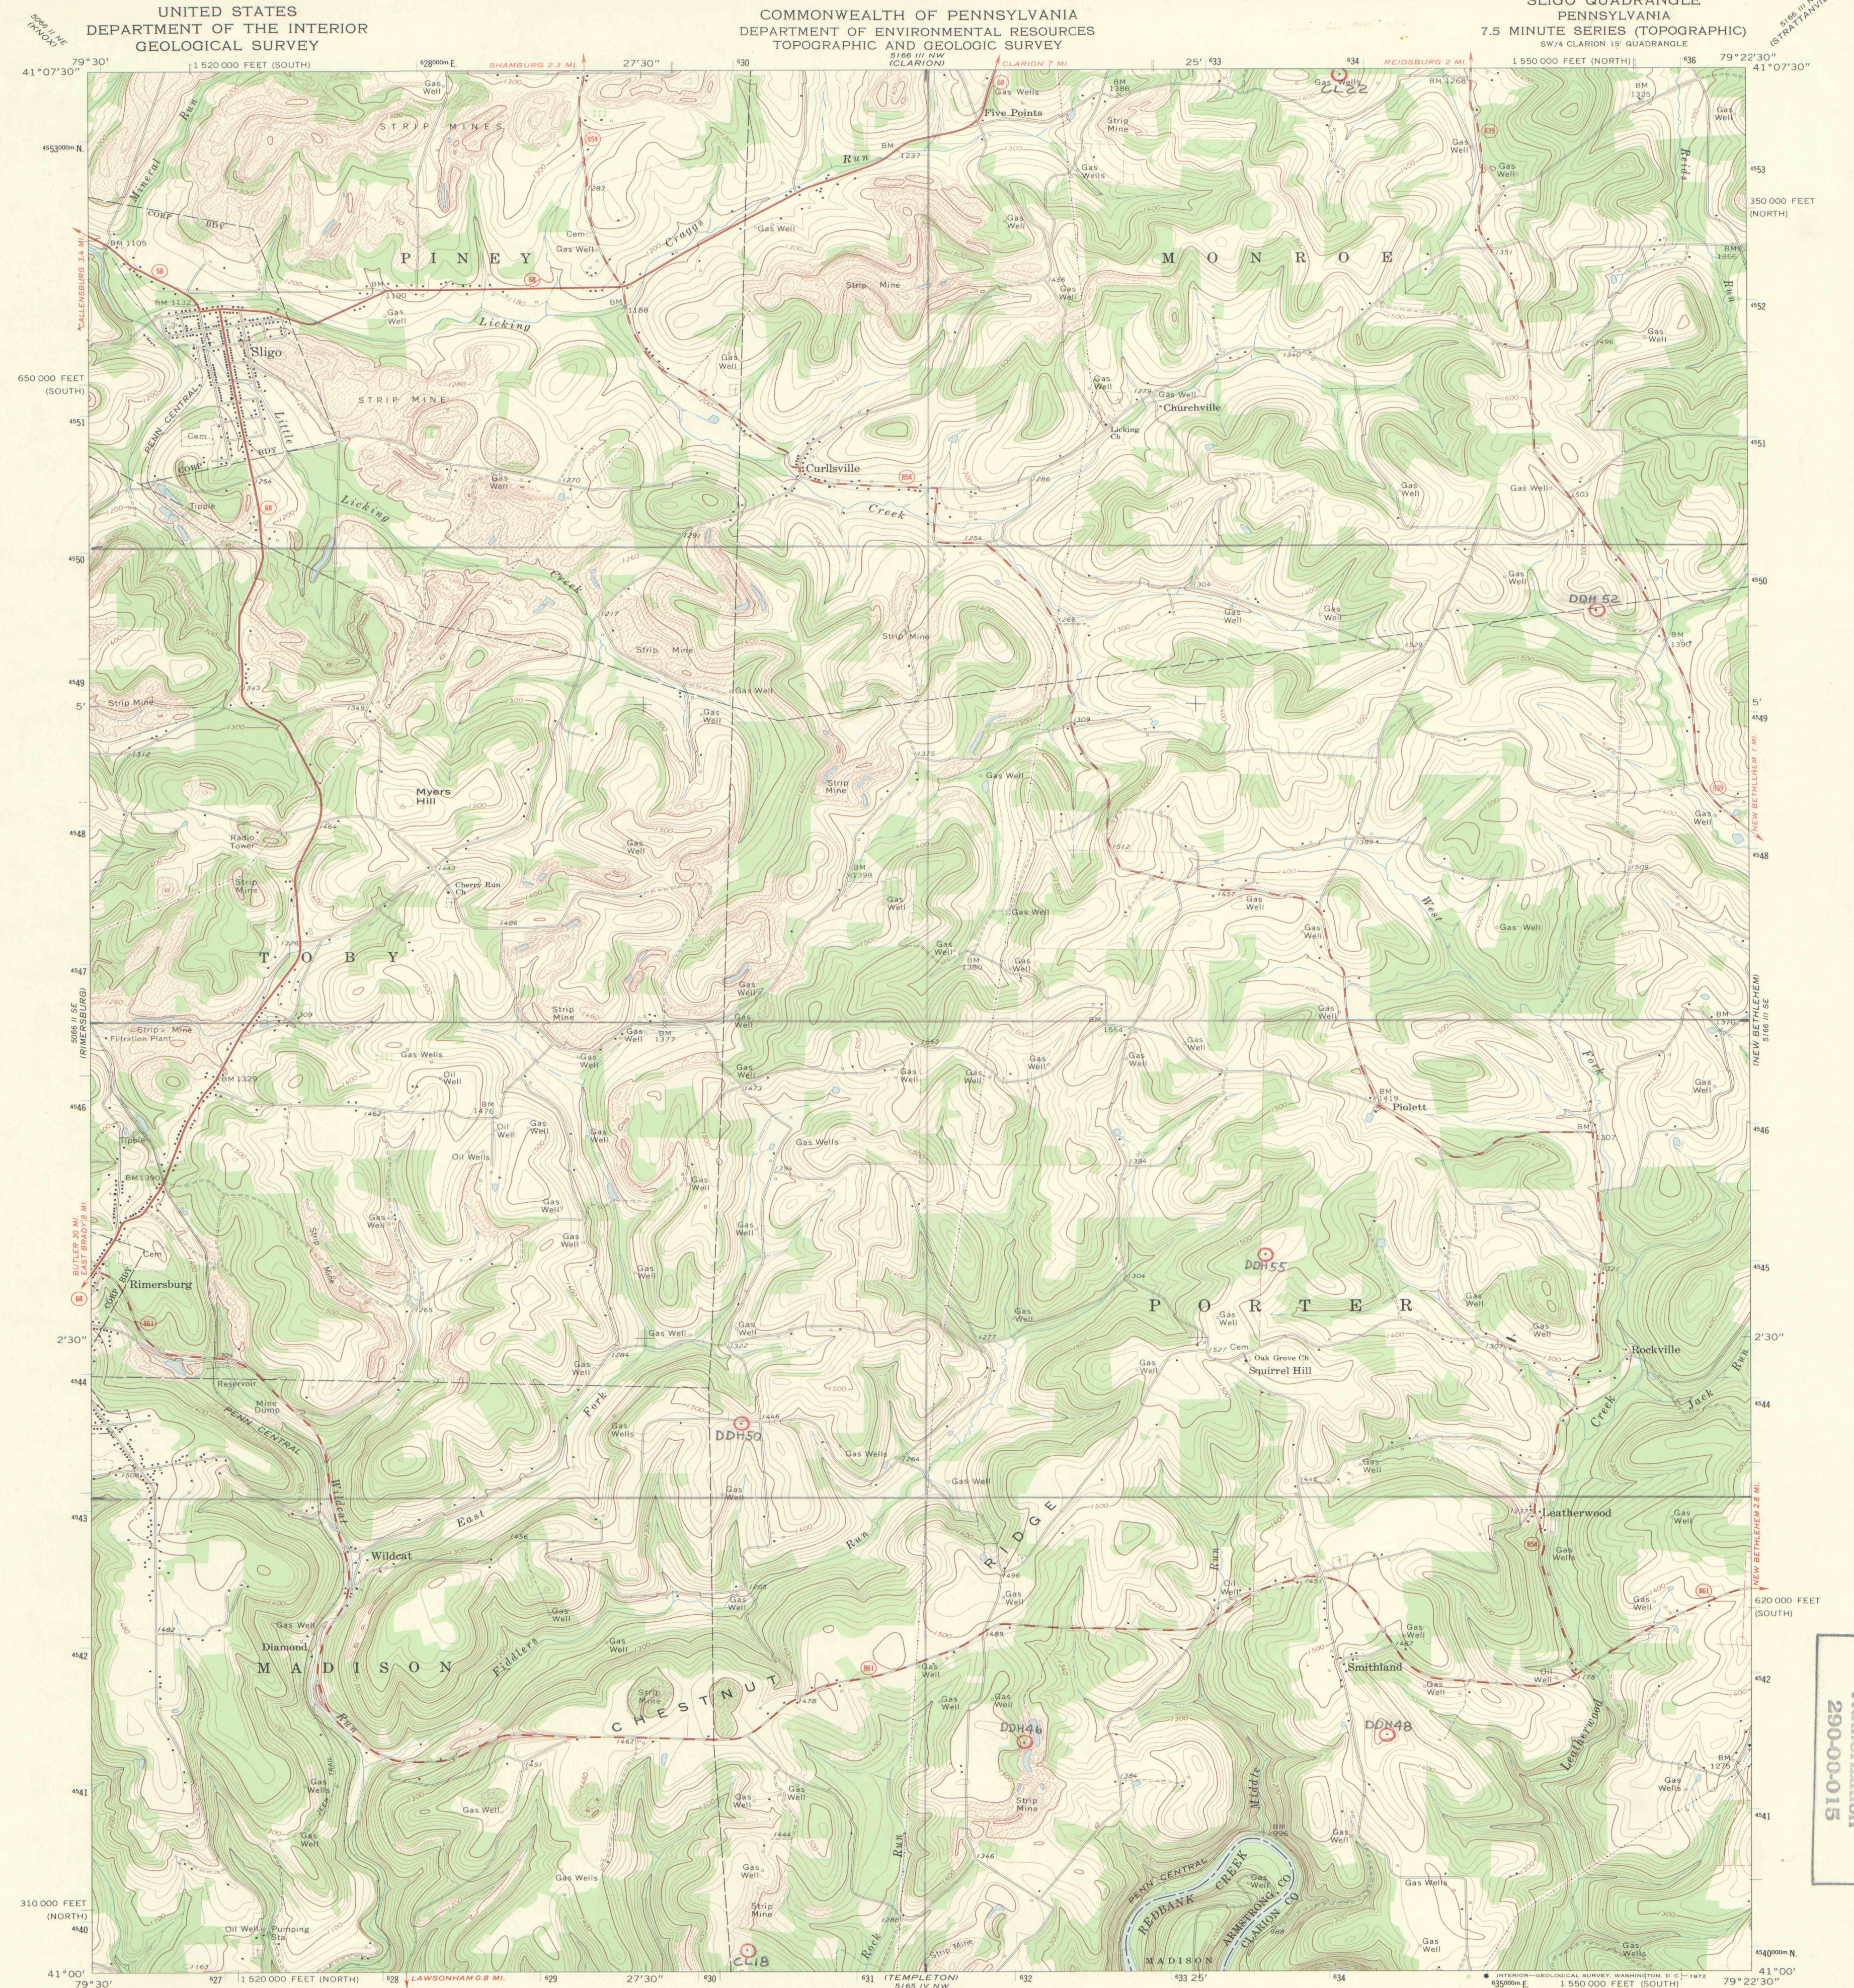

UNITED STATES DEPARTMENT OF THE INTERIOR GEOLOGICAL SURVEY
COMMONWEALTH OF PENNSYLVANIA DEPARTMENT OF ENVIRONMENTAL RESOURCES TOPOGRAPHIC AND GEOLOGIC SURVEY
SLIGO QUADRANGLE PENNSYLVANIA 7.5 MINUTE SERIES (TOPOGRAPHIC) SW/4 CLARION 15' QUADRANGLE

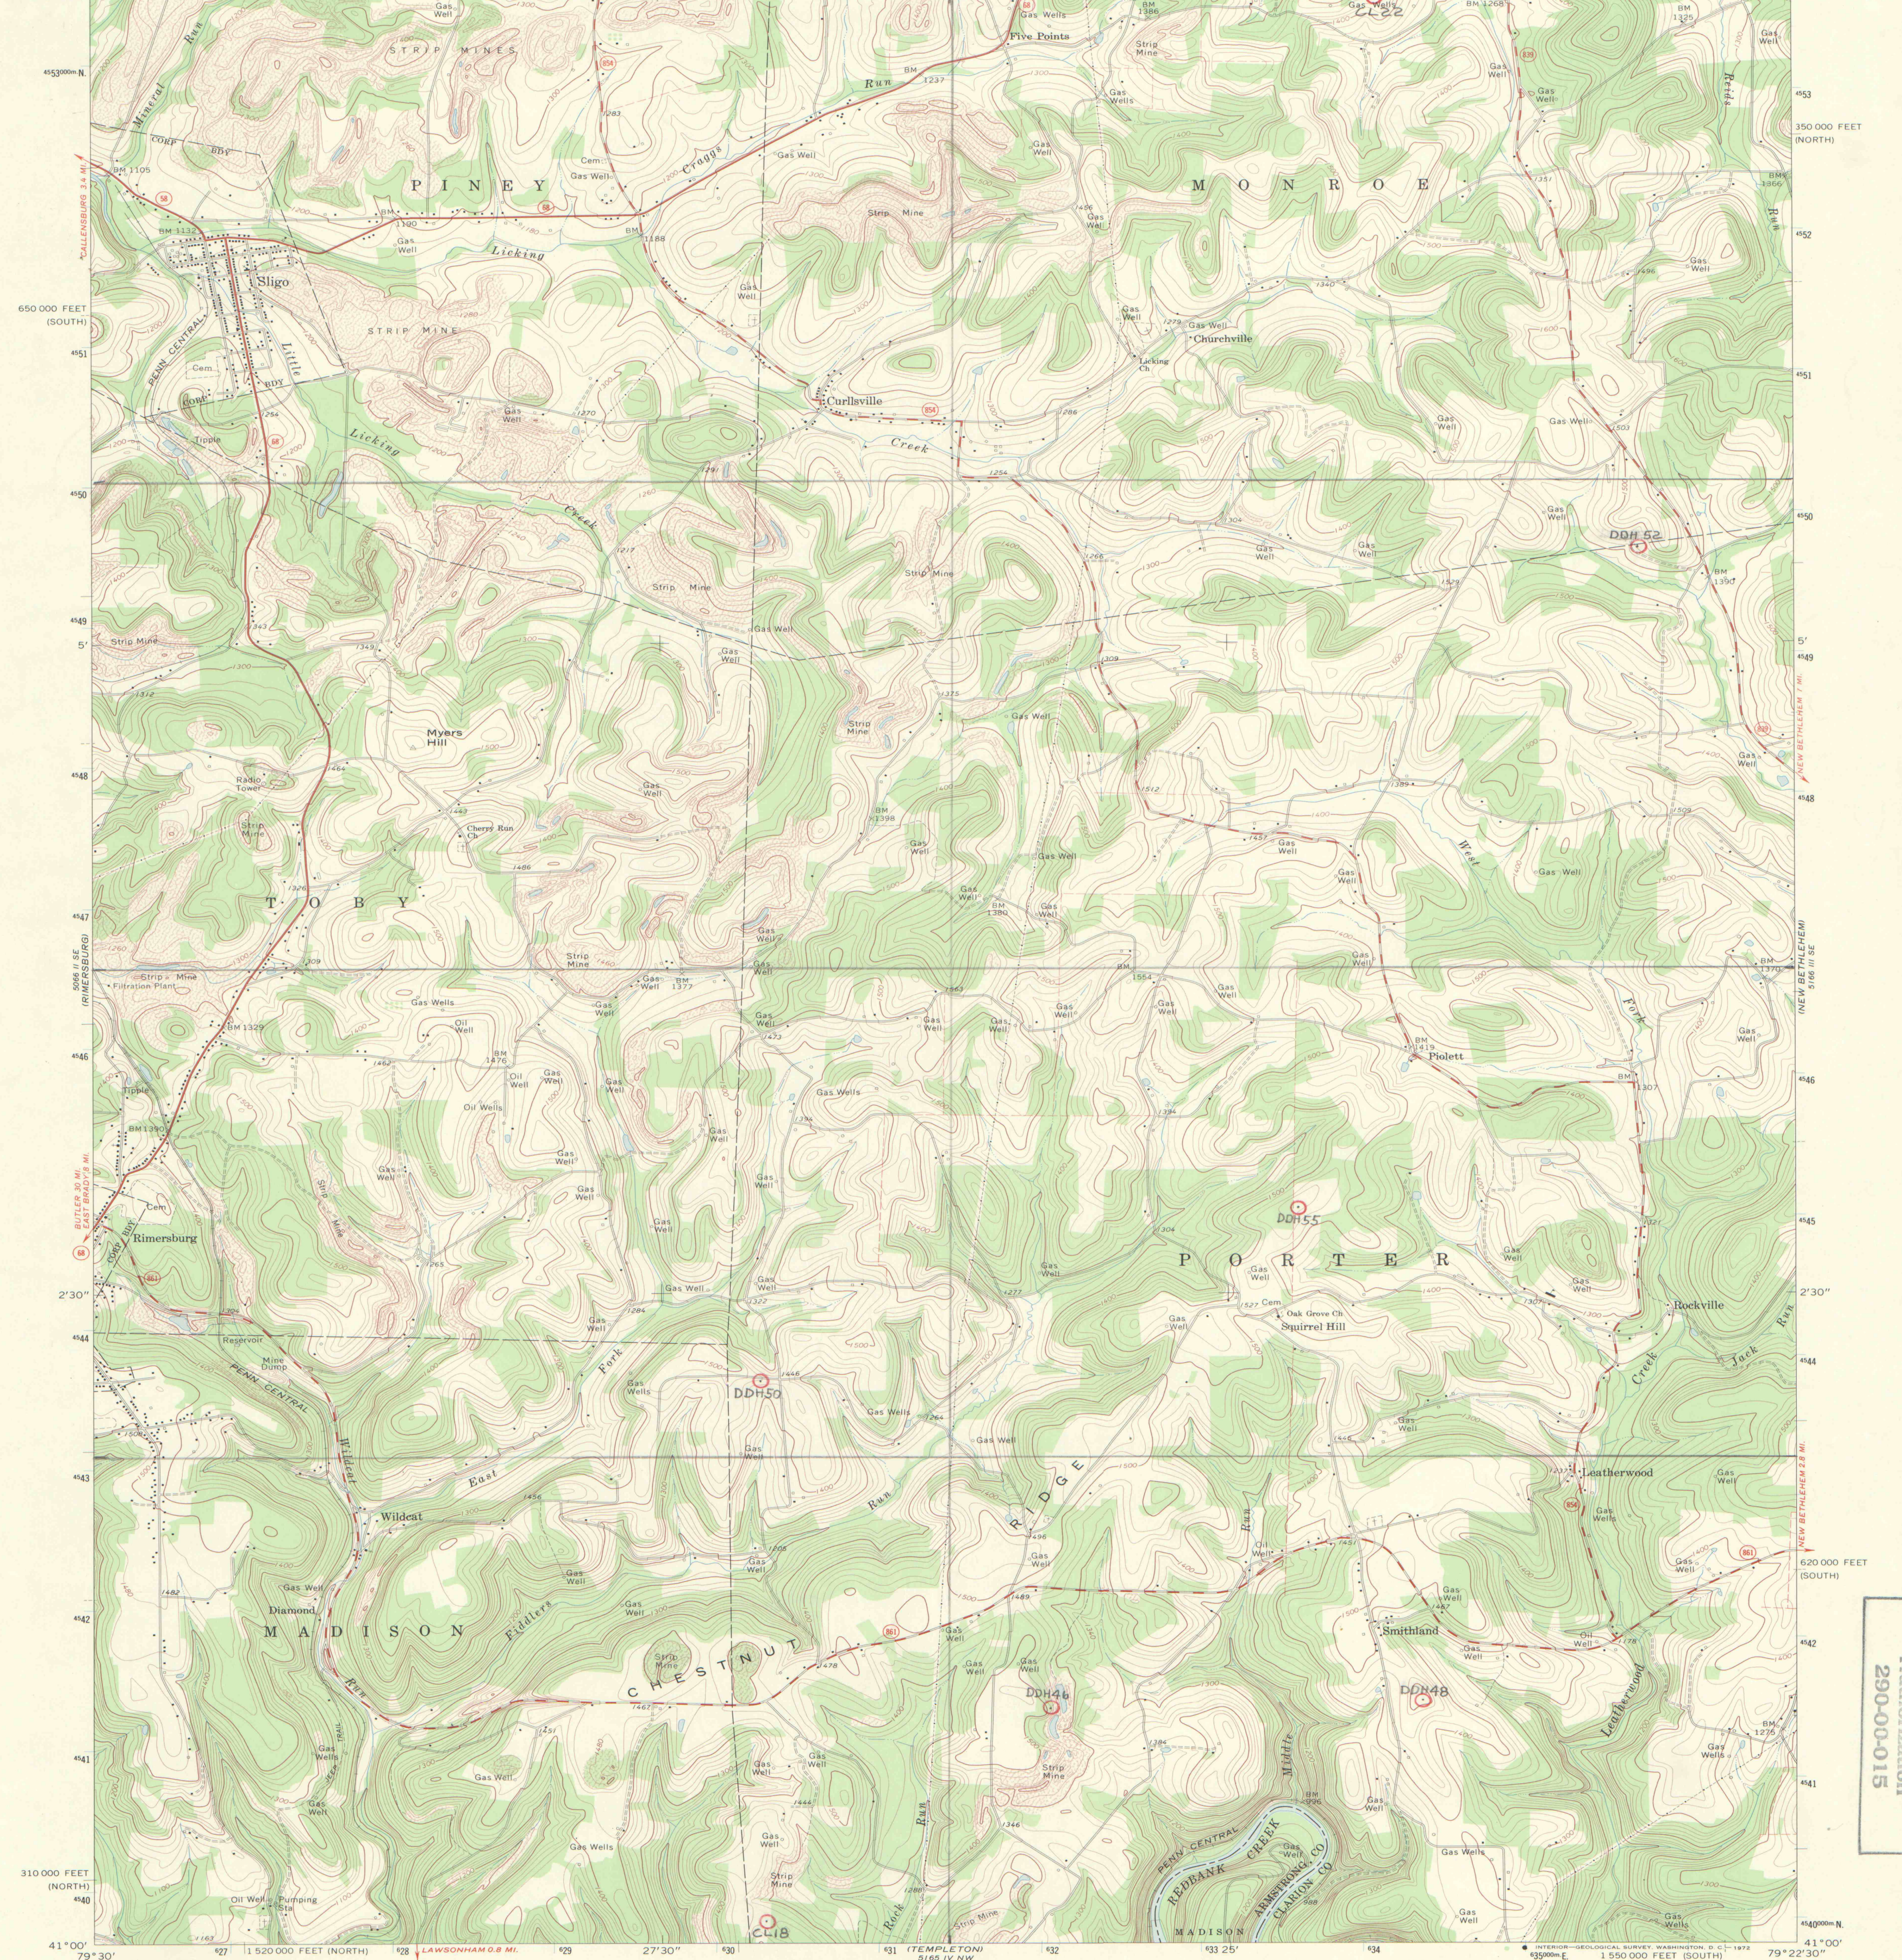

Mapped, edited, and published by the Geological Survey
Control by USGS and USC&GS
Topography by photogrammetric methods from aerial photographs taken 1966. Field checked 1969
Polyconic projection. 1927 North American datum
10,000-foot grids based on Pennsylvania coordinate system, north and south zones
1000-meter Universal Transverse Mercator grid ticks, zone 17, shown in blue
Fine red dashed lines indicate selected fence and field lines where generally visible on aerial photographs. This information is unchecked

UTM GRID AND 1969 MAGNETIC NORTH DECLINATION AT CENTER OF SHEET

DIAMOND DRILL HOLE Location Maps A-02
4-4-C
NOT TO BE TAKEN FROM OFFICE

Primary highway, hard surface
Secondary highway, hard surface
Light-duty road, hard or improved surface
Unimproved road
Interstate Route
U. S. Route
State Route

SLIGO, PA.
SW/4 CLARION 15' QUADRANGLE
N4100-W7922.5/7.5
1969
AMS 5166 III SW-SERIES V831

Exploration Services
Division
Authorization
290-00-015

58C60 #5dVW1