


UNITED STATES
DEPARTMENT OF THE INTERIOR
GEOLOGICAL SURVEY

COMMONWEALTH OF PENNSYLVANIA
DEPARTMENT OF ENVIRONMENTAL RESOURCES
TOPOGRAPHIC AND GEOLOGIC SURVEY

STAHLSTOWN QUADRANGLE
PENNSYLVANIA—WESTMORELAND CO.
7.5 MINUTE SERIES (TOPOGRAPHIC)
NE/4 DONEGAL 15' QUADRANGLE
GREENSBURG 17 MI. 1 580 000 FEET

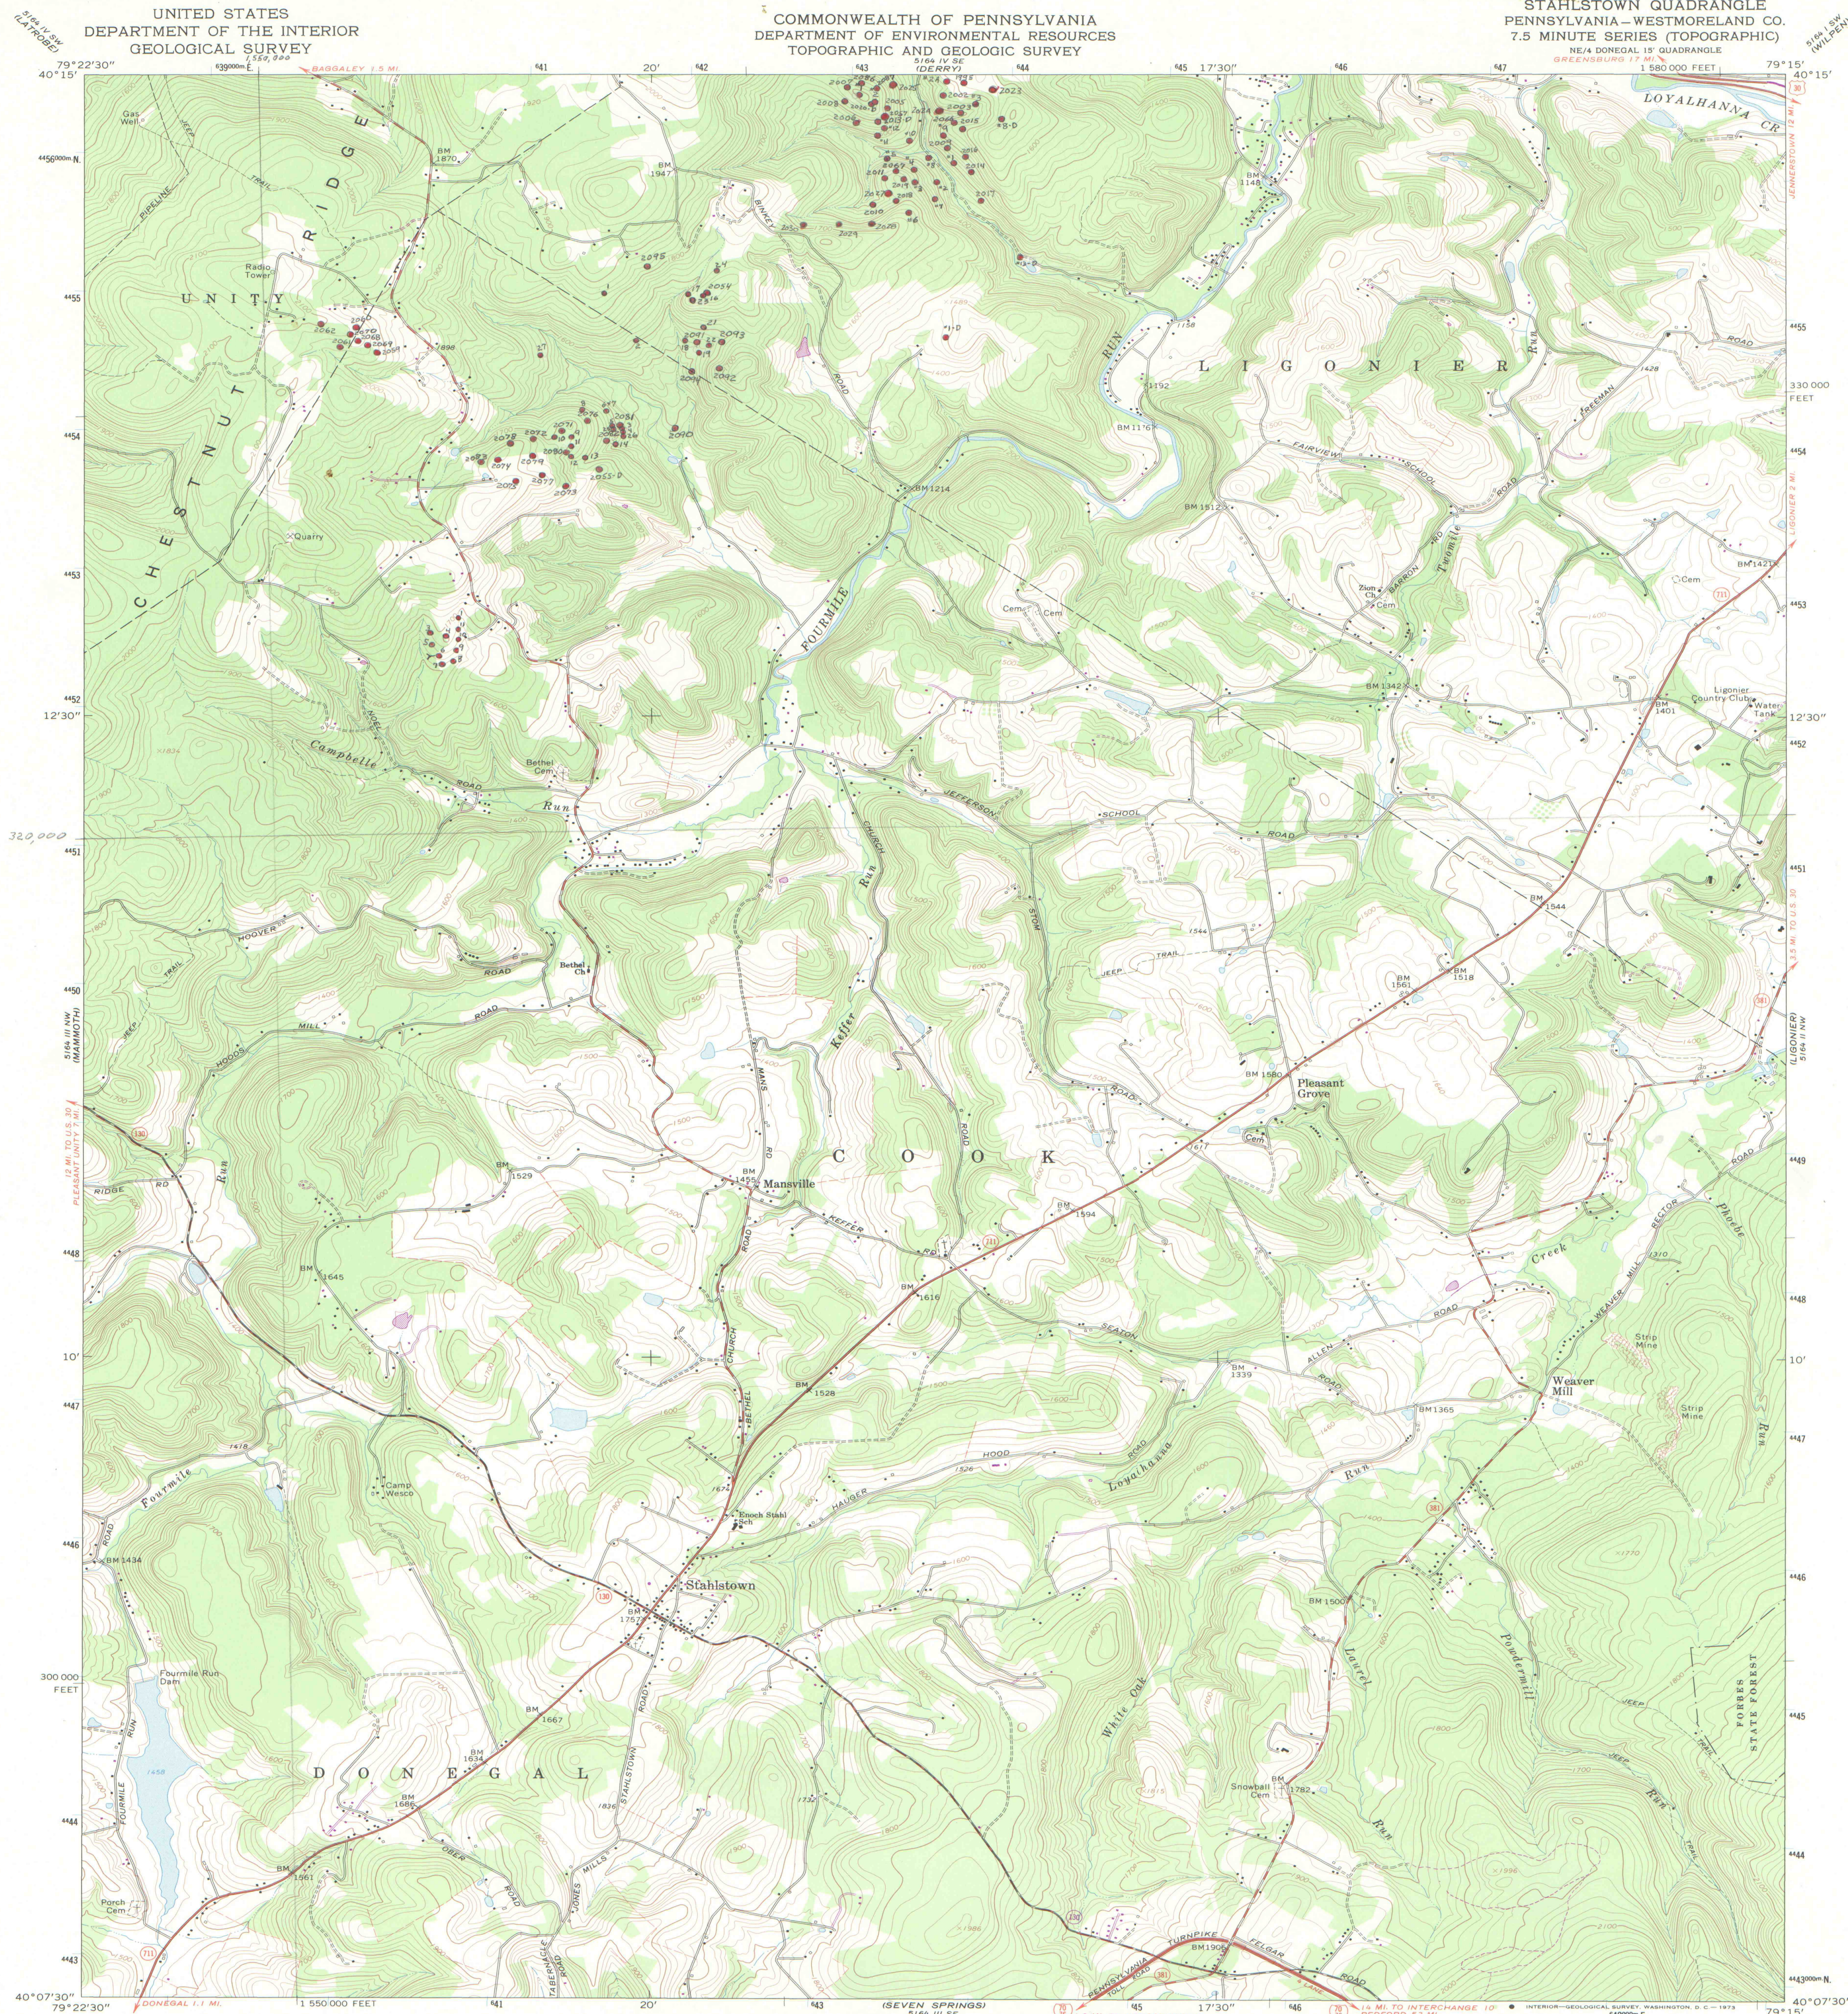

Mapped, edited, and published by the Geological Survey
Control by USGS and USC&GS




Topography by photogrammetric methods from aerial
photographs taken 1967. Field checked 1967

Polyconic projection. 1927 North American datum
10,000-foot grid based on Pennsylvania coordinate system,
south zone

1000-meter Universal Transverse Mercator grid ticks,
zone 17, shown in blue

Fine red dashed lines indicate selected fence and field lines where
generally visible on aerial photographs. This information is unchecked

Revisions shown in purple compiled in cooperation with
State of Pennsylvania agencies from aerial photographs
taken 1973. This information not field checked

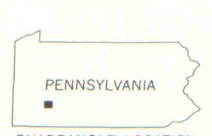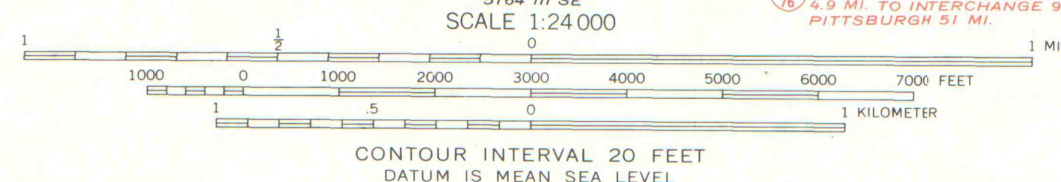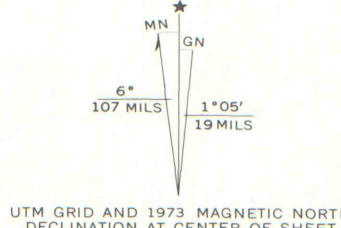

ROAD CLASSIFICATION
Primary highway, all weather, hard surface
Secondary highway, all weather, hard surface
Light-duty road, all weather, improved surface
Unimproved road, fair or dry weather
Interstate Route
U. S. Route
State Route

STAHLSTOWN, PA.
NE/4 DONEGAL 15' QUADRANGLE
N4007.5—W7915/7.5

1967
PHOTOREVISED 1973
AMS 5164 III NE—SERIES V831

IMAPS
#09388