


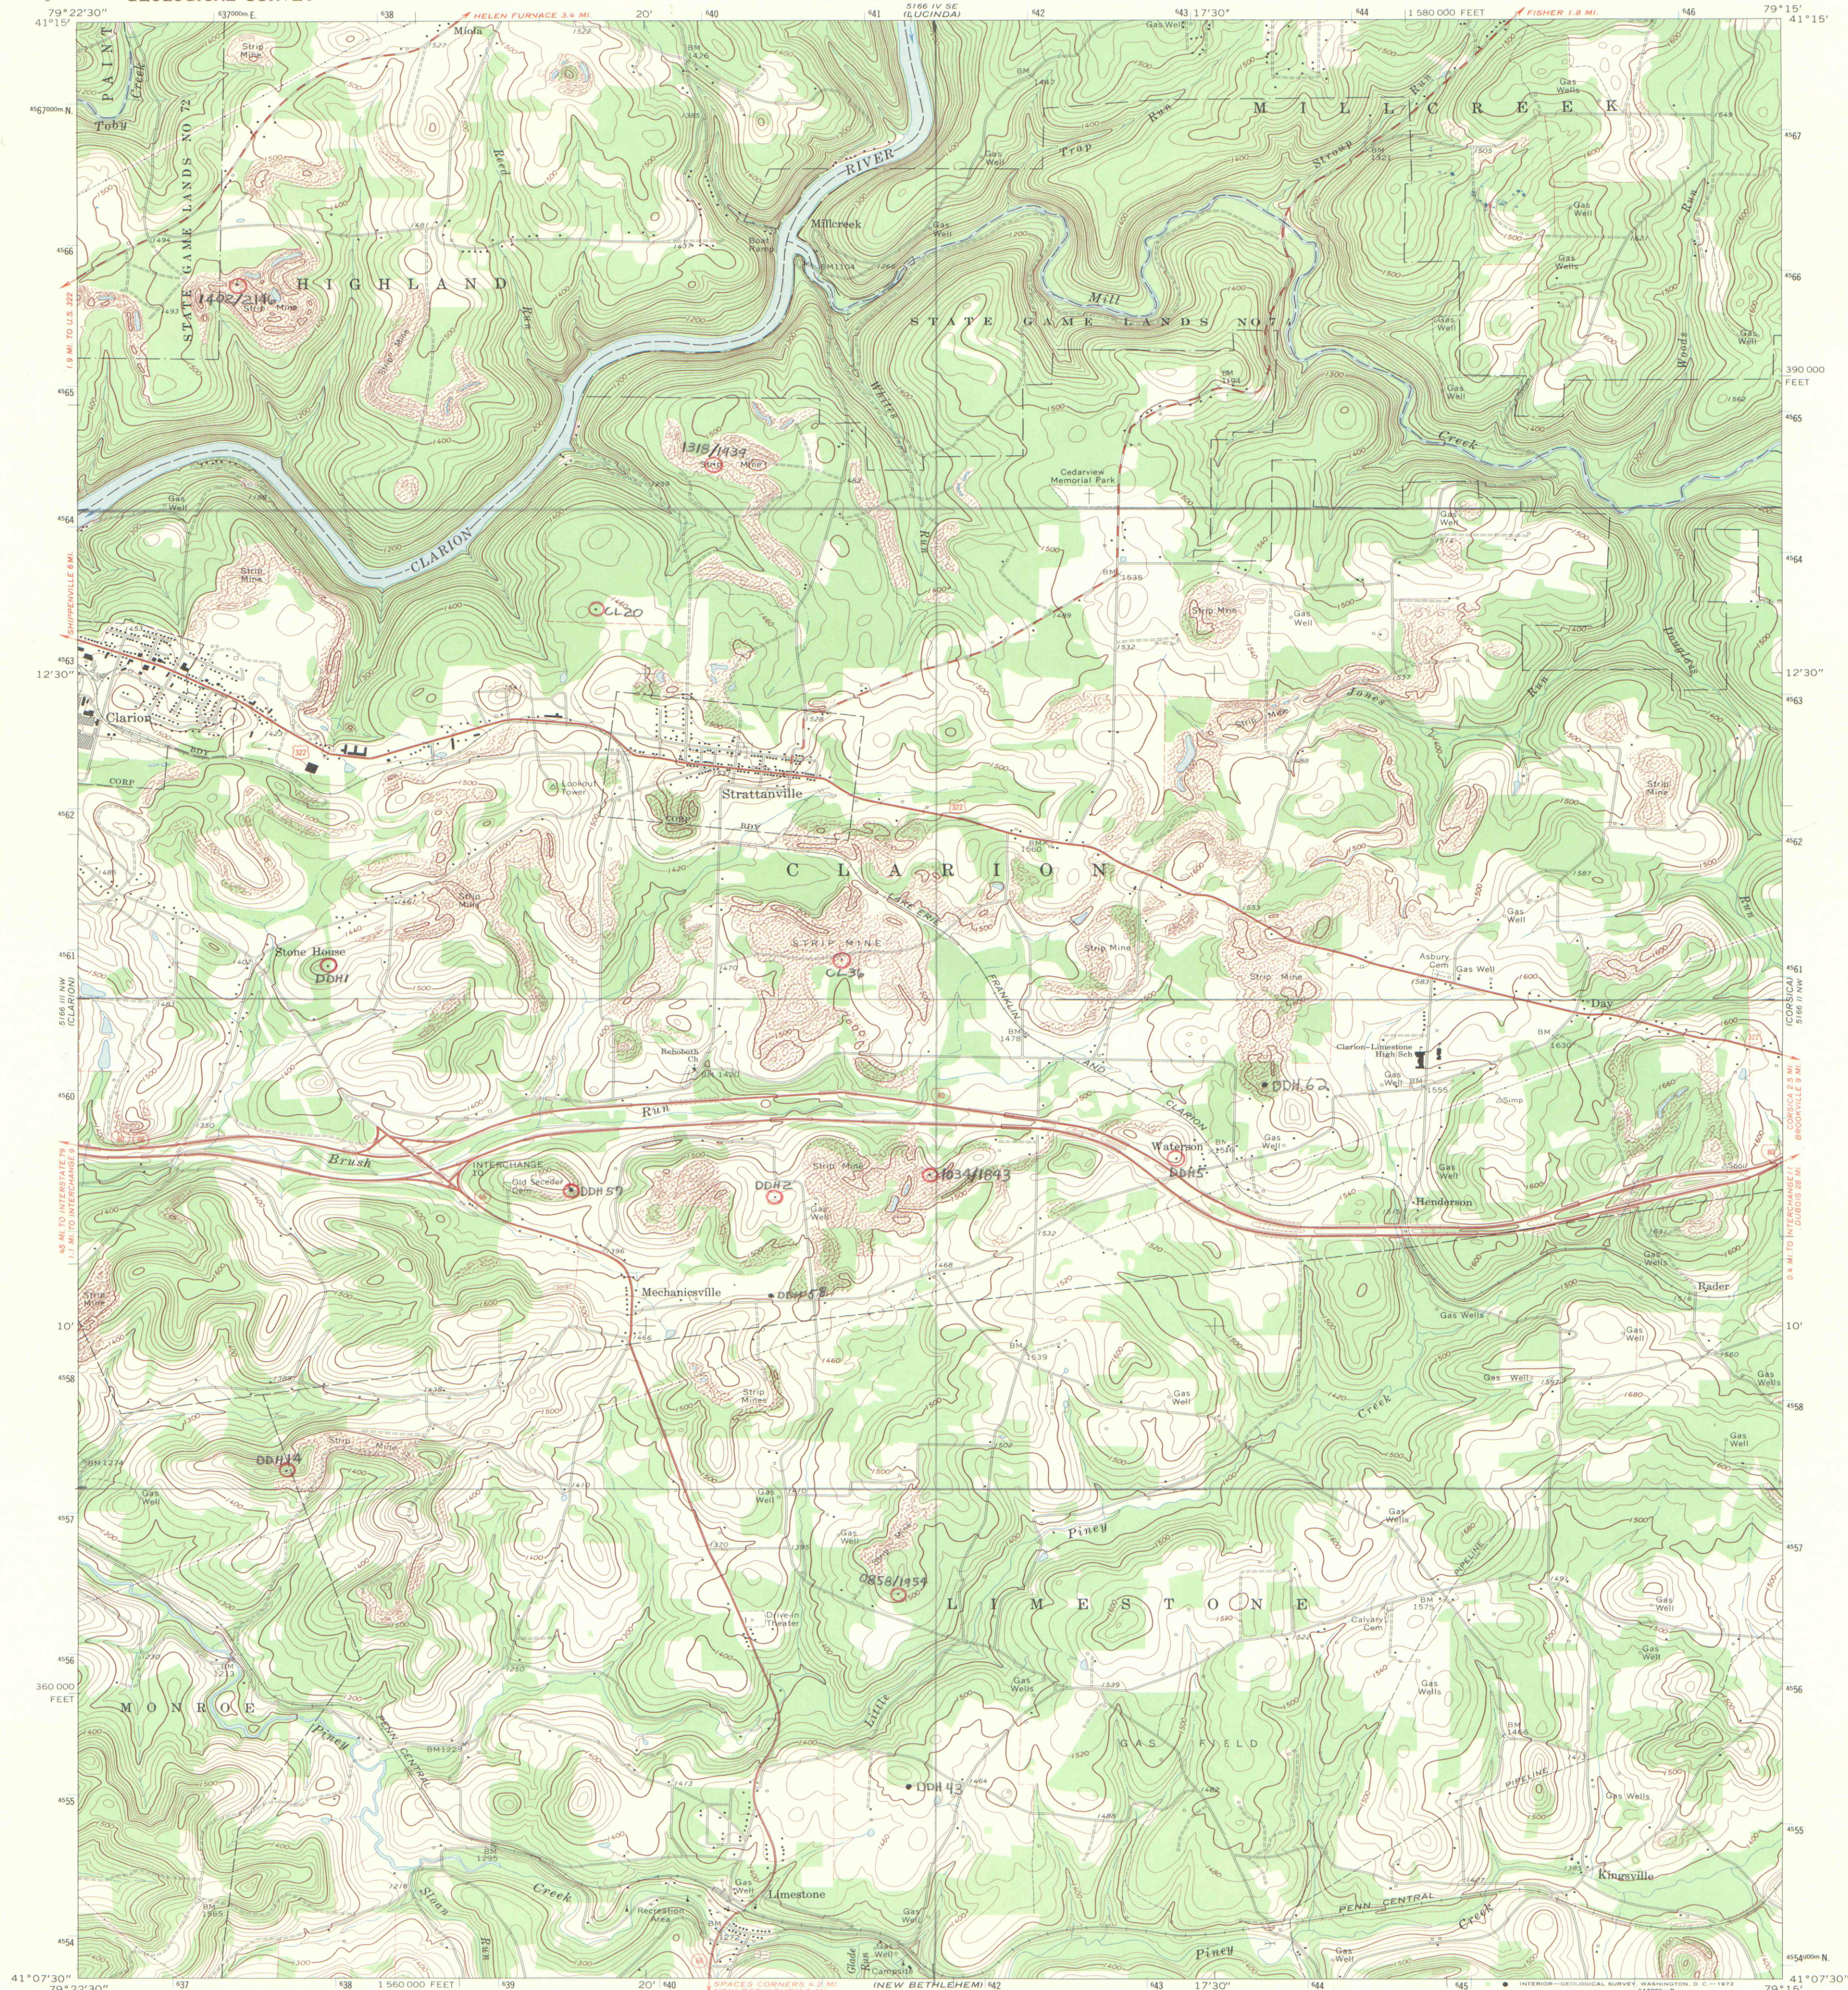


Mapped, edited, and published by the Geological Survey  
Control by USGS and USC&GS  
Topography by photogrammetric methods from aerial  
photographs taken 1967 and 1969. Field checked 1968  
Polyconic projection 1927 North American datum  
10,000-foot grid based on Pennsylvania coordinate system, north zone  
1000-meter Universal Transverse Mercator grid ticks,  
zone 17, shown in blue  
Fine red dashed lines indicate selected fence and field lines where  
generally visible on aerial photographs. This information is unchecked

UTM GRID AND 1968 MAGNETIC NORTH  
DECLINATION AT CENTER OF SHEET

SCALE 1:24,000  
1 0 1000 2000 3000 4000 5000 6000 7000 FEET  
1 MILE

DIAMOND DRILL HOLE  
Location Maps  
A-02  
4-4-B

NOT TO BE TAKEN FROM OFFICE

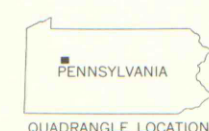

ROAD CLASSIFICATION  
Primary highway, hard surface  
Secondary highway, hard surface  
Unimproved road  
Light-duty road, hard or improved surface  
Interstate Route  
U. S. Route  
State Route

STRATTANVILLE, PA.  
NE/4 CLARION 15' QUADRANGLE  
N4107.5—W7915.7.5

1968

AMS 5166 III NE—SERIES V831

IMARS  
#09389