


UNITED STATES
DEPARTMENT OF THE INTERIOR
GEOLOGICAL SURVEY


COMMONWEALTH OF PENNSYLVANIA
DEPARTMENT OF ENVIRONMENTAL RESOURCES
TOPOGRAPHIC AND GEOLOGIC SURVEY

SUMMERVILLE QUADRANGLE
PENNSYLVANIA
7.5 MINUTE SERIES (TOPOGRAPHIC)
SW/4 BROOKVILLE 15' QUADRANGLE

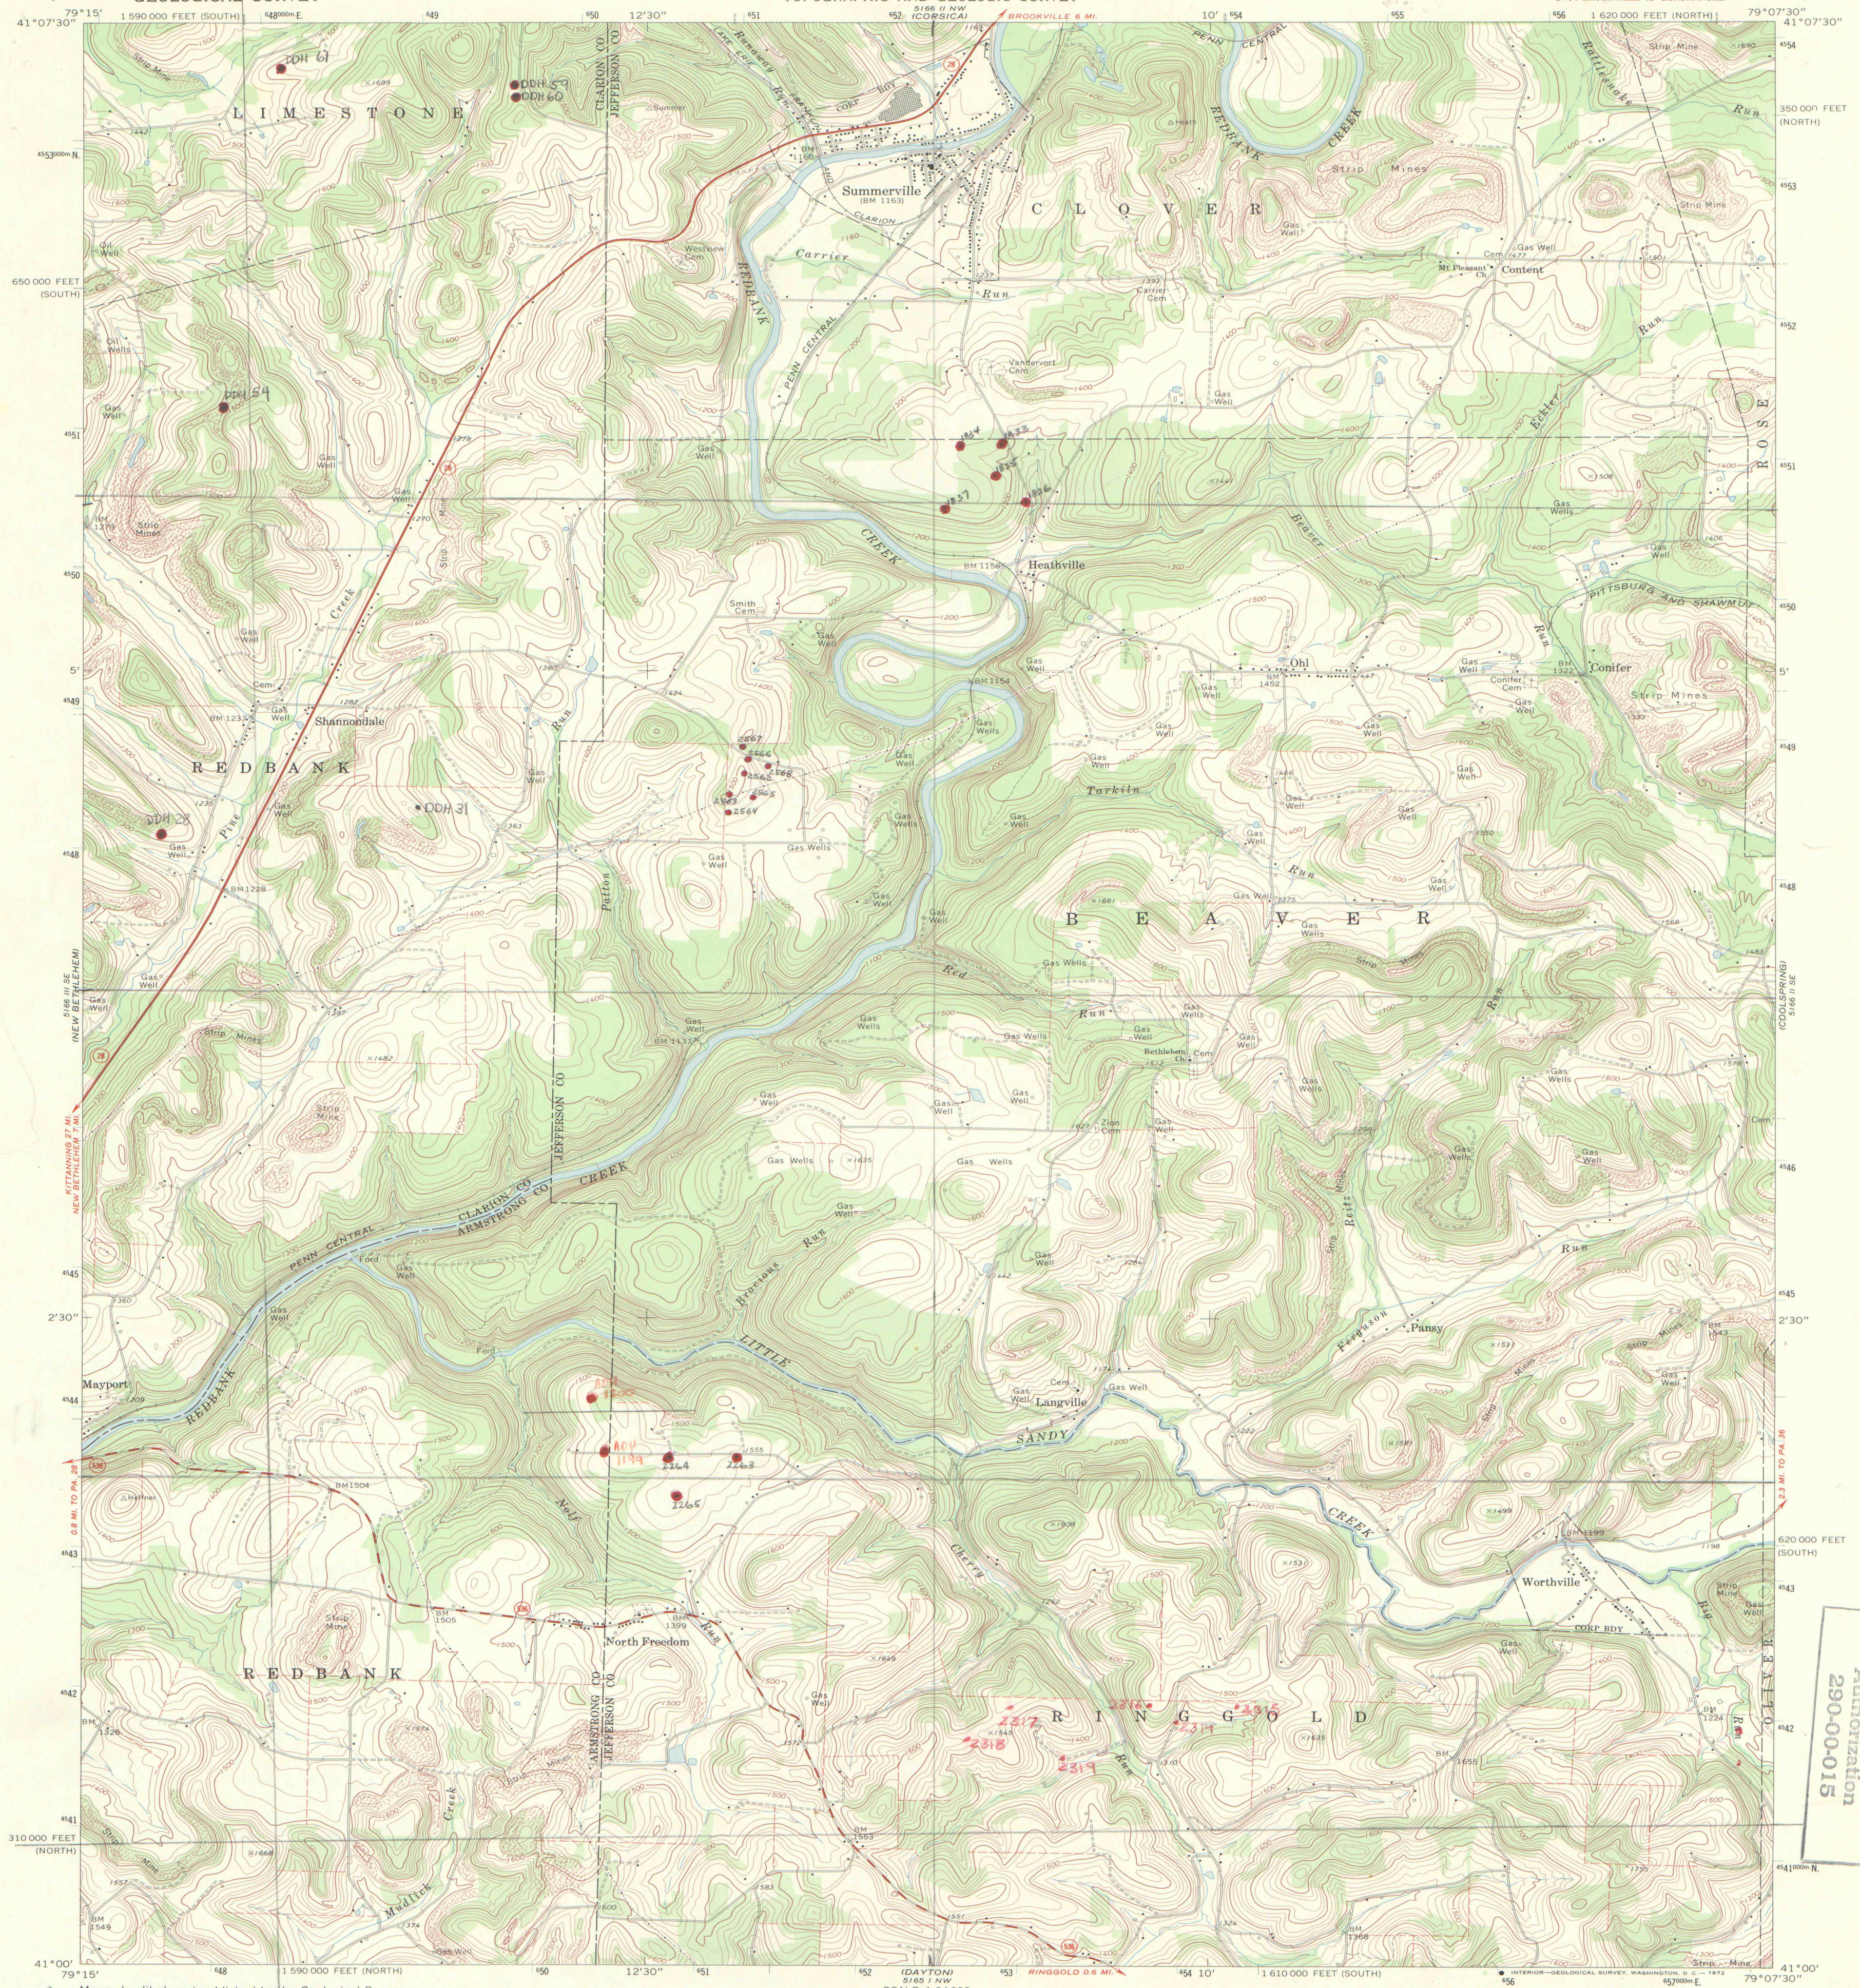

Exploration Services
Division
Authorization
290-00-015

Mapped, edited, and published by the Geological Survey
Control by USGS and USC&GS
Topography by photogrammetric methods from aerial
photographs taken 1967. Field checked 1969
Polyconic projection. 1927 North American datum
10,000-foot grids based on Pennsylvania coordinate system,
north and south zones
1000-meter Universal Transverse Mercator grid ticks,
zone 17, shown in blue
Fine red dashed lines indicate selected fence and field lines where
generally visible on aerial photographs. This information is unchecked

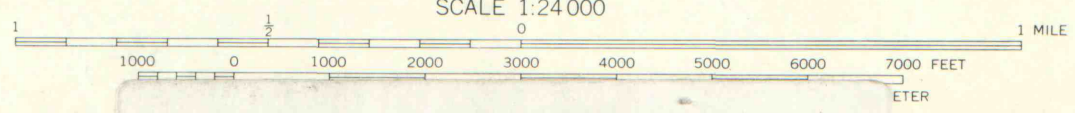

DIAMOND DRILL HOLE
Location Maps
A-02

5-4-C

ROAD CLASSIFICATION
Primary highway, hard surface
Secondary highway, hard surface
Unimproved road
Interstate Route
U. S. Route
State Route

SUMMERVILLE, PA.
SW/4 BROOKVILLE 15' QUADRANGLE
N4100-W7907.5/7.5

1969
AMS 5166 II SW-SERIES V831

IMAPS
#09390