



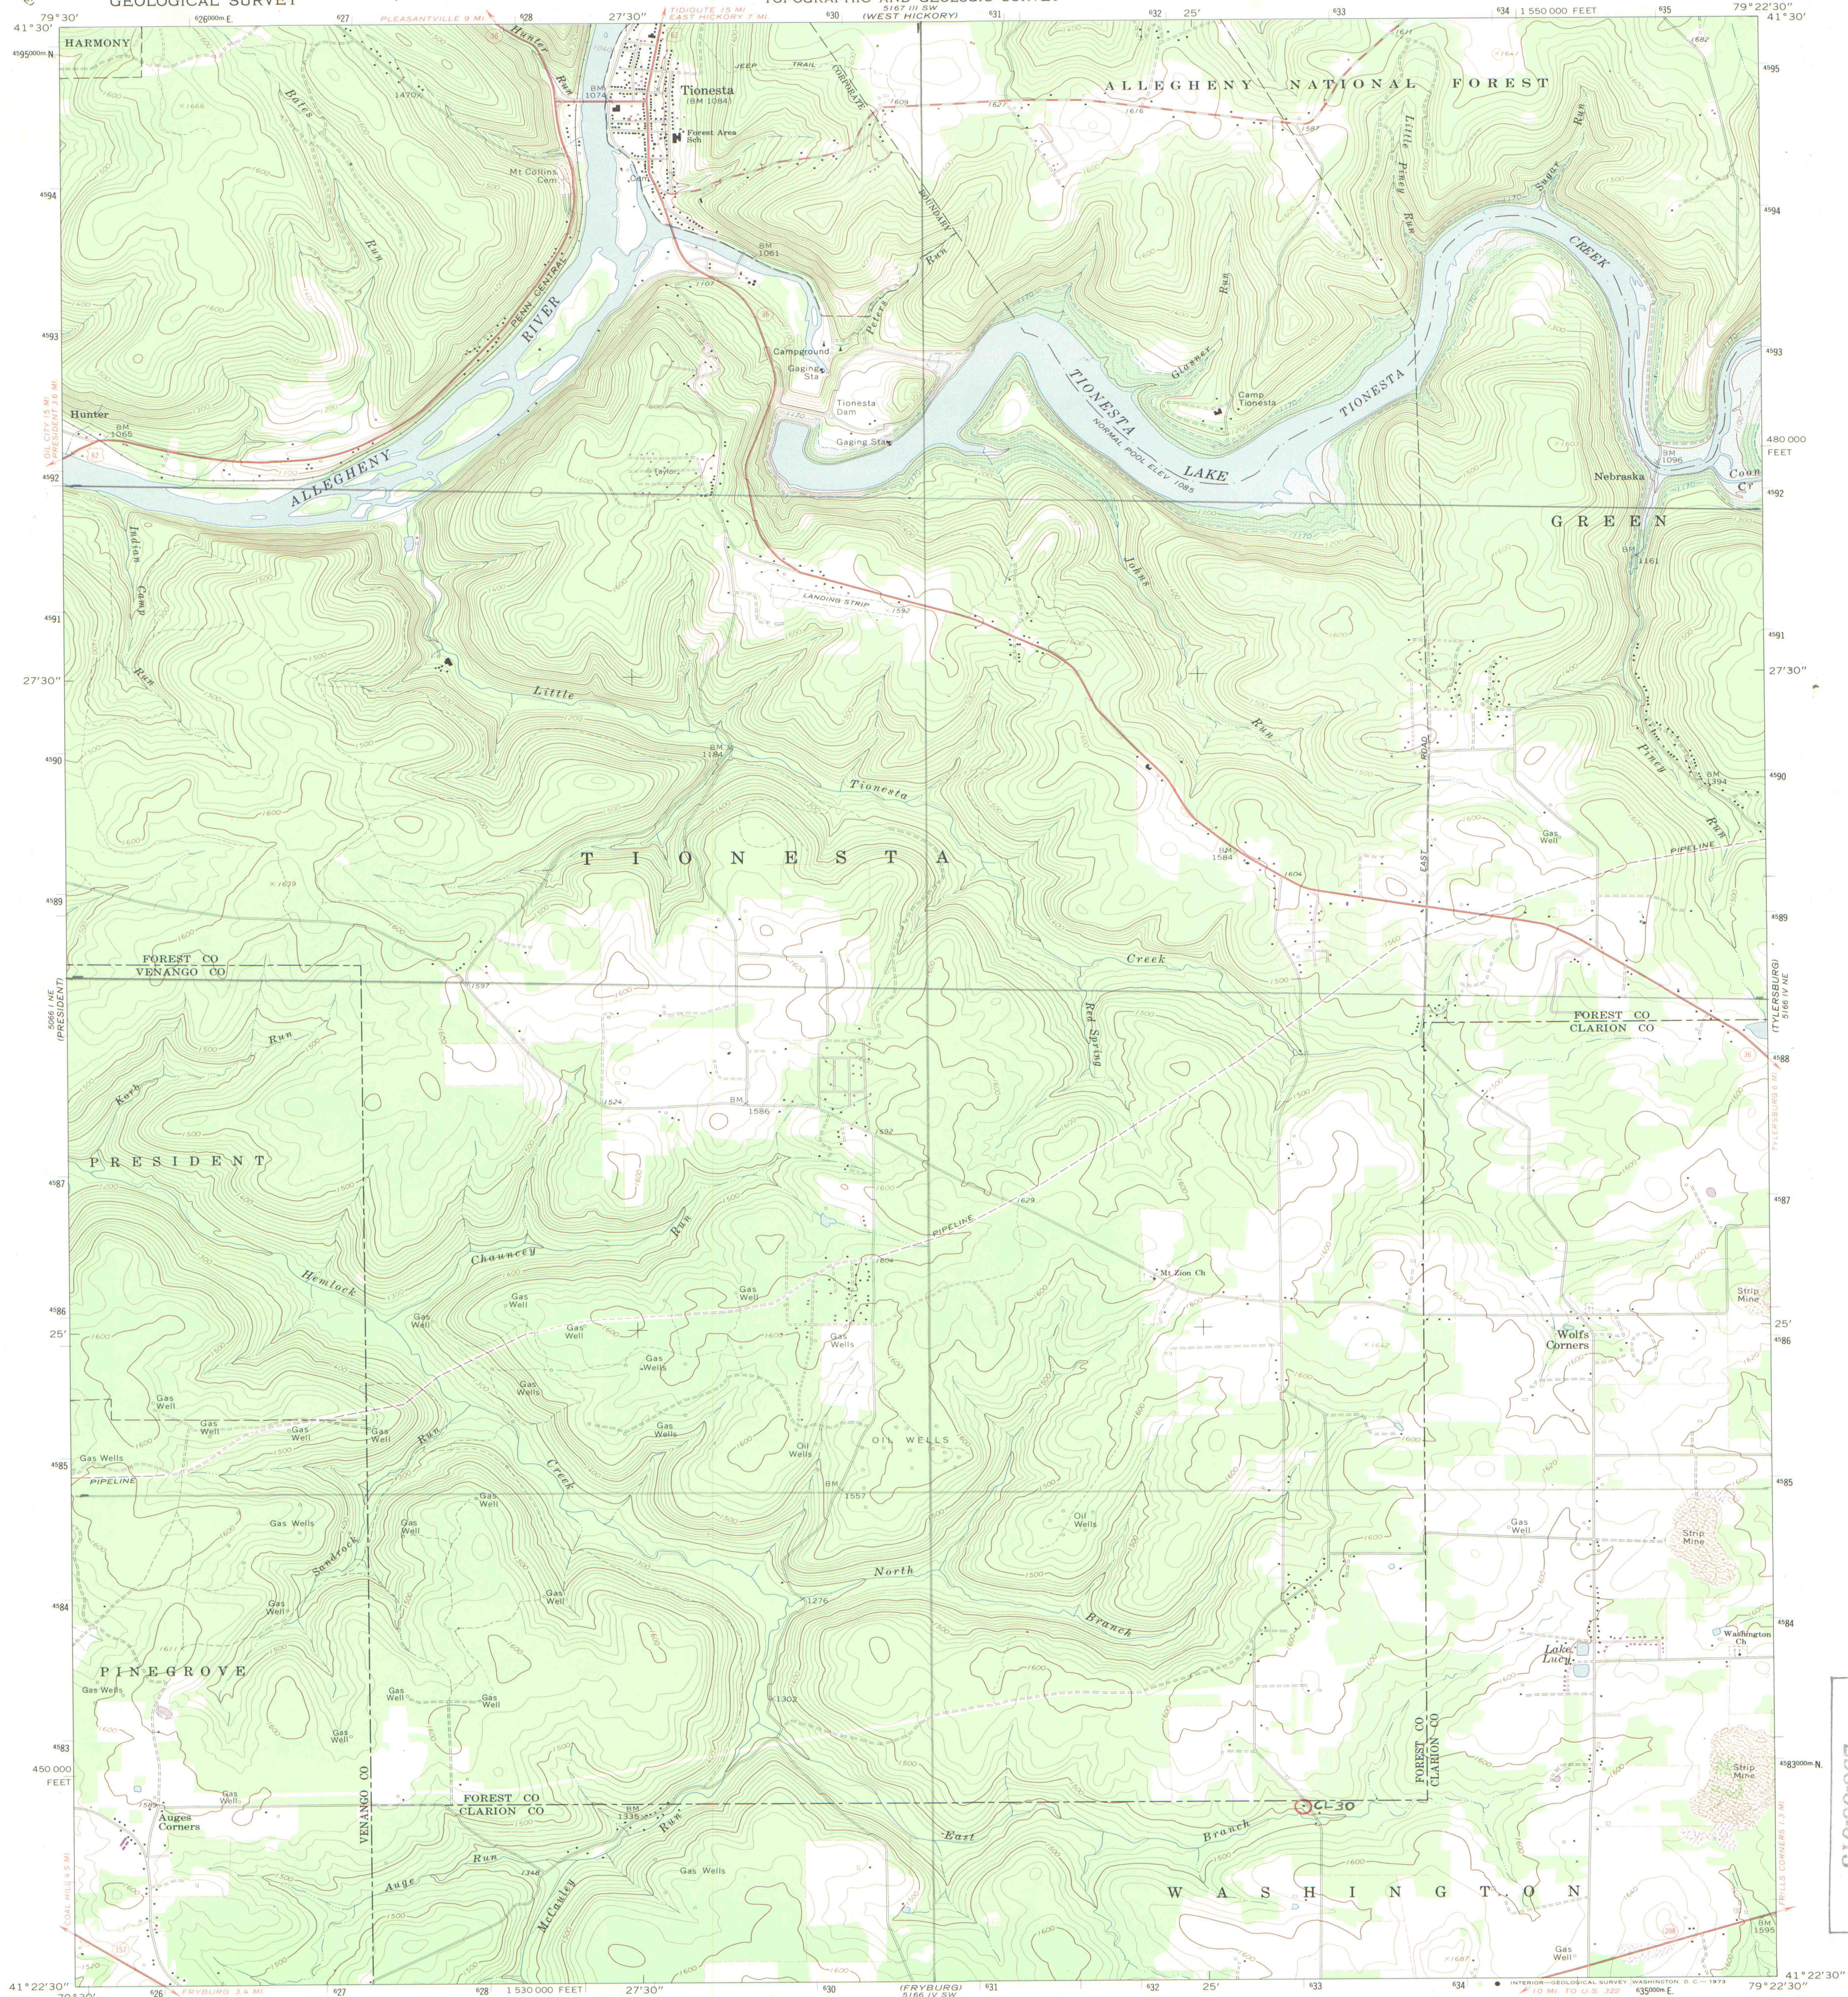


Mapped, edited, and published by the Geological Survey
Control by USGS and USC&GS
Topography by photogrammetric methods from aerial photographs
taken 1967 and 1968. Field checked 1967
Polyconic projection. 1927 North American datum
10,000-foot grid based on Pennsylvania coordinate system,
north zone
1000-meter Universal Transverse Mercator grid ticks,
zone 17, shown in blue
Fine red dashed lines indicate selected fence and field lines where
generally visible on aerial photographs. This information is unchecked
Area covered by dashed light-blue pattern is subject to
controlled inundation

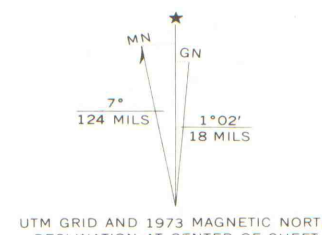

DIAMOND DRILL HOLE
Location Maps
A-02

4-3-A

NOT TO BE TAKEN FROM OFFICE

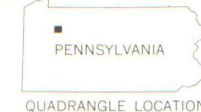

Revisions shown in purple compiled in cooperation with
State of Pennsylvania agencies from aerial photographs
taken 1973. This information not field checked

ROAD CLASSIFICATION
Primary highway, all weather, hard surface
Secondary highway, all weather, hard surface
Light-duty road, all weather, improved surface
Unimproved road, fair or dry weather
U. S. Route
State Route

TIONESTA, PA.
NW/4 TIONESTA 15' QUADRANGLE
N4122.5—W7922.5/7.5

1967
PHOTOREVISED 1973
AMS 5166 IV NW—SERIES V831

16360 #S4WI
Exploration Services
Division
Authorization
290-00-015